



# Design Support Report for Programmatic Section 4(f) Alternatives Analysis

## U.S. Highway 60 Bridge Over Horse Creek

Afton, Ottawa County

Job Piece No.: 31715(05)

NBI Bridge No.: 05017

Structure No.: 5806 0256 X

Prepared for

**Federal Highway Administration**

and

**Oklahoma Department of  
Transportation**

Prepared by

**Mead  
& Hunt**

[www.meadhunt.com](http://www.meadhunt.com)

September 2016

**THIS PAGE INTENTIONALLY LEFT BLANK**

## Table of Contents

	Page
<b>1. Introduction .....</b>	<b>1</b>
<b>2. Existing Conditions .....</b>	<b>3</b>
A. Description .....	3
B. Current bridge sufficiency rating .....	4
C. Structural deficiencies and condition .....	4
D. Functionally obsolete .....	6
<b>3. Purpose and Need.....</b>	<b>7</b>
<b>4. Alternative Analysis.....</b>	<b>9</b>
A. Alternative 1 – Do nothing .....	9
B. Alternative 2 – Rehabilitation.....	9
C. Alternative 3 – Build on new location without using historic bridge .....	12
(1) Option A – Retain the historic bridge in vehicular service as one half of a one-way couplet .....	13
(2) Option B1 – Retain the historic bridge as a monument ...	16
(3) Option B2 – Retain the historic bridge as a non- motorized vehicle/pedestrian/ bicycle facility .....	17
<b>5. Summary of Findings .....</b>	<b>21</b>
<b>Works Cited.....</b>	<b>41</b>

## Tables

1	US 60 Bridge over Horse Creek NBI ratings.....	4
2	Summary of alternative analysis .....	23

**Appendices**

- A Oklahoma Department of Transportation Bridge Inspection Report  
(April 6, 2015)
- B Project Location Map
- C Photographs (April 2016)
- D 1935 Design Plans for U.S. Highway 60 and Horse Creek Bridge  
(Select Sheets)
- E Hydraulic Analysis, 2016
- F Preliminary Plans for Bridge and Approaches, US 60 over Horse  
Creek, 2016 (Select Sheets)



## 1. Introduction

According to Section 4(f) regulations (23 CFR 774), the Federal Highway Administration (FHWA) may not approve an action that uses publicly owned parks, recreation areas, wildlife and waterfowl refuges, or historic sites, including historic bridges, when there is a feasible and prudent alternative to the action. Actions that “use” a historic bridge are those that result in the demolition or removal of the structure or that reconstruct it to such an extent that the character-defining features that give it historic significance are eliminated or substantially impaired.<sup>1</sup> As established by the Programmatic Section 4(f) Evaluation for Historic Bridges, a limited number of avoidance alternatives must be evaluated and rejected before the FHWA can approve an action that uses a historic bridge.<sup>2</sup> The purpose of this report is to present the alternatives analysis for the U.S. Highway (US) 60 Bridge over Horse Creek to enable the FHWA and the Oklahoma Department of Transportation (ODOT) to assess the feasibility and prudence of the alternatives.

To prepare this report, a Mead & Hunt, Inc. (Mead & Hunt) qualified professional historian and professional structural engineer conducted a site visit to the bridge on April 20, 2016; reviewed bridge inspection reports, bridge plans, and other documents related to the bridge; and participated in conference calls with representatives from ODOT and the design consultant.

Constructed in 1936, the US 60 Bridge over Horse Creek is listed in the National Register of Historic Places (NRHP) under *Criterion A: Transportation*. The bridge is significant as a unique example of the need to accommodate pedestrians in a time when the automobile was becoming the dominant mode of transportation. The 143-foot-long steel I-beam bridge is known locally as “the side-walk” bridge for its double reinforced-concrete walkway design.<sup>3</sup> The sidewalks and associated railings are the key elements of the US 60 Bridge that represent its significance and therefore are its character-defining features.

The remainder of this report is organized to present a description of the bridge and its existing conditions, identify the proposed project’s purpose and need, and discuss the analysis of three primary avoidance alternatives. The three primary alternatives under consideration in this document are:

1. Do nothing;
2. Rehabilitate the historic bridge for continued vehicular service for two-way traffic; and
3. Construct a structure on new location without adversely affecting the historic bridge’s integrity.

---

<sup>1</sup> Federal Highway Administration, Office of Planning, Environment, and Realty, Project Development and Environmental Review, “Section 4(f) Policy Paper,” 20 July 2012, <http://www.environment.fhwa.dot.gov/4f/4fpolicy.pdf> (accessed 20 December 2013).

<sup>2</sup> Federal Highway Administration and Oklahoma Department of Transportation, “Design Support for Section 4(f) Analysis for Historic Bridges,” 25 March 2013 (updated).

<sup>3</sup> National Register of Historic Places, Horse Creek Bridge, Afton, Ottawa County, Oklahoma. National Register #95000040.

Alternative 3 identified above is subdivided into three options:

- Option A – Retain the historic bridge in vehicular service as half of a one-way couplet.
- Option B1 – Retain the historic bridge as a monument with a new bridge constructed on an offset highway alignment.
- Option B2 – Retain the historic bridge as a non-motorized vehicle/pedestrian/bicycle facility with a new bridge constructed on an offset highway alignment.

The American Association of State Highway and Transportation Officials (AASHTO)'s *A Policy on Geometric Design of Highways and Streets 2011* (AASHTO Green Book) was used to complete the alternatives analysis in accordance with FHWA and ODOT guidelines for the Design Support for Section 4(f) Analysis for Historic Bridges.

## **2. Existing Conditions**

This section addresses the existing condition of the US 60 Bridge, including a description of the structure and its setting. Two primary considerations in this section for the US 60 Bridge are structural deficiency and functional obsolescence. A discussion of the bridge's current sufficiency rating, which is determined during each bridge inspection, is also presented to provide a framework for understanding the bridge's structural deficiency and functional obsolescence. The latest ODOT Bridge Inspection Report, based on an inspection performed on April 6, 2015, is included in Appendix A.

### **A. Description**

The US 60 Bridge over Horse Creek is located in ODOT Division 8, in the northeast area of the city of Afton, Ottawa County, Oklahoma, 2.6 miles north of the Delaware County Line (see Appendix B for a project location map). Residential and commercial properties are located to the west of the bridge on both sides of US 60.

The US 60 Bridge over Horse Creek is a three-span structure with an overall length of approximately 143 feet, as measured from the back of the abutments. The bridge consists of one 60-foot-long and two 40-foot-long steel I-beam spans, with a cast-in-place reinforced-concrete deck providing a 24-foot clear roadway for two lanes of traffic and two 5-foot-wide sidewalks, one on each side of the roadway. The bridge has reinforced-concrete railings on each side of the sidewalks, for a total of four railings. The bridge is skewed at a 45-degree angle with the waterway.

The steel I-beam spans are supported on two cast-in-place reinforced-concrete abutments (each with two cast-in-place reinforced-concrete wingwalls) and on two cast-in-place reinforced-concrete piers with concrete web walls between concrete columns. The foundations for the abutments and piers are supported on limestone bedrock. See Appendix C for photographs of the bridge and Appendix D for select original plans for this bridge.

The bridge was originally designed for an AASHTO H 20 (20-ton truck) live load. The bridge is not load posted/weight restricted. The bridge inspection report (April 2015) indicates that this bridge was last load rated on August 1, 2006, using the Load Factor (LF)-Ton inventory rating method. The results of that rating indicate a Posting of 5: At/Above Legal Loads.

US 60 at the project site is classified as a rural minor arterial highway. The highway is not on the National Highway System and is not part of a national truck route. The 2016 average annual daily traffic (AADT) on the bridge is 7,000 vehicles; the projected 2036 AADT is 11,200 vehicles. The truck percentage as a measure of AADT is approximately 23 percent. The posted speed limit at the bridge location is 35 miles per hour (mph) and increases to 45 mph east of the bridge. There have been several crashes at this bridge in recent years, as evidenced by repairs to three sections of the concrete bridge railings. These crashes appear to have been single vehicle collisions with the concrete railings, as documented in ODOT's Collision Analysis Report for the period January 2004 to December 2006.

Several items impact the hydraulics of Horse Creek. An active railroad bridge is located approximately 650 feet upstream (north) of the existing bridge. In addition, there are remnants of the old Route 66 Bridge and abandoned highway fill to the north of the existing bridge. The old concrete west abutment remains surrounded with vegetation. Portions of two concrete pier foundations remain in the waterway. These old substructure remnants and highway fill appear to partially obstruct the Horse Creek waterway flow.

## **B. Current bridge sufficiency rating**

The bridge's current sufficiency rating is 29.9 out of a possible 100 points. The sufficiency rating measures a bridge's capability to remain in vehicular service, based on a mathematical formula incorporating condition ratings, load capacity, roadway and structure geometrics, traffic counts, presence of suitable detour routes, and other bridge inspection factors. A bridge with a sufficiency rating of 80 or less is eligible for federal bridge rehabilitation funding. A bridge with a sufficiency rating of 50 or less is eligible for federal bridge replacement funding.

The bridge is structurally deficient (SD) and functionally obsolete (FO) with the following National Bridge Inventory (NBI) ratings on a scale of 9 = Excellent Condition to 0 = Failed Condition as shown in Table 1, in accordance with the current Bridge Inspection Report (April 2015) (see Appendix A). This report will be referred to herein after as "Bridge Inspection Report."

**Table 1. US 60 Bridge over Horse Creek NBI ratings**

<b>Item</b>	<b>Current Rating (April 2015)</b>
NBI Item 58 (Deck)	3 = Serious
NBI Item 59 (Superstructure)	4 = Poor
NBI Item 60 (Substructure)	5 = Fair
NBI Item 61 (Channel)	7 = Minor Damage
Overall Sufficiency Rating	29.9 (SD, FO)

## **C. Structural deficiencies and condition**

Bridges are considered structurally deficient if significant load-carrying elements are found to be in poor condition due to deterioration and/or damage. Structural deficiency is numerically defined as a bridge component (deck, superstructure, or substructure) having an NBI general condition rating of 4 (poor condition) or less. The concrete deck for this bridge has a rating of 3, and the superstructure has a rating of 4.<sup>4</sup> Based on the Bridge Inspection Report and field verification, the structural deficiencies and conditions are listed below according to NBI item, along with the condition state for individual elements.<sup>5</sup>

---

<sup>4</sup> According to the *Recording and Coding Guide for the Structure Inventory and Appraisal of the Nation's Bridges*, "Rating 3 - Serious Condition" means that structural elements show loss of section, deterioration, spalling or scour having seriously affected primary structural components. Local failures are possible.

<sup>5</sup> NBI element-level inspection condition state for individual components of a bridge are defined as follows: 1 = Good; 2 = Fair; 3 = Poor; 4 = Severe; and 5 = (undefined, but is critical or imminent failure).

- NBI Item 36A-Bridge Rail, Item 36B-Rail Transition, Item 36C-Approach Rail, and Item 36D-Approach Rail Ends: These items rate as 0-Substandard. The concrete railings between the roadway and the sidewalks do meet current crash rating test level (TL) standards.<sup>6</sup> The concrete railings on the outside of the sidewalks do not meet current geometric and safety requirements for overall height and for minimum clear opening dimensions between elements of the railing. There is no approach railing to the bridge, nor are there any approach railing ends.
- NBI Item 58 – Deck (3, serious condition): The entire reinforced-concrete deck is rated in Condition State 3 – Poor. The concrete deck has many cracks, patched areas, spalls, and impending potholes with exposed reinforcing steel bars. Joints in the concrete deck have completely failed and are allowing water and debris to drip on to the steel beams and steel diaphragms below the joints. The deck was observed to be pumping or bouncing on the steel beams when traffic passed over. This is because the concrete deck is not physically attached to the steel beams. The reinforced-concrete sidewalks are in fair condition without any potholes or spalled areas. The longitudinal joints between the sidewalks and the bridge railings are unsealed, allowing water to drip on the steel beams below.
- NBI Item 59 – Superstructure (4, poor condition): The steel beams that support the roadway concrete deck and concrete sidewalks are in Condition State 2 – Fair. The paint system has failed in approximately 25 percent of the surface area of the steel beams, primarily at the ends over the bearings. Minor deterioration of the steel was observed at the ends of the beams; several of the beams have supplemental steel sections welded to them on the bottom flanges at the ends. Steel diaphragms between the beams over the piers and abutments have failed. Many of the steel diaphragms have completely deteriorated with total loss of section; several of the most deteriorated diaphragms have been removed. Steel bearings for the beams have complete paint failure and moderate loss of section.
- NBI Item 60 – Substructure (5, fair condition): The reinforced-concrete piers and abutments are in Condition State 2 – Fair. The west abutment and east abutment have minor spalls and cracks with exposed reinforcing steel; several of the cracks have efflorescence. Other than very minor spalling on top of the concrete caps, the reinforced-concrete piers did not exhibit structural deficiencies.
- NBI Item 61 – Channel and Channel Protection (7 = minor damage): The north embankment for the west abutment is protected with riprap consisting of chunks of concrete and large segments of asphalt. This protection appears to be stable, with only a few chunks dislodged and resting in the waterway. The north embankment of the east abutment is protected with segments of asphalt and layers of crushed asphalt. This protection appears to be stable. Plans for the original bridge construction indicate that stone riprap was provided at each of these locations.

---

<sup>6</sup> TL 3 for speeds less than 50 mph with approach guardrail or TL 4 for speeds less than 50 mph without approach guardrail.

- NBI Item 71 – Waterway Adequacy (7, above minimum): The bridge crosses over Horse Creek at a 45-degree skew angle. The westerly portion of the river channel under the westerly span of the bridge has filled itself in over the years, and is currently a blockage to the full hydraulic opening through the bridge. The main water channel passes under the center span of the bridge for low flow events. At the time of the site visit, water was flowing only in the channel under the center span, and this was after a moderate rain event the night before. A hydraulic analysis and summary for this bridge was completed assuming a waterway opening equivalent to that which existed when the bridge was originally constructed (see Appendix E). The hydraulic analysis indicated that this bridge is able to pass the 100 year flood frequency event without overtopping the roadway. The hydraulic summary also indicates that the roadway would overtop during a 255-year frequency event.
- NBI Item 72 – Approach Roadway (8, equals desirable criteria): The asphalt roadway approaches at each end of the bridge are in good condition. The shoulders are not paved.
- NBI Item 113 – Scour Rating (8, stable above footing): The foundations of the substructure units were not visible during the field visit. Original design plans indicate that foundations are supported on bedrock.

#### **D. Functionally obsolete**

Bridges are considered functionally obsolete when the deck geometry, load carrying capacity (comparison of the original design load to the current legal loads), clearance, or approach roadway alignment do not meet current design criteria. In general, functionally obsolete means that the bridge was built to standards that are no longer used today.

This bridge, designed for an AASHTO H-20 (20-ton truck) live load, meets current load criteria. However, this bridge is considered functionally obsolete because its clear roadway width and approach roadway width do not meet current criteria for the current and projected AADT.

The bridge's clear roadway width of 24 feet does not meet current criteria. The bridge has two 12-foot-wide lanes with no outside shoulders. Current roadway design standards outline that the minimum clear roadway width across a bridge with two-way traffic is 40 feet (two 12-foot traffic lanes and two 8-foot shoulders) for an arterial functional class and an AADT greater than 2,000 vehicles per day.

The width of the roadway at each end of the bridge is also substandard. Current roadway design standards are for two 12-foot-wide traffic lanes with 8-foot-wide shoulders at each end of the bridge for a roadway with an arterial functional classification. The horizontal alignment and vertical profile geometry of the roadway approaches at each end of the bridge are acceptable. West of the bridge, US 60 passes through Afton on a tangent alignment with a posted speed limit of 35 mph. East of the bridge, US 60 has a horizontal curve with a posted speed limit of 45 mph.

### **3. Purpose and Need**

The project need describes the transportation deficiency. It is the foundation of the entire decision-making process. The need provides information to support the purpose and explains why the project is needed.

The need for the project is as follows:

- The existing bridge over Horse Creek is structurally deficient.
- The existing bridge is functionally obsolete and is of substandard width.
- The existing bridge rails do not meet full-scale crash criteria.

The project purpose defines the problem to be solved. Defining the purpose is necessary to determine the range of alternatives that will be considered.

The purpose of this project is as follows:

- Provide a structurally sound bridge over Horse Creek.
- Preserve Historic Route 66 and the Route 66 National Scenic Byway as a tourist destination in Oklahoma.

**THIS PAGE INTENTIONALLY LEFT BLANK**



## **4. Alternative Analysis**

This section addresses the alternatives that are required to be considered for the Programmatic Section 4(f) Evaluation for Historic Bridges. Each alternative is assessed for its ability to meet project purpose and need, and to avoid effects to the character-defining features that give the bridge its historic significance.

### **A. Alternative 1 – Do nothing**

Alternative 1 would leave the existing structure in place, without bypass, rehabilitation, or replacement. Under this alternative, there would be no use of the Section 4(f) property since character-defining features that make the bridge significant would not be removed or substantially altered.

Previous cyclical or routine maintenance activities have been minimal and limited to activities like annual water-washing of the bridge deck and sidewalks. The bridge is currently on a 24-month inspection schedule. Condition-based maintenance activities have included repairing damaged concrete railing sections due to vehicular impact.

Under this alternative the bridge would be left in place and the structural and functional deficiencies discussed earlier in this evaluation would remain unresolved and potentially lead to unacceptable safety hazards for the traveling public. Efforts to correct the structural deficiencies of the bridge are beyond what is considered routine maintenance. No increased costs associated with routine maintenance or inspections are anticipated under this alternative. Routine maintenance would continue at existing levels and inspections would continue according to their current frequency.

With this alternative, the bridge will continue to deteriorate and may need to be load posted at some time. Such load posting would require heavy trucks to use alternate routes.

The “Do Nothing” alternative would avoid use of the historic bridge as a Section 4(f) property and have the least impact on the historic integrity of the bridge, at least in the short term. However, if left untreated, the existing structural deficiencies will worsen and develop into more significant defects. The existing functional inadequacies related to roadway width and substandard non-crash tested railings would also remain unaddressed. This alternative would not meet the project purpose and need because it would not provide a structurally sound bridge. It does not correct the structurally deficient and functionally obsolete bridge. In the near term, this alternative would meet the project purpose to preserve Historic Route 66 and the Route 66 National Scenic Byway as a tourist destination in Oklahoma. However, in the long term, the lack of rehabilitation and maintenance of the historic bridge would result in its continued deterioration and could lead to eventual failure. Failure and removal of the bridge would remove a historic element from Route 66.

### **B. Alternative 2 – Rehabilitation**

This alternative would rehabilitate the existing bridge to be in conformance with current design standards and to continue vehicular service for two-way traffic. This alternative would leave the existing bridge in place and continue to allow two-way traffic on the structure. The structure would be widened on both

sides to meet current roadway design criteria: a 24-foot-wide roadway with 8-foot shoulders on each side, for a clear roadway width of 40 feet, with or without sidewalks.

To rehabilitate the structure for continued vehicular use, the following work would need to be undertaken:

- Construct temporary bypass roadway (shoofly) with culvert pipes on the south side of the existing road.
- Detour traffic to the temporary bypass roadway (shoofly).
- Remove the four lines of concrete railings, two lines on each side of the roadway.
- Remove both concrete sidewalks.
- Remove the existing, original, 8-inch, non-composite, cast-in-place, reinforced-concrete deck.
- Remove the two exterior steel beams that support the outer edges of the sidewalks.
- Remove steel diaphragms.
- Remove the two reinforced-concrete wingwalls at each abutment.
- Modify each abutment to match the desired bridge beam and deck geometry.
- Modify top of wingwalls to match revised bridge deck geometry.
- Modify top of each pier to match the desired bridge beam geometry.
- Remove, clean, and paint, then reinstall, existing bearings at ends of existing six interior steel beams.
- Clean and paint the existing steel beams. This operation will require containment of material and old paint from the cleaning and painting operations.
- Add two lines of steel beams, one line each side of the bridge, with new bearings. These new beams would be fully painted before shipment to the project site. These new steel beams would also have stud shear connectors that would project into the new concrete deck.
- Erect new steel diaphragms between steel beams, and connect with high-strength bolts.
- Weld new stud shear connectors to the top flanges of the existing steel beams so that the new concrete deck will act compositely with the steel beams.

- Construct new cast-in-place reinforced-concrete deck with epoxy coated rebars. This would include construction of sealed expansion joints over the substructure units.
- Construct new crash-tested concrete railings (Texas Type T66 or ODOT Std TR4-2) on the outside edges of the bridge to meet TL 3 standard. The railing can be matched in material but no standard crash-tested railing matches the historic railing in appearance.
- Patch spalled areas of the faces of both abutments.
- Dredge the creek channel under the westerly span of the bridge and restore the waterway opening through the entire bridge to its originally constructed condition.
- Add supplemental stone riprap on the north side of the west abutment and the north side of the east abutment.
- Construct new roadway segments on each side of the bridge, and transition to match the existing roadway.
- Construct approach guardrail with transitions according to current design standards on each end of the bridge.
- Paint pavement markings (lane line striping) on the bridge and the roadway approaches.
- Switch traffic back to the original roadway, and remove the temporary bypass.

The estimated cost of this alternative is \$2,440,347. The estimated cost includes the following:

- Right-of-way acquisition and utility relocation costs: \$312,900.
- Roadway costs, including temporary shoofly detour: \$1,174,860.
- Bridge rehabilitation costs: \$952,587.<sup>7</sup>

This alternative would remedy most of the existing functional and structural deficiencies in the bridge's substructure and superstructure. The rehabilitation would accomplish the following:

- Remedy the deterioration in the concrete deck and deck expansion joints.
- Alleviate the deteriorated condition of the steel beams, bearings, and diaphragms.

---

<sup>7</sup> The rehabilitation costs do not include a sidewalk as part of the widening and assume an ODOT Std TR4-2 railing.

- Resolve the deteriorated condition of the paint system.
- Provide a crash-tested railing that meets current crash testing test level TL 3(TL) criteria.
- Improve the waterway opening and hydraulics through the bridge to nearly its original condition.
- Correct deficiencies leading to functional obsolescence by widening the bridge to current roadway standards.

The hydraulic analysis performed (see Appendix E) indicates that the existing bridge can pass the 255-year storm event without overtopping the roadway. This analysis is based on the assumption that the westerly portion of the water channel is dredged to provide the waterway opening similar to that when the bridge was constructed. After the rehabilitation is completed, this bridge is expected to continue to serve in its present capacity for 25 to 30 years or longer with proper maintenance, stabilization, and preservation activities.

This rehabilitation alternative would meet the project purpose and need to provide a structurally sound bridge since it will correct the structurally deficient and functionally obsolete bridge and provide new railings that meet full-scale crash criteria. This alternative would also meet the project purpose to preserve Historic Route 66 and the Route 66 National Scenic Byway as a tourist destination in Oklahoma. This alternative does impact character-defining features and remove historic fabric of the bridge, including the removal of four original concrete railings and the elimination of the sidewalks. These changes to the bridge may decrease this bridge's appeal as a particular tourist destination; however, changes to one structure along the approximately 400-mile corridor would not diminish the ability of the overall route to serve as a tourist destination. This alternative would not avoid the use of the bridge as a Section 4(f) property since the rehabilitation would diminish the structure's historic integrity.

### **C. Alternative 3 – Build on new location without using historic bridge**

Alternative 3 involves the construction of a new bridge and various options for the historic bridge. For the three options in Alternative 3, consideration of the location of the new bridge included an assessment of local constraints. Engineers working on preliminary design options for a new bridge assessed the orientation of a new bridge on both the north (upstream) and south (downstream) sides of the historic bridge. This analysis determined that constructing a new bridge on the south side would result in greater impacts to wetlands and private property; a new bridge located north of the existing structure would minimize these impacts. Also, a new bridge located north of the existing structure would provide better geometric alignment of the highway at the curve at the east end of the project, and minimize right-of-way acquisition at both the west and east ends of the project. (Preliminary plans are included in Appendix F.)

The new bridge and roadway relocation would require approximately 1.47 acres of additional right-of-way. This is estimated to result in impacts to 11 properties: seven properties would be infringed upon (acquiring property) and an additional four properties would be affected (temporary construction easements).

With the construction of a new bridge, a hydraulic analyses would need to be conducted with both bridges in place, to determine the adequacy of the waterway opening through both bridges. This analysis would be based on the assumption that the westerly portion of the water channel through the existing bridge is dredged to provide the waterway opening similar to that when the bridge was constructed. Such hydraulic analysis is beyond the scope of this report.

**(1) Option A – Retain the historic bridge in vehicular service as one half of a one-way couplet**

Alternative 3, Option A consists of constructing a new bridge adjacent to the historic bridge and using each structure to carry one lane of one-way traffic plus shoulders in a single direction. The centerline of the new US 60 alignment would be 50 feet north of the existing centerline, resulting in a clearance of approximately 10 feet between the edges of the bridges. The width of the new bridge would be constructed to accommodate one 24-foot-wide traffic lane plus two 8-foot shoulders, for a total clear roadway width of 40 feet. If necessary in the future, the new bridge could carry two-way traffic with two 12-foot traffic lanes with 8-foot shoulders, should the historic bridge be taken out of service. Under this alternative, the historic bridge would be left in place and would carry one lane of one-way traffic in the opposite direction.

Rehabilitation of the existing bridge as half of a one-way couplet would require the following repairs:

- Construct a new bridge to the north of the existing bridge, located so there would be 2 feet clear distance between the outside edge of the new bridge and the outside edge of the existing bridge. The new bridge would be 240 feet long, with spans of 70, 100, and 70 feet, and have Type IV precast prestressed concrete girders with a cast-in-place reinforced-concrete deck. New cast-in-place reinforced-concrete abutments and piers would be constructed for the new bridge substructure. This new bridge would have a 40-foot clear roadway width and crash-tested barrier railings on each side, without sidewalks. Traffic would continue to operate on the existing bridge while the new bridge is constructed. This bridge would be designed as described above to accommodate two lanes of traffic with shoulders in the future, should the existing bridge need to be removed.
- Construct new US 60 roadway approaches on each side of the new bridge, with roadway width of 24 feet for two 12-foot traffic lanes, plus 8-foot shoulders on each side. Tie this new road to the existing road on each side of the bridge, using 45 mph as the design criteria for geometric alignment.

- Construct signage and pavement markings for the roadway split on approaches at each end of the bridges.
- Switch two-way US 60 traffic to the new bridge after the new roadway approaches are constructed.
- Perform the following work on the existing bridge; the bridge would retain its existing width, but the sidewalks and railings would be removed, and a wider roadway deck would be constructed. The clear roadway width would be approximately 36 feet, which is wide enough for one 12-foot traffic lane plus 8-foot shoulders on each side, plus an allowance for extra width to accommodate the steel I-beam framing:
  - Remove the four lines of concrete railings, two lines on each side of the roadway.
  - Remove both concrete sidewalks.
  - Remove the existing, original, 8-inch, non-composite, reinforced-concrete deck.
  - Remove the two exterior steel beams that support the outer edges of the sidewalks. Also remove all bearings for these steel beams.
  - Remove all steel diaphragms.
  - Remove the north reinforced-concrete wingwall at each abutment; retain the south wingwalls.
  - Modify each abutment to receive one new line of exterior steel beams on each side of the bridge, and revise geometry to match new deck.
  - Modify top of existing concrete wingwalls on the south side of each abutment; construct a concrete closure wall at each abutment between the existing bridge and the new bridge.
  - Modify each pier cap to receive one new line of exterior steel beams on each side of the bridge.
  - Remove, clean, and paint, then reinstall, existing bearings at ends of existing six interior steel beams.
  - Clean and paint the existing steel beams. This operation will require containment of material and old paint from the cleaning and painting operations.
  - Add two lines of steel beams, one line each side of the bridge, with new bearings. These new beams would be fully painted before shipment to the

project site. These new steel beams would also have stud shear connectors which would project into the new concrete deck.

- Erect new steel diaphragms between all steel beams, and connect with high-strength bolts.
- Weld stud shear connectors to the top flanges of the existing steel beams so the new concrete deck will act compositely with the steel beams.
- Construct new cast-in-placed reinforced-concrete deck with epoxy coated rebars. This would include construction of sealed expansion joints over the substructure units.
- Construct new crash-tested concrete railings (Texas Type T66 or ODOT Std TR4-2) on the outside edges of the bridge to meet TL 3 standard. The railing can be matched in material but no standard crash-tested railing matches the historic railing in appearance.
- Patch spalled areas of the faces of both abutments.
- Dredge the creek channel under the westerly span of the bridge and restore the waterway opening through the entire bridge to its originally constructed condition.
- Reconstruct US 60 roadway approaches at each end of the bridge.
- Construct approach guardrail with transitions according to current design standards.
- Paint pavement markings (lane line striping) on the bridge and the roadway approaches.
- Switch eastbound US 60 traffic back to the original roadway, and keep westbound US 60 traffic on the new bridge.

The total cost for this alternative is estimated at \$4,891,438 and includes the following:

- Right-of-way acquisition and utility relocation costs: \$1,300,000.
- Roadway costs: \$1,110,660.
- Bridge rehabilitation costs: \$955,155.<sup>8</sup>
- New bridge costs: \$1,525,623.

---

<sup>8</sup> The rehabilitation costs do not include a sidewalk as part of the widening and assume an ODOT Std TR4-2 railing.

With the construction of a new vehicular bridge, this alternative meets the project's purpose and need to provide a structurally sound bridge.<sup>9</sup> Rehabilitation of the historic bridge as a one-way couplet also addresses the purpose and need to provide a structurally sound bridge since it will correct the structurally deficient and functionally obsolete bridge and provide new railings that meet full-scale crash criteria. After the rehabilitation is completed, this bridge is expected to continue to serve similar to its present capacity for 25 to 30 years or longer with proper maintenance, stabilization, and preservation activities.

This alternative would also meet the project purpose to preserve Historic Route 66 and the Route 66 National Scenic Byway as a tourist destination in Oklahoma. This alternative impacts character-defining features and removes historic fabric of the bridge, including the four original concrete railings and the elimination of the sidewalks. These changes may decrease this bridge's appeal as a particular tourist destination; however, changes to one structure along the approximately 400-mile corridor would not diminish the ability of the overall route to serve as a tourist destination. This alternative would not avoid the use of the bridge as a Section 4(f) property since the rehabilitation of the bridge as a one-way couplet would impact the structure's historic integrity.

**(2) Option B1 – Retain the historic bridge as a monument**

This alternative would construct a new structure that would carry two-way traffic parallel to the existing bridge. The new structure and associated US 60 roadway realignment would be as described in Alternative 3, Option A above, but would carry two-way traffic rather than one-way traffic. The new structure would meet current design criteria with a clear roadway width of 40 feet and would require additional right-of-way costs and utility relocation costs as described for Option A. The historic bridge would remain in use until the construction of the new bridge is complete. Once the new bridge is open, traffic would be diverted onto the new bridge and the historic bridge would be left in place as a monument. The road at each end of the historic bridge would be obliterated with the grade restored to its original condition. The bridge ends would also be barricaded to prevent access by traffic, non-motorized vehicles, pedestrians, and bicyclists. Rehabilitation work would be limited to removing the north wingwalls at each abutment, constructing a concrete closure wall between the existing bridge and the new bridge, resealing the joints in the existing concrete deck, and dredging the creek channel under the westerly span of the bridge to its originally constructed condition. Under this alternative, periodic inspection of the historic bridge would be required to monitor the bridge's condition, as is currently done on a bi-annual basis.

The total cost of constructing a new bridge and leaving the historic bridge in place as a monument is estimated at \$3,962,805, which is broken down as follows:

- Right-of-Way Acquisition and Utility Relocation Costs: \$1,300,000.
- Roadway Costs: \$1,027,200.

---

<sup>9</sup> Construction of the new bridge would require additional hydraulic studies to determine potential impacts to the river, in terms of hydraulic capacity with two bridges in place.



- Bridge Rehabilitation Costs: \$109,982.
- New Bridge Costs: \$1,525,623.

With the construction of a new vehicular bridge, this alternative meets the project purpose and need to provide a structurally sound bridge.<sup>10</sup> However, in the long term the lack of rehabilitation and maintenance of the historic bridge may equate to an adverse effect to its historic integrity since the superstructure elements and substructure would likely continue to deteriorate and could lead to eventual failure. It is estimated that this bridge could serve as a monument for 30 to 40 years or longer with proper maintenance and preservation activities.

This alternative would also meet the project purpose to preserve Historic Route 66 and the Route 66 National Scenic Byway as a tourist destination in Oklahoma. The bridge would remain in place as a monument adjacent to the new bridge allowing it to continue to serve as a visible element of the history of Route 66. However, in the long term the lack of rehabilitation and maintenance of the historic bridge would result in its continued deterioration and could lead to eventual failure. Failure and removal of the bridge would remove a historic element from Route 66. The construction of a new bridge next to the historic bridge would not diminish the integrity of the overall route as a tourist destination.

This alternative does not impact the bridge's character-defining features and does not remove historic fabric. This alternative avoids use of the bridge as a Section 4(f) property since its historic integrity would be retained.

**(3) Option B2 – Retain the historic bridge as a non-motorized vehicle/pedestrian/bicycle facility**

This alternative would construct a new structure of the same type described in Alternative 3, Option B1 above, that would handle both directions of traffic and would be located parallel to, and upstream (north) of, the existing bridge. The new structure would meet current design criteria with a clear roadway width of 40 feet and would require additional right-of-way acquisition costs and utility relocation costs as described for Alternative 3, Option A. The historic bridge would remain in use during construction of the new bridge. Once the new bridge was opened, traffic would be diverted to the new bridge and the historic bridge would be rehabilitated and left in place for pedestrians, bicyclists, and non-motorized vehicles. The existing roadway approaches at each end of the historic bridge would be retained to accommodate pedestrians and bicyclists. A barrier would be constructed at each end of the historic bridge to allow pedestrians and bicyclists through but prevent vehicular access to the bridge.

As a non-motorized vehicle/pedestrian/bicycle bridge, the historic bridge would not carry vehicular traffic. The bridge would need to be load rated for the desired current pedestrian live loading of 95 pounds per square foot of bridge deck area, with appropriate reduction factors based on the

---

<sup>10</sup> Construction of the new bridge would require additional hydraulic studies to determine potential impacts to the river, in terms of hydraulic capacity with two bridges in place.

area of the deck. It is expected that the historic bridge would have sufficient strength to handle this pedestrian live loading, although some rehabilitation work would be necessary, including:

- Patch spalled concrete in bridge deck, estimated at 40 percent of the total deck surface. Overlay entire bridge deck with a 2-inch-thick, non-shrink, concrete overlay. This work includes replacing all of the deck expansion joints between the spans with new sealed expansion joints.
- Replace all steel diaphragms between the existing steel beams with new, painted steel diaphragms connected with high-strength bolts.
- Clean and paint entire steel superstructure. This includes all steel beams and bearings.
- Remove wingwalls at north side of each abutment, and construct a concrete closure wall between the existing bridge and the new bridge.
- Patch spalled concrete surfaces in the faces of the abutments and wingwalls.
- Dredge the creek channel under the westerly span of the bridge and restore the waterway opening through the entire bridge to its originally constructed condition.

The existing four lines of bridge railings would remain in place without modification. The railings adjacent to the roadway do not meet current crash impact load standards. The exterior railings on the outside edges of the sidewalk do not meet current criteria for height and maximum clear openings. The top of the top railing is 39.5 inches above the sidewalk surface; current criteria is 42-inch-high railings. The clear opening between the two lines of horizontal railings is approximately 8 inches. Current criteria outlines that openings must not allow a 4-inch-diameter sphere to pass through the lower portion of a railing and a 6-inch-diameter sphere to pass through the upper portion of the railing. Since no work is being proposed to the existing railings for this lower use option for the bridge, the railings do not need to be modified to meet current standards.

The total cost of constructing a new bridge and leaving the historic bridge in place as a non-motorized vehicle/pedestrian/bicycle bridge is estimated at \$4,548,083, which is broken down as follows:

- Right-of-way acquisition and utility relocation costs: \$1,300,000.
- Roadway costs: \$1,091,400.
- Bridge rehabilitation costs: \$631,060.
- New bridge costs: \$1,525,623.

With the construction of a new vehicular bridge, this alternative meets the project purpose and need to provide a structurally sound bridge.<sup>11</sup> Rehabilitation of the historic bridge for pedestrians, bicycles, and non-motorized vehicles addresses the need to correct a structurally deficient and functionally obsolete bridge. While this bridge is located on the outskirts of Afton, there is generally no need to provide pedestrian, bicycle, or non-motorized vehicle access across Horse Creek, and there are no trails in the vicinity with which to connect.

This alternative would also meet the project purpose to preserve Historic Route 66 and the Route 66 National Scenic Byway as a tourist destination in Oklahoma. The bridge would remain in place for pedestrians, bicycles, and non-motorized vehicles, allowing it to continue as a visible element of the history of Route 66. The construction of a new bridge next to the historic bridge would not diminish the integrity of the overall route as a tourist destination.

This alternative does not impact the bridge's character-defining features and does not remove historic fabric. This alternative avoids use of the bridge as a Section 4(f) property since its historic integrity would be retained. It is estimated that this bridge could function as a non-motorized pedestrian/bicycle facility for 30 to 40 years or longer with proper periodic maintenance, stabilization, and preservation activities.

---

<sup>11</sup> Construction of the new bridge would require additional hydraulic studies to determine potential impacts to the river, in terms of hydraulic capacity with two bridges in place.

**THIS PAGE INTENTIONALLY LEFT BLANK**

## **5. Summary of Findings**

Table 2 summarizes the analysis of three primary alternatives (Alternative 3 subdivided into three options). Detailed cost estimates for each alternative, except the No Build alternative, are also included below. ODOT and the FHWA will use this analysis to assess the feasibility and prudence of avoidance alternatives.

**THIS PAGE INTENTIONALLY LEFT BLANK**

Table 2. Summary of alternative analysis

Avoidance Alternative	Meets Need and Purpose for the Project?	Costs			Preliminary understanding of Social, Economic. Environmental Impacts?	Section 4ff) use?
		Construction (\$)	ROW & Utility Relocation Costs (\$)	Total cost (\$)		
1. No-Build.	No, does not address structural deficiencies or functional inadequacies and does not provide a structurally sound bridge.	NA.	NA	NA	None	NA
2. Rehabilitation Alternative for continued 2-way vehicle use.	Yes, rehabilitation addresses structural and functional inadequacies and provides a structurally sound bridge. Also preserves Historic Route 66 and the Route 66 National Scenic Byway as a tourist destination in Oklahoma.	\$2,127,447	\$312,900	\$2,440,347	None	Yes, this alternative impacts character-defining features and removes historic fabric of the bridge, including the removal of four original concrete railings and the elimination of the sidewalks. This alternative would not avoid the use of the bridge as a Section 4(f) property since the rehabilitation would impact the structure's historic integrity. Design life of 25-30 years.
3A. Retain historic bridge in vehicular service as one half of one-way couplet; construct new bridge parallel to existing bridge with two lanes of traffic and shoulders.	Yes, addresses structural and functional inadequacies of historic bridge and paired with a new bridge provides a structurally sound bridge. Also preserves Historic Route 66 and the Route 66 National Scenic Byway as a tourist destination in Oklahoma.	\$3,591,438	\$1,300,000	\$4,891,438	Construction of a new bridge is expected to pose impacts to private property, wetlands, endangered species, and utilities.	Yes, this alternative impacts character-defining features and removes historic fabric of the bridge, including the four original concrete railings and the elimination of the sidewalks. This alternative would not avoid the use of the bridge as a Section 4(f) property since the rehabilitation of the bridge as a one-way couplet would impact the structure's historic integrity. Design life of 25-30 years.
3B1. Retain historic bridge as a monument; construct new bridge parallel to existing bridge with two lanes of traffic and shoulders.	Yes, with new structure a structurally sound bridge is provided. Also preserves Historic Route 66 and the Route 66 National Scenic Byway as a tourist destination in Oklahoma.	\$2,662,805	\$1,300,000	\$3,962,805	Construction of a new bridge is expected to pose impacts to private property, wetlands, endangered species, and utilities.	No, this alternative does not impact the bridge's character-defining features and does not remove historic fabric. This alternative avoids the use of the bridge as a Section 4(f) property since its historic integrity would be retained.  With this alternative, the lack of rehabilitation and maintenance of the historic bridge may equate to an adverse effect to its historic integrity since the superstructure elements and substructure would likely continue to deteriorate and could lead to eventual failure. Design life of 30-40 years.
3B2. Retain historic bridge as a non-motorized pedestrian or bicycle facility; construct new bridge parallel to existing bridge with two lanes of traffic and shoulders.	Yes, with new structure a structurally sound bridge is provided. Structural deficiencies and functional inadequacies of historic bridge would be addressed in rehabilitation for non-motorized use. Also preserves Historic Route 66 and the Route 66 National Scenic Byway as a tourist destination in Oklahoma.	\$3,248,083	\$1,300,000	\$4,548,083	Construction of a new bridge is expected pose impacts to private property, wetlands, endangered species and utilities.	No, this alternative does not impact the bridge's character-defining features and does not remove historic fabric. This alternative avoids use of the bridge as a Section 4(f) property since its historic integrity would be retained. Design life of 30-40 years.

**THIS PAGE INTENTIONALLY LEFT BLANK**



Design Support Report for Programmatic Section 4(f) Alternatives Analysis

United States (US) Highway 60 Bridge Over Horse Creek

Ottawa County, Oklahoma

Project Number SSP-2991(079)EC

NBI Bridge No.: 05017

Structure No.: 5806 0256X

Prepared for the Federal Highway Administration

And

Oklahoma Department of Transportation

August 2016

**Opinions of Probable Construction Costs**

The opinions of probable construction costs provided herein are presented in third quarter 2016 dollars. These costs were developed by using data previously prepared by others, such as preliminary plans for a proposed new bridge and associated roadway work, bridge inspection reports and hydraulic analysis reports, and site investigations conducted by Mead & Hunt. They were developed without a detailed hands-on bridge inspection or completion of preliminary design for the rehabilitation of the existing historic bridge for the alternatives considered. The estimated costs represent an opinion based on related experience and background knowledge of historic unit prices and comparable work performed on other structures. The opinions of cost are intended to provide a programming level of estimated cost. These costs will require refinement and may require adjustments as further analysis is completed in determining the course of action for future improvements to the structure. A 20% contingency and 7% mobilization allowance have been included in the cost estimates. No administrative or engineering costs have been included.



Darrell J. Berry, PE

Oklahoma PE 26371



Date

# ALTERNATIVE 2-REHABILITATION OF EXISTING BRIDGE

August 26, 2016

			ESTIMATED QUANTITIES AND COST		
ITEM NO.	ITEM	UNIT	QUANTITY	UNIT COST	TOTAL ESTIMATE
<b>RIGHT-OF-WAY ACQUISITION &amp; UTILITY RELOCATION COSTS</b>					
1	RIGHT-OF-WAY ACQUISITION COSTS	LUMP SUM	1	\$75,900	\$75,900
2	UTILITY RELOCATION COSTS	LUMP SUM	1	\$237,000	\$237,000
<b>ESTIMATED ROW &amp; UTILITY COSTS</b>					<b>\$312,900</b>
<b>ROADWAY COSTS</b>					
	MOBILIZATION @ 7%	LUMP SUM	1	\$76,860	\$76,860
1	TEMPORARY DETOUR (SHOOFLY TO SOUTH) WITH TEMPORARY BRIDGE	LUMP SUM	1	\$500,000	\$500,000
2	APPROACH ROADWAY WORK FOR TRANSITIONS EACH END OF EXISTING BRIDGE	LUMP SUM	1	\$400,000	\$400,000
2	GUARDRAIL ON ROADWAY APPROACHES TO BRIDGE, 4 QUADRANTS	LUMP SUM	1	\$15,000	\$15,000
	20% CONTINGENCY	LUMP SUM	1	\$183,000	\$183,000
<b>ESTIMATED ROADWAY COSTS</b>					<b>\$1,174,860</b>
<b>BRIDGE REHABILITATION COSTS</b>					
	MOBILIZATION @ 7%	LUMP SUM	1	\$62,319	\$62,319
1	DEMOLITION OF RAILINGS, SIDEWALKS, DECK, 2 LINES OF BEAMS, ALL STEEL DIAPHRAGMS	LUMP SUM	1	\$75,000	\$75,000
2	NEW STRUCTURAL STEEL BEAMS, STUD SHEAR CONNECTORS, DIAPHRAGMS, BOLTS	LB	43,000	\$3	\$129,000
3	STUD SHEAR CONNECTORS WELDED TO EXISTING STEEL BEAMS	EACH	1,692	\$5	\$8,460
4	CLEAN AND PAINT EXISTING STEEL BEAMS & BEARINGS (INCL CONTAINMENT)	LUMP SUM	1	\$250,000	\$250,000
5	CAST-IN-PLACE REINFORCED CONCRETE DECK WITH EPOXY COATED REBARS	CY	155	\$1,200	\$186,000
6	NEW OK STD. TR 4-2 RAILING	LF	290	\$125	\$36,250
7	MODIFY BEARING SEATS ON PIERS AND ABUTMENTS	LUMP SUM	1	\$10,000	\$10,000
8	PATCH SPALLED CONCRETE AND EPOXY INJECT CRACKS FOR ABUTMENTS & WINGS	LUMP SUM	1	\$25,000	\$25,000
9	DREDGE CREEK CHANNEL	LUMP SUM	1	\$15,000	\$15,000
10	ADD LARGE STONE RIPRAP NORTH OF EACH ABUTMENT	CY	100	\$50	\$5,000
11	4-INCH EPOXY PAINT LINES, BRIDGE AND ROADWAY	LF	2180	\$1	\$2,180
	20% CONTINGENCY	LUMP SUM	1	\$148,378	\$148,378
<b>ESTIMATED BRIDGE REHABILITATION COSTS</b>					<b>\$952,587</b>
<b>NEW BRIDGE COSTS</b>					
	NO NEW BRIDGE COSTS				
<b>ESTIMATED NEW BRIDGE COSTS</b>					<b>\$0</b>
<b>ALTERNATIVE TOTAL COSTS</b>					<b>\$2,440,347</b>

**ALTERNATIVE 3 OPTION A-RETAIN HISTORIC BRIDGE IN VEHICULAR SERVICE AS ONE HALF OF A ONE-WAY COUPLET; CONSTRUCT NEW BRIDGE PARALLEL TO EXISTING BRIDGE**

August 26, 2016

			ESTIMATED QUANTITIES AND COST		
ITEM NO.	ITEM	UNIT	QUANTITY	UNIT COST	TOTAL ESTIMATE
<b>RIGHT-OF-WAY ACQUISITION &amp; UTILITY RELOCATION COSTS</b>					
1	RIGHT-OF WAY ACQUISITION COSTS	LUMP SUM	1	\$1,000,000	\$1,000,000
2	UTILITY RELOCATION COSTS	LUMP SUM	1	\$300,000	\$300,000
<b>ESTIMATED ROW &amp; UTILITY COSTS</b>					<b>\$1,300,000</b>
<b>ROADWAY COSTS</b>					
	MOBILIZATION @ 7%	LUMP SUM	1	\$72,660	\$72,660
1	EARTHWORK FOR NEW ROAD AND APPROCHES FOR EXISTING ROAD AT BRIDGE	LUMP SUM	1	\$350,000	\$350,000
2	2-LANE ROADWAY WITH SHOULDERS ON NEW ALIGNMENT & RECONSTRUCT APPROACH ROADWAYS TO EXISTING BRIDGE	LUMP SUM	1	\$500,000	\$500,000
3	INSTALL GUARDRAIL ON ROADWAY APPROACHES TO EXISTING BRIDGE, 4 QUADRANTS	LUMP SUM	1	\$15,000	\$15,000
	20% CONTINGENCY	LUMP SUM	1	\$173,000	\$173,000
<b>ESTIMATED ROADWAY COSTS</b>					<b>\$1,110,660</b>
<b>BRIDGE REHABILITATION COSTS</b>					
	MOBILIZATION @ 7%	LUMP SUM	1	\$62,487	\$62,487
1	DEMOLITION OF RAILINGS, SIDEWALKS, DECK, 2 LINES OF BEAMS & ALL STEEL DIAPHRAGMS, & 2 WINGWALLS	LUMP SUM	1	\$80,000	\$80,000
2	NEW STRUCTURAL STEEL BEAMS, STUD SHEAR CONNECTORS, DIAPHRAGMS, BOLTS	LB	43000	\$3	\$129,000
3	STUD SHEAR CONNECTORS WELDED TO EXISTING STEEL BEAMS	EACH	1692	\$5	\$8,460
4	CLEAN AND PAINT EXISTING STEEL BEAMS & BEARINGS (INCL CONTAINMENT)	LUMP SUM	1	\$250,000	\$250,000
5	CAST-IN-PLACE REINFORCED CONCRETE DECK WITH EPOXY COATED REBARS	CY	140	\$1,200	\$168,000
6	NEW OK STD. TR 4-2 RAILING	LF	290	\$125	\$36,250
7	MODIFY BEARING SEATS ON PIERS AND ABUTMENTS	LUMP SUM	1	\$10,000	\$10,000
8	PATCH SPALLED CONCRETE AND EPOXY INJECT CRACKS FOR ABUTMENTS & WINGS	LUMP SUM	1	\$25,000	\$25,000
9	CONSTRUCT CONCRETE CLOSURE WALLS AT EACH ABUTMENT	EACH	2	\$10,000	\$20,000
10	DREDGE CREEK CHANNEL	LUMP SUM	1	\$15,000	\$15,000
11	4-INCH EPOXY PAINT LINES, EXISTING BRIDGE AND EXISTING ROADWAY	LF	2180	\$1	\$2,180
	20% CONTINGENCY	LUMP SUM	1	\$148,778	\$148,778
<b>ESTIMATED BRIDGE REHABILITATION COSTS</b>					<b>\$955,155</b>
<b>NEW BRIDGE COSTS</b>					
	MOBILIZATION @ 7%	LUMP SUM	1	\$99,807	\$99,807
1	3 SPAN (70-100-70) TYPE IV PRECAST PRESTRESSED CONCRETE GIRDER BRIDGE	SQ FT	10332	\$115	\$1,188,180
	20% CONTINGENCY	LUMP SUM	1	\$237,636	\$237,636
<b>ESTIMATED NEW BRIDGE COSTS</b>					<b>\$1,525,623</b>
<b>ALTERNATIVE TOTAL COSTS</b>					<b>\$4,891,438</b>

**ALTERNATIVE 3 OPTION B1-RETAIN HISTORIC BRIDGE AS A MONUMENT; CONSTRUCT NEW BRIDGE PARALLEL TO EXISTING BRIDGE WITH 2-LANES OF TRAFFIC**

August 26, 2016

			ESTIMATED QUANTITIES AND COST		
ITEM NO.	ITEM	UNIT	QUANTITY	UNIT COST	TOTAL ESTIMATE
<b>RIGHT-OF-WAY ACQUISITION &amp; UTILITY RELOCATION COSTS</b>					
1	RIGHT-OF-WAY ACQUISITION COSTS	LUMP SUM	1	\$1,000,000	\$1,000,000
2	UTILITY RELOCATION COSTS	LUMP SUM	1	\$300,000	\$300,000
<b>ESTIMATED ROW &amp; UTILITY COSTS</b>					<b>\$1,300,000</b>
<b>ROADWAY COSTS</b>					
	MOBILIZATION @ 7%	LUMP SUM	1	\$67,200	\$67,200
1	EARTHWORK FOR NEW ROAD	LUMP SUM	1	\$350,000	\$350,000
2	2-LANE ROADWAY WITH SHOULDERS ON NEW ALIGNMENT	LUMP SUM	1	\$450,000	\$450,000
	20% CONTINGENCY	LUMP SUM	1	\$160,000	\$160,000
<b>ESTIMATED ROADWAY COSTS</b>					<b>\$1,027,200</b>
<b>BRIDGE REHABILITATION COSTS</b>					
	MOBILIZATION @ 7%	LUMP SUM	1	\$6,062	\$6,062
1	OBLITERATE OLD ROAD PAVEMENT EACH END OF BRIDGE	LUMP SUM	1	\$30,000	\$30,000
2	CONSTRUCT PERMANENT BARRICADES EACH END OF BRIDGE	EA	2	\$2,500	\$5,000
3	REMOVE NORTH WINGWALLS AT EACH ABUTMENT	LUMP SUM	1	\$15,000	\$15,000
4	CONSTRUCT CONCRETE CLOSURE WALLS AT EACH ABUTMENT	EACH	2	\$10,000	\$20,000
5	RESEAL JOINTS IN EXISTING BRIDGE DECK	LF	160	\$10	\$1,600
6	DREDGE CREEK CHANNEL	LUMP SUM	1	\$15,000	\$15,000
	20% CONTINGENCY	LUMP SUM	1	\$17,320	\$17,320
<b>ESTIMATED BRIDGE REHABILITATION COSTS</b>					<b>\$109,982</b>
<b>NEW BRIDGE COSTS</b>					
	MOBILIZATION @ 7%	LUMP SUM	1	\$99,807	\$99,807
1	3 SPAN (70-100-70) TYPE IV PRECAST PRESTRESSED CONCRETE GIRDER BRIDGE	SQ FT	10332	\$115	\$1,188,180
	20% CONTINGENCY	LUMP SUM	1	\$237,636	\$237,636
<b>ESTIMATED NEW BRIDGE COSTS</b>					<b>\$1,525,623</b>
<b>ALTERNATIVE TOTAL COSTS</b>					<b>\$3,962,805</b>

**ALTERNATIVE 3 OPTION B2-RETAIN HISTORIC BRIDGE AS A NON-MOTORIZED PEDESTRIAN OR BICYCLE FACILITY; CONSTRUCT NEW BRIDGE PARALLEL TO EXISTING BRIDGE WITH 2-LANES OF TRAFFIC**

August 26, 2016

			ESTIMATED QUANTITIES AND COST		
ITEM NO.	ITEM	UNIT	QUANTITY	UNIT COST	TOTAL ESTIMATE
<b>RIGHT-OF-WAY ACQUISITION &amp; UTILITY RELOCATION COSTS</b>					
1	RIGHT-OF-WAY ACQUISITION COSTS	LUMP SUM	1	\$1,000,000	\$1,000,000
2	UTILITY RELOCATION COSTS	LUMP SUM	1	\$300,000	\$300,000
<b>ESTIMATED ROW &amp; UTILITY COSTS</b>					<b>\$1,300,000</b>
<b>ROADWAY COSTS</b>					
	MOBILIZATION @ 7%	LUMP SUM	1	\$71,400	\$71,400
1	EARTHWORK FOR NEW ROAD	LUMP SUM	1	\$350,000	\$350,000
2	2-LANE ROADWAY WITH SHOULDERS ON NEW ALIGNMENT & MODIFY EXISTING ROAD AS A TRAIL TO EXISTING BRIDGE	LUMP SUM	1	\$500,000	\$500,000
	20% CONTINGENCY	LUMP SUM	1	\$170,000	\$170,000
<b>ESTIMATED ROADWAY COSTS</b>					<b>\$1,091,400</b>
<b>BRIDGE REHABILITATION COSTS</b>					
	MOBILIZATION @ 7%	LUMP SUM	1	\$41,284	\$41,284
1	PATCH SPALLED CONCRETE IN BRIDGE DECK	SQ FT	1344	\$20	\$26,880
2	CONSTRUCT NEW 2-INCH CONCRETE OVERLAY	SQ FT	3360	\$20	\$67,200
3	CONSTRUCT NEW DECK EXPANSION JOINTS	EACH	4	\$10,000	\$40,000
4	REMOVE AND REPLACE ALL STEEL DIAPHRAGMS WITH PAINTED STEEL MEMBERS	LB	9600	\$3	\$28,800
5	CLEAN AND PAINT EXISTING STEEL BEAMS & BEARINGS (INCL CONTAINMENT)	LUMP SUM	1	\$250,000	\$250,000
6	REMOVE NORTH WINGWALLS AT EACH ABUTMENT	LUMP SUM	1	\$15,000	\$15,000
7	CONSTRUCT CONCRETE CLOSURE WALLS AT EACH ABUTMENT	EACH	2	\$10,000	\$20,000
8	PATCH SPALLED CONCRETE AND EPOXY INJECT CRACKS FOR ABUTMENTS & WINGS	LUMP SUM	1	\$25,000	\$25,000
9	DREDGE CREEK CHANNEL	LUMP SUM	1	\$15,000	\$15,000
10	CONSTRUCT CONCRETE FILLED BOLLARDS AT EACH END OF BRIDGE	EACH	12	\$300	\$3,600
	20% CONTINGENCY	LUMP SUM	1	\$98,296	\$98,296
<b>ESTIMATED BRIDGE REHABILITATION COSTS</b>					<b>\$631,060</b>
<b>NEW BRIDGE COSTS</b>					
	MOBILIZATION @ 7%	LUMP SUM	1	\$99,807	\$99,807
1	3 SPAN (70-100-70) TYPE IV PRECAST PRESTRESSED CONCRETE GIRDER BRIDGE	SQ FT	10332	\$115	\$1,188,180
	20% CONTINGENCY	LUMP SUM	1	\$237,636	\$237,636
<b>ESTIMATED NEW BRIDGE COSTS</b>					<b>\$1,525,623</b>
<b>ALTERNATIVE TOTAL COSTS</b>					<b>\$4,548,083</b>

**THIS PAGE INTENTIONALLY LEFT BLANK**



## US60 Horse Creek Bridge

### Cost estimates:

→ Cost estimates use 20% contingency,  
and 7.0% Mobilization

per ODOT 4/25/16:

programmed project costs:

- Construction: \$1,733,154
- Right-of-way: \$75,905
- Utilities: \$237,000

TOTAL: \$2,046,059, say \$2,046,000

### Assumptions:

- 1) Remove existing bridge
- 2) Construct new bridge on exist. align
- 3) Temporary detour road w/ large culvert pipes temporary bridge

(does not include design engineering  
or construction engineering,  
nor ODOT administrative costs)

Note: Benham Estimate  
8/19/16 Construction  
= \$3,141,853, provided  
backup calculations

### New bridge per Leidos plans:

length = 246' (spans 73'-100'-73')

width = 42'

Type IV P.C. Beams w/ 40' clear roadway,  
skew 45° RF, TR4 Concrete Rail.

effective unit cost w/ 20%  
contingency and 7% mobilization:  
 $\$115/\text{sq} \times 1.20 \times 1.07 = \$147.66$

WisDOT Bridge  
Manual:  
end of 2015:  
\$145/sq  
use this!! w/  
20% contingency

⇒ Approx. bridge cost:

$$246' \times 42' = 10,332 \text{ sq} \times \$115/\text{sq} = \$1,188,180$$

$$\times \$120/\text{sq} = \$1,240,000$$

Per Benham (Leidos) Preliminary Design Report Oct. 12, 2010:

Option 3: New bridge and roadway construction on offset alignment  
to the north, full 6% superelevation across the Bridge  
1.47 AC; 7 properties infringed; 4 properties affected.

R/W Acquisitions: \$977,200

Utility Relocations: \$298,700

Roadway: \$270,000

Earthwork: \$306,880

Bridge: \$1,751,600

Detour (shoofly): \$260,400

Total = \$3,864,780

(302' x 42' x \$138/sq) maybe high, even  
from Oct. 2010

Alternative 2 - Rehabilitation of existing bridge

Existing bridge is 143' long, 24' clear roadway, two-5'-0" sidewalks, 4 lines of concrete railing, total width out-to-out is 38'-10"

per Preliminary Plan and Field Review Meeting March 2016 plans by Leidos: (and from programmed costs)

R/W Acquisitions : \$75,900 (includes temp. constr. easements)

Utility Relocations : \$237,000

Subtotal : \$312,900

Temporary Detour (shoofly) = \$260,400, round to \$350,000;  
(2010) <sup>(2016)</sup>

Roadway Work for Transitions at each end of bridge, allow :

\$170,000, round to \$215,000

(includes guardrail) earthwork : allow = \$100,000  
150' x 4 = 600' x \$25 = 15,000 include

Subtotal = \$315,000

Demolition of 4 bridge railings, concrete sidewalks, bridge deck, 2 lines of steel beams, allow - - - - -

\$75,000

2 lines of steel beams, plus diaphragms & bolts

(W27x94) 2 x (40' + 40') x 94# = 15,040#

(W36x150) 2 x 60' x 150# = 18,000#

(C15x33.9) 6 x 4 x 5' x 33.9# = 4,100#

6 x 2 x 85' x 33.9# = 3,500#

Misc. Allow = 2,000#

9,600#

Total = 42,640#

use 43,000#

x \$3.00/# = \$129,000

For unit price, include fabricated steel, welded stud shear connectors, primed and fully painted. Includes bearings + anchor bolts, and erection } use \$3.00/lb.




- Reinforced concrete deck, 8-inches thick, Updated DJB  
with epoxy coated rebars:

$$\frac{145' \times 42' \times 0.667'}{27} = 150.4 \text{ CY}$$

round to 155 CY x \$1,200 = \$186,000  
to include fillets  
above beams

Use \$1,200/CY, to include formwork  
and epoxy coated rebars; also includes expansion joints

- Stud shear connectors add to existing  
6 lines of steel I-beams, welded,  
3 per row

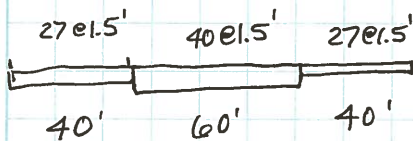

$$6 \times (27 + 40 + 27) \times 3 = 1,692 \text{ ea.} @ \$3.50 = \$8,500$$

(at the site) → +1.50  
\$5.00 ea.

- Clean and paint existing steel  
beams and bearings (near white finish);  
includes containment + environmental  
protection 1 LS = \$250,000

- New OK Std. TR4-2 Railing:  
145' x 2 = 290 LF @ \$125/LF = \$36,200

- Modify bearing seats on piers and  
abutments for new lines of beams: 1 LS = \$10,000

- Patch spalled concrete on abutments,  
and seal cracks w/epoxy injection: 1 LS = \$25,000

- Dredge creek channel, esp. under  
west span: 1 LS = \$15,000

- Add stone riprap north of ea. abutment  
375 SY x 0.510 = 187 2 x 50 CY = 100 CY x \$50/CY = \$5,000

→ Pavement marking (striping): Updated DJB

4 inch epoxy double yellow centerline, white edge lines:

$$4 \times (200' + 145' \times 200') = 2,180 \text{ LF} \times \$1.00/\text{LF} = \$2,180$$

## Alternative 3 - Option A (new bridge on northerly alignment)

- ROW Acquisition costs:

2010 Report had \$977,200 → use \$1,000,000

- Utility Relocation Costs:

2010 Report had \$298,700 → use \$300,000

- Earthwork for New Road:

2010 Report had \$306,880 → use \$350,000

- 2-Lane Roadway w/ Shoulders:

2010 Report had \$270,000 → use ~~\$285,000~~ use \$500,000, updated to match Behan 8/2016 estimate data

- Guardrail at approaches to existing bridge:

$$150' \times 4 \text{ quads.} = 600 \text{ LF} \times \$25.00 = \$15,000$$

- Demolition: railings, sidewalks, decks, 2 lines of beams,

plus 2 wingwalls → use \$80,000  
(#5,000 more than Alt. 2)

- New structural steel (see Alt. 2):  $43,000 \times 3.00/\text{#} = \$129,000$

- Stud shear connectors welded to existing beams (see Alt. 2):  $1,692 \text{ ea.} \times \$5 = \$8,460$

- Clean & paint existing steel (see Alt. 2) → \$250,000

- Cast-in-place reinforced concrete deck:

$$\frac{145' \times 38' \times 0.667'}{27} = 136.1 \text{ CY, round to } 140 \text{ CY} \times \$1,200 = \$168,000$$



- New OK Std. TR4-2 Rail (see Alt. 2)  $290 \text{ LF} \times \$125 = \$36,250$
- Modify bearing seats on piers & abutments for new lines of beams (see Alt. 2) Allow LS = \$10,000
- Patch spalled concrete on abutments, and seal cracks w/epoxy injection (see Alt. 2) Allow LS = \$25,000
- Construct concrete closure walls at each abutment between new & existing bridge:  $2 \text{ Ea.} @ \$10,000 = \$20,000$
- Dredge Channel (see Alt. 2) Allow LS = \$15,000
- Pavement marking (see Alt. 2)  $2,180 \text{ LF} \times \$1.00/\text{LF} = 2,180$
- New bridge:  $10,332 \text{ SF} \times \frac{115}{100} = \$4,033,200$  (see Sheet 1 of 5)  
1,188,180

### Alternative 3 - Option B-1 - Monument

→ Items same as Alt. 3 - Option A, except as follows:

- Obliterate old road pavement ea. end of bridge: Allow LS = \$30,000
- Construct permanent barricades at ends:  $2 \text{ Ea.} \times \$2,500 = \$5,000$
- Remove north wingwalls @ ea. abutment: Allow LS = \$15,000
- Reseal (not replace) joints in deck:  $40' \times 4 = 160 \text{ LF} \times \$10 = \$1,600$


### Alternative 3 - Option B-2 - Ped/Bike Bridge

→ Items same as Alt. 3 - Option A, except as follows:

- Patch spalled concrete in bridge deck:  $40\% \times (140' \times 24') = 1,344 \text{ SF} \times \$20 = \$26,880$   
3,360
- Construct 2-Inch Concrete Overlay:  $3,360 \text{ SF} \times \$20 = \$67,200$
- Construct new deck expansion joints:  $4 \text{ Ea.} \times \$10,000 = \$40,000$
- Remove and replace steel diaphragms:  $9,600 \text{ lb} \times \$3.00 = \$28,800$   
(see Alt. 2)
- Construct concrete filled bollards at each end of bridge:  $2 \times 6 = 12 \text{ Ea.} \times \$300 = \$3,600$

**THIS PAGE INTENTIONALLY LEFT BLANK**



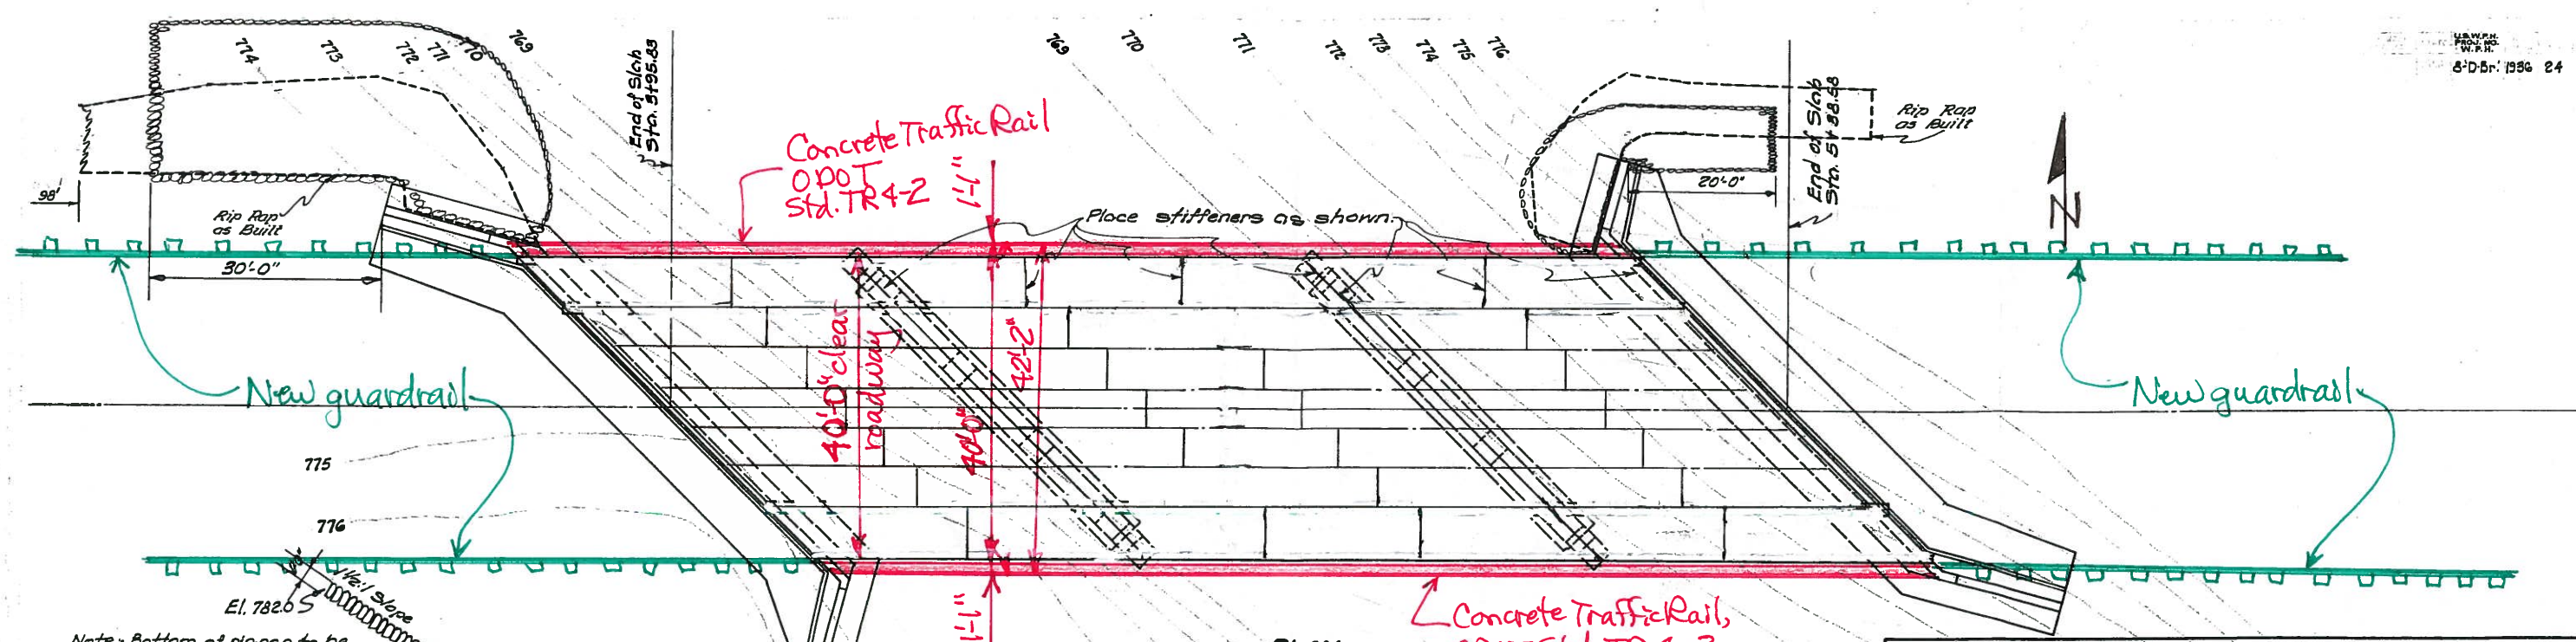

SECTION THROUGH RIPRAP  
The bridge contractor shall dig trench and riprap as shown to Elev. 763.0. Riprap will be paid for at the unit price per sq. yd. of surface regardless of thickness.


PLAN  
Alternative 2

SUMMARY OF QUANTITIES						
Item Nos.	74.07	75.55a	81.86a	81.86d	83.05	102.04
Location	Reinf. Conc. Hand Rail	Struct. Steel	Concrete. Class A	Curbs Class AA	Reinf. Steel Lbs.	Laid-Up Rip Rap Sq. Yds.
Abutments			519.8		30,620	200
Piers		142,077	753.2		13,380	
Superstructure	580	142,077	151.05	144.3	13,360	
Totals	580	142,077	670.85	144.3	43,960	200

All exposed concrete surfaces are to have a carbonundum finish. This work shall be constructed according to Okla. Std. Spec. of 1932. 60' I-beams shall be rolled with 1/4" camber. 40' I-beams shall be rolled with 3/4" camber.

For details of Superstructure see Std. IB-G, Sht. No. 28 & Sht. No. 27. Abutments see Sht. No. 25. Piers see Sht. No. 26.

Measurement of fine and coarse aggregate shall be by weight in accordance with the second & third paragraphs of Section No. 81.07. Concrete mixer shall comply with the requirements of Sec. No. 81.08. Concrete materials shall be handled as specified in Sec. No. 62.20.









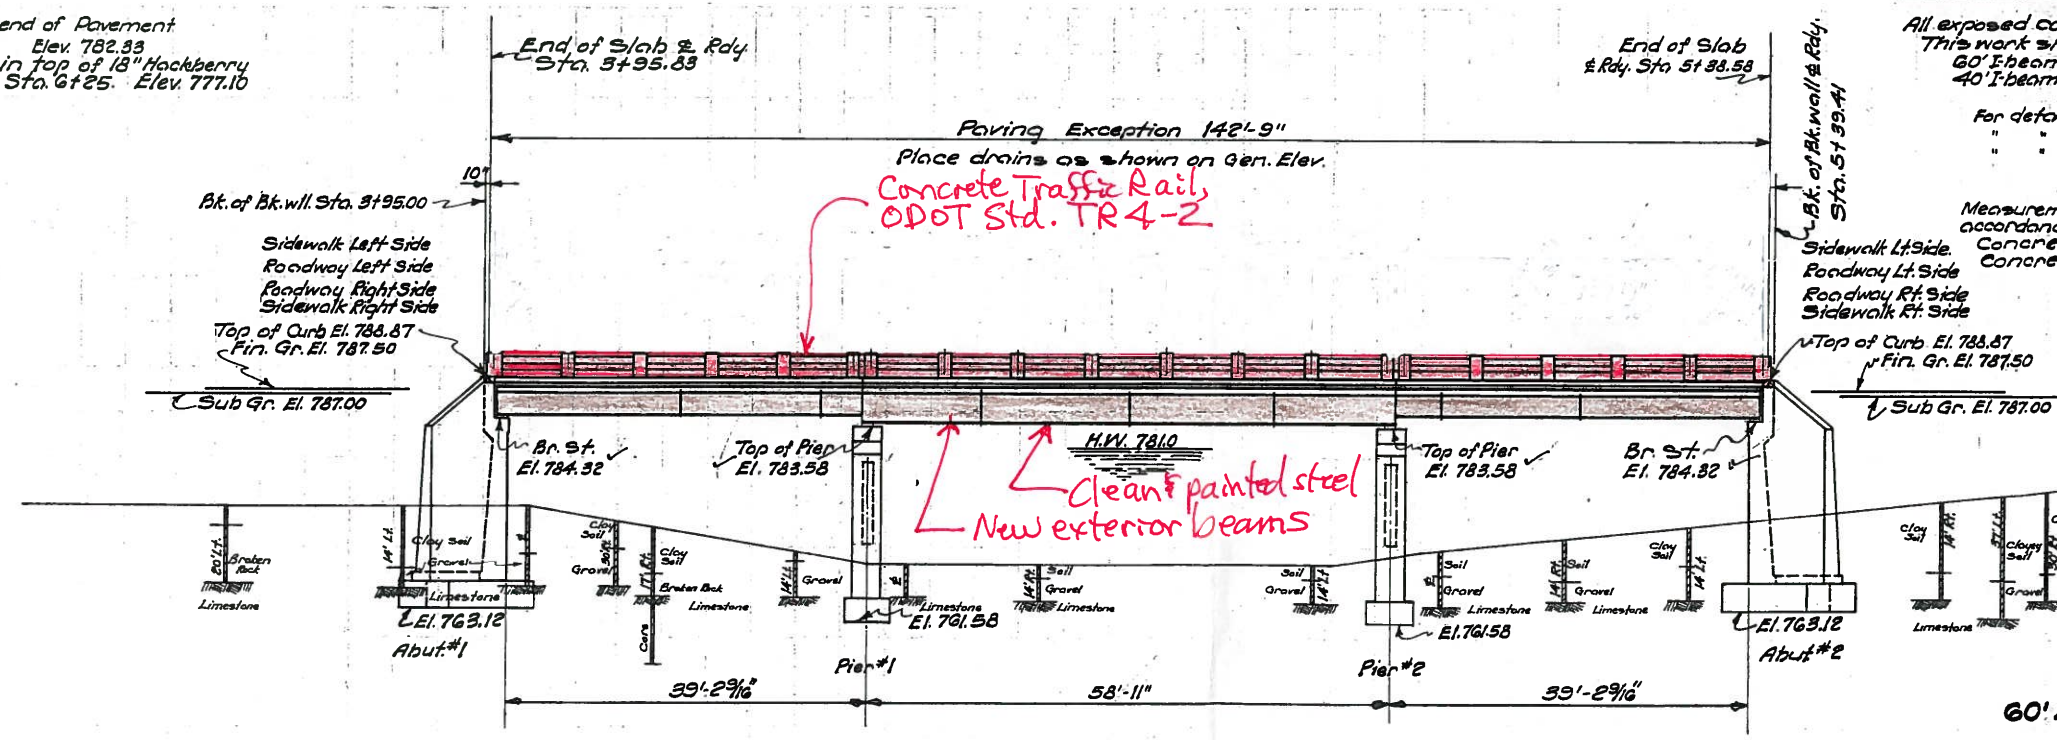


GENERAL ELEVATION  
Scale 1" = 10'-0"

REVISED AS BUILT  
HORSE CREEK  
GENERAL ELEVATION AND PLAN  
SUMMARY OF QUANTITIES  
60' AND 2-40' I.B.M. SPANS WITH 2-5'-0" SIDEWALKS  
24'-0" ROADWAY 45° SKEW RT. FWD.  
± STA. 4 + 67.21  
U.S.W.P.H. PROJ. NO. W.P.H. 8 SEC. "D-BR."

✓ DJB  
5/6/16



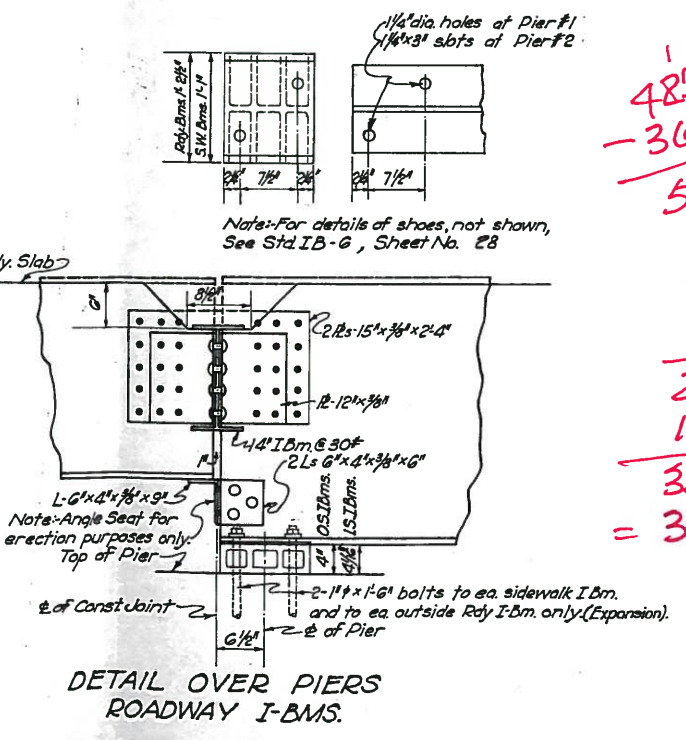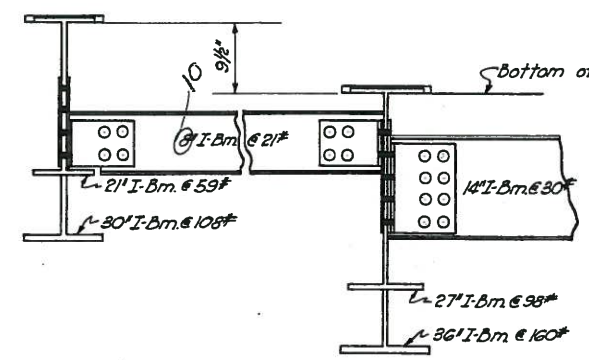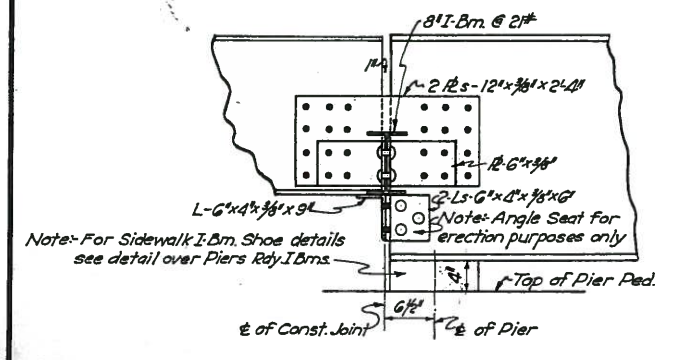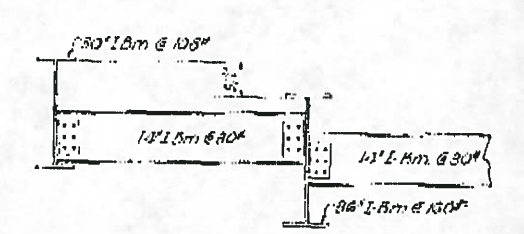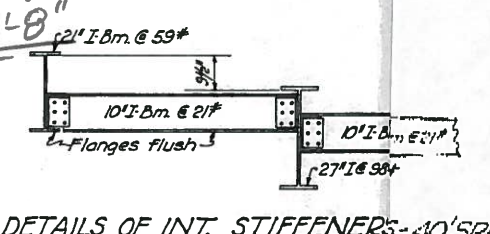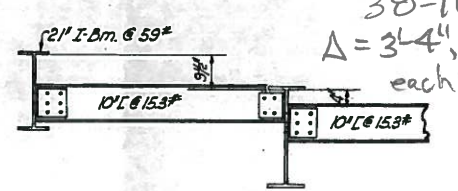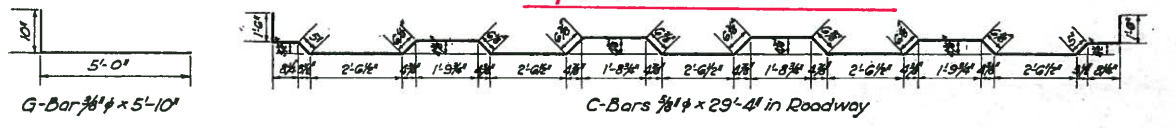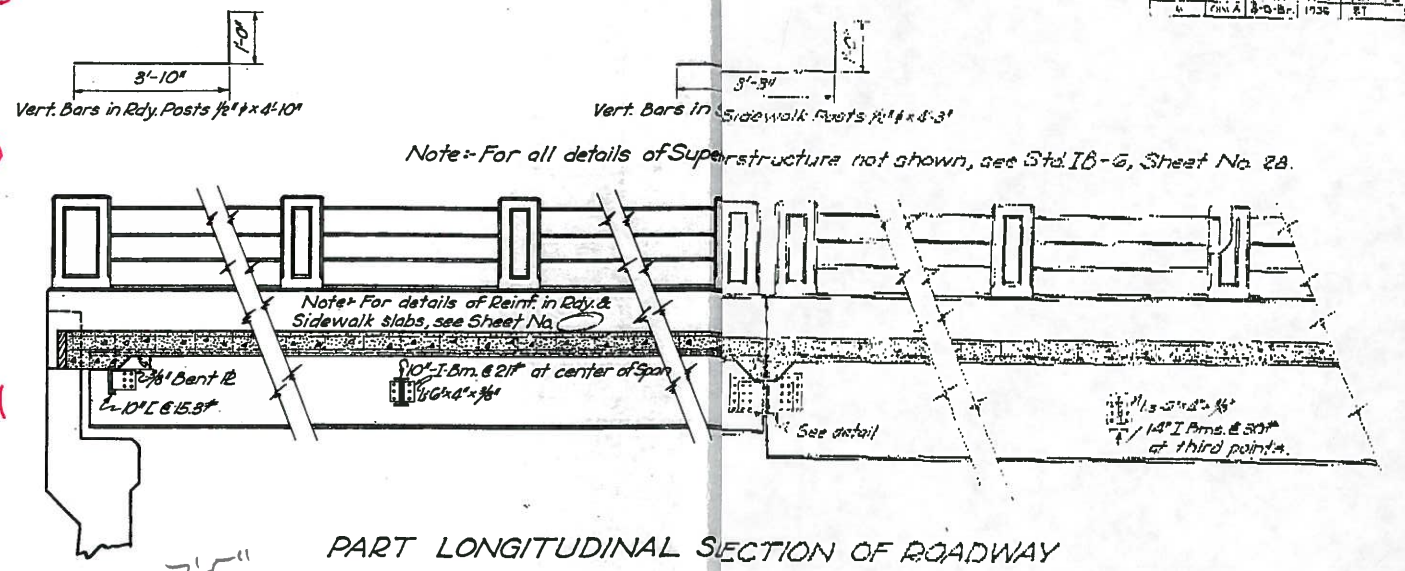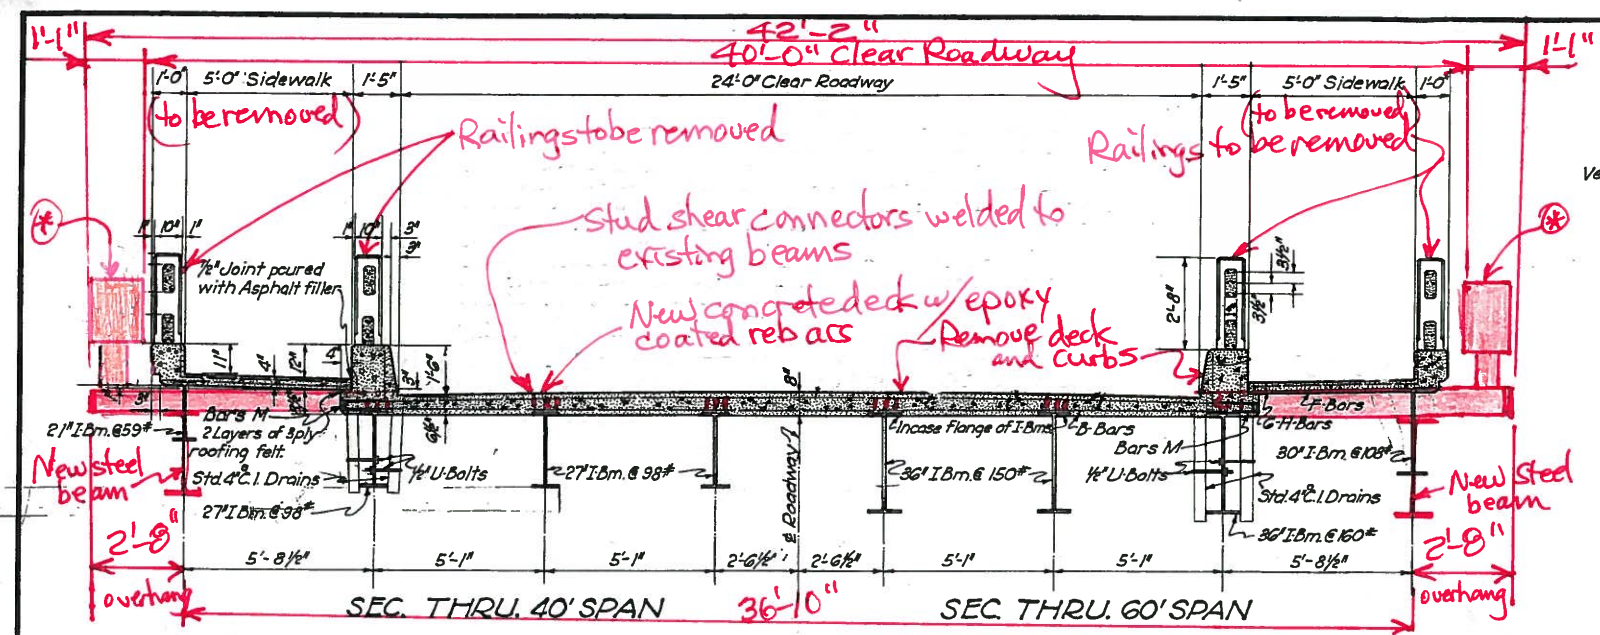

Handwritten calculations:

$$48'-2" - 36'-10" = 12'-2"$$

$$12'-2" \div 2 = 6'-1"$$

$$5'-4" \div 2 = 2'-8"$$

$$5'-1" \times 5 = 25'-5"$$

$$10'-17" = 2 \times 5'-8\frac{1}{2}"$$

$$35'-22" = 36'-10"$$

58 06-0256-X









**HORSE CREEK**  
**DETAILS OF SUPERSTRUCTURE**  
 1-60' & 2-40' I-B.M. SPANS  
 24'-0" ROADWAY & 2-5'-0" SIDEWALKS  
 SKEWED 45° RIGHT FWD.  
 STA. = 4+67.21  
 U.S.W.P.H. PROJ. NO. W.P.H. 8-SEC "D-BR."

Handwritten: ✓ DIB 5/6/16







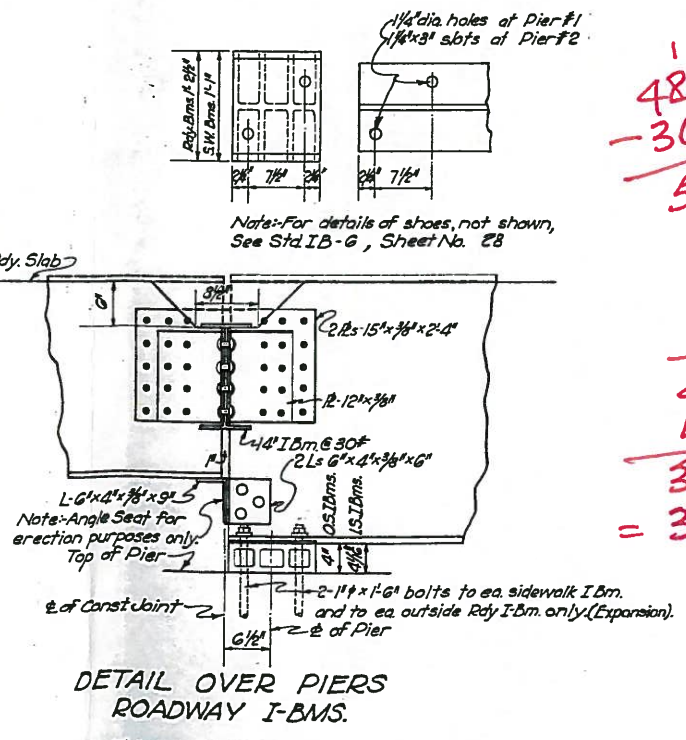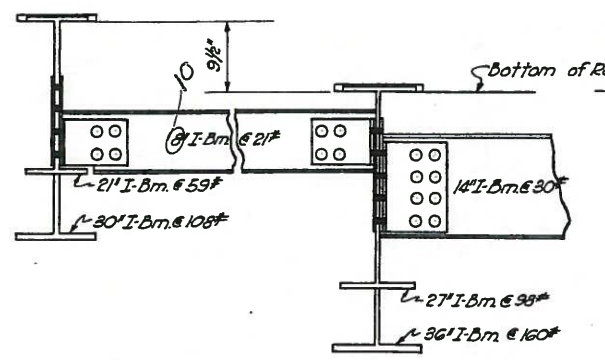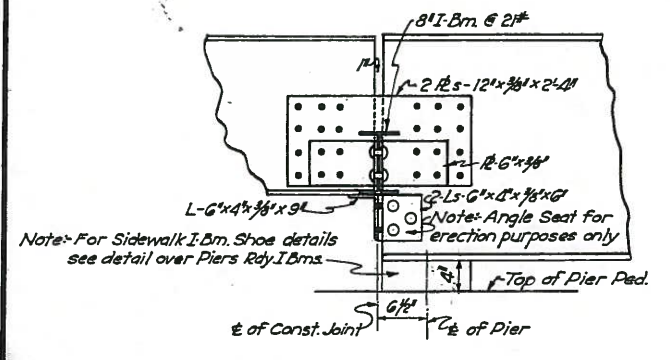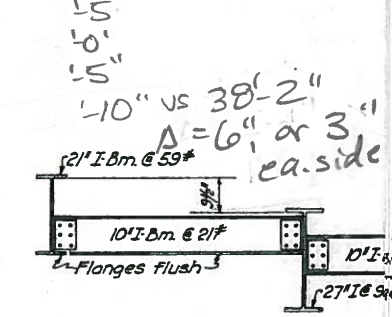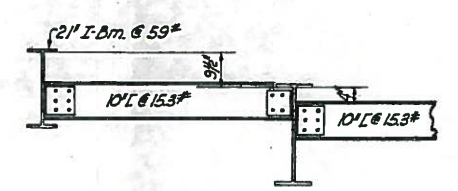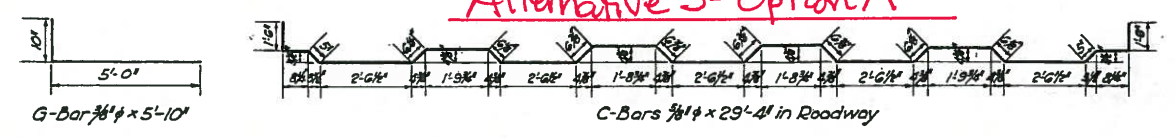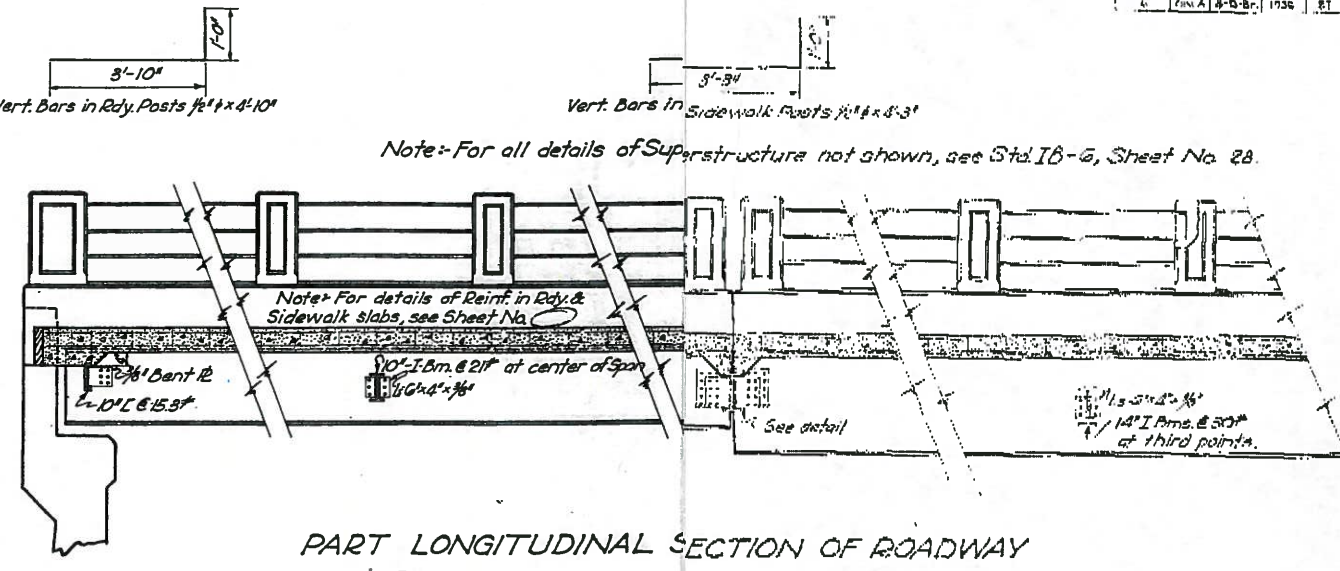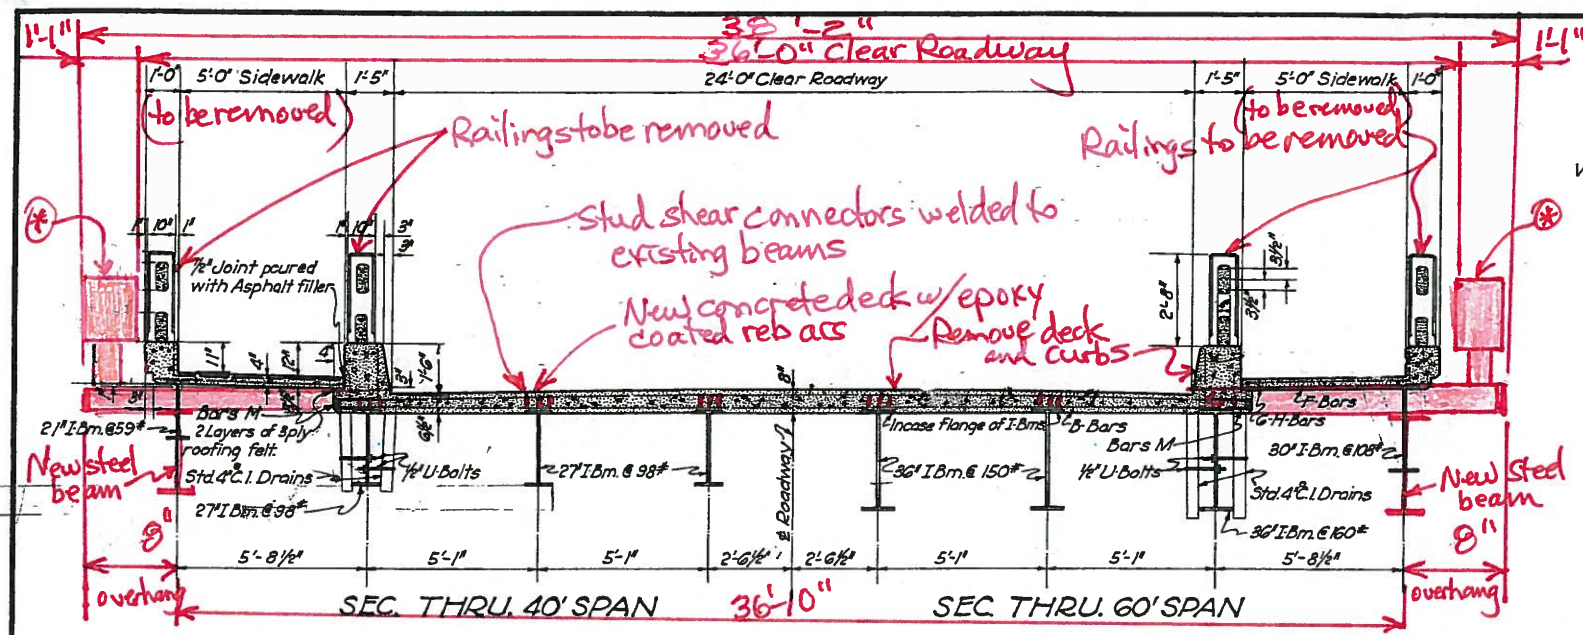

$$\begin{aligned}
 &14' - 2'' \\
 &48' - 2'' \\
 &- 36' - 10'' \\
 &\hline
 &12' - 2'' \\
 &5' - 4'' \div 2 = 2' - 8'' \text{ overhang}
 \end{aligned}$$

58 06-02.56-X

HORSE CREEK  
DETAILS OF SUPERSTRUCTURE  
1-60' & 2-40' I-BM. SPANS  
24'-0" ROADWAY & 2-5'-0" SIDEWALKS  
SKEWED 45° RIGHT FWD.  
CL STA. = 4+67.21  
U.S.W.P.H. PROJ. NO. W.P.H. 8-SEC'D-BR."

Detailed & Traced by Marsh J.L.F. May 1985

✓ DJB  
5/6/16



## Works Cited

Federal Highway Administration and Oklahoma Department of Transportation. "Design Support for Section 4(f) Analysis for Historic Bridges." 25 March 2013 (updated). Available at <http://www.environment.fhwa.dot.gov/4f/4fpolicy.pdf>.

Federal Highway Administration, Office of Planning, Environment, and Realty, Project Development and Environmental Review. "Section 4(f) Policy Paper." 20 July 2012. Available at <http://www.environment.fhwa.dot.gov/4f/4fpolicy.pdf>.

Federal Highway Administration. *Recording and Coding Guide for the Structure Inventory and Appraisal of the Nation's Bridges*, Report No. FHWA-PD-96-001. December 1995.

National Register of Historic Places, Horse Creek Bridge, Afton, Ottawa County, Oklahoma. National Register #95000040.

**THIS PAGE INTENTIONALLY LEFT BLANK**

**Appendix A. Oklahoma Department of Transportation Bridge  
Inspection Report (April 6, 2015)**

**THIS PAGE INTENTIONALLY LEFT BLANK**

# OKLAHOMA DEPARTMENT OF TRANSPORTATION -

# Bridge Inspection Report

Suff. Rating: 29.9  
SD

Health Index :  
59.7

NBI No.: 05017

Structure No.: 5806 0256 X

Local ID: -1

**DESCRIPTION:**  
40'-60'-40' I-BM. SPANS WITH 2-5' SIDEWALKS SK. 45 DEG.  
1. State: Oklahoma 2. SHD District: Division 8  
3. County Code: OTTAWA 4. Place Code: AF10N  
Admin. Area: Unknown  
5. Inventory Route (Route On Structure) : 1 - 2 - 1 - 00060 - 0  
6. Feature Intersected: HORSE CREEK  
7. Facility Carried: U.S. 60 U.S. 60  
9. Location: 2.6 MI N DELAWARE 11. Mile Post: 2.559 mi  
13. LRS Inv. Route./ Subroute.: 5806 0000 02  
16. Latitude: 36 41 48.73 17. Longitude: 094 57 24.04  
98. Border Br. Code: Unknown (P) % Resp. : 0 99. Border Br. #: Unknown

**STRUCTURE TYPE AND MATERIALS**  
43. Main Span Material and Design Type  
Steel Stringer/Girder  
44. Approach Span Material and Design Type  
Unknown (NBI) Unknown (P)  
45. No. of Spans Main Unit: 3 46. No. of Approach Spans: 0  
107. Deck Type: 1 Concrete-Cast-in-Place  
108A. Wearing Surface: 1 Monolithic Concrete  
108B. Membrane: 8 Unknown  
108C. Deck Protection: 8 Unknown

**AGE AND SERVICE**  
27. Year Built: 1936 106. Year Reconstructed: Unknown  
28A. Lanes on: 2 28B. Lanes Under: 0 19. Detour Length: 19.9 mi  
29. ADT: 6500 30. Year of ADT: 2013 109. Truck ADT %: 16  
42A. Type of Service on: 5 Highway-pedestrian  
42B. Type of Service under: 5 Waterway

**GEOMETRIC DATA**  
10. Inv. Rte. Min. Vert. Clr.: 328.1 ft  
32. Approach Roadway Width (W/ Shoulders): 24.0 ft  
Deck Area: 5,575.7 sq. ft 33. Median: 0 No median  
34. Skew: 45 35. Structure Flared: 0 No flare  
47. Inv. Rte. Total Horiz. Clr.: 24.0 ft  
48. Length Maximum Span: 60.0 ft 49. Structure Length: 143.0 ft  
50A. Curb/Sdwk Width L: 5.0 ft 50B. Curb/Sidewalk Width R: 5.0 ft  
51. Width Curb to Curb: 24.0 ft 52. Width Out to Out: 39.0 ft  
53. Minimum Vertical Clearance Over Bridge: 328.1 ft  
54A/54B. Min. Vert. Underclearance : N Feature not hwy or RR 0.0 ft  
Meas. -1 -1 -1 -1 -1 -1  
Post. DO NOT U DO NOT U DO NOT U DO NOT U DO NOT U DO NOT U  
55A/55B. Minimum Lateral Underclearance R: N Feature not hwy or RR 0.0 ft  
56. Minimum Lateral Underclearance L: 0.0 ft

**INSPECTION**  
**Type Insp Req. Insp Done Freq: Insp. Date: Next Insp.:**  
NBI: Y 24 4/6/2015 4/6/2017  
FC Freq.: N N NA NA NA  
UW Freq.: N N NA NA NA  
OS Freq.: N N NA NA NA

**CLASSIFICATION**  
12. Base Hwy Network : On Base Network 20. Toll Facility: 3 On free road  
21. Custodian: 01State Highway Agency 22. Owner: 01State Highway Agency  
26. Functional Class: 06 Rural Minor Arteri 37. Historical Sig.: 1 Br on Natl Reg Hist Pl  
100. Defense Highway: 0 Not a STRAHNET h 101. Parallel Structure: No || bridge exists  
102. Dir. of Traffic: 2 2-way traffic 103. Temp. Structure: Not Applicable (P)  
104. Highway System: 0 Not on NHS 105. Fed. Land Hwy 0 N/A (NBI)  
110. National Truck Network: 0 Not part of na 112. NBIS Length: Long Enough

**CONDITION**  
58. Deck: 3 Serious 59. Super.: 4 Poor 60. Sub.: 5 Fair  
62. Culvert: N N/A (NBI) 61. Channel/Channel Protection: 7 Minor Damage  
Flowline Notes:  
Flowline/ high water = 24ft. Channel under ctr span.

**LOAD RATING AND POSTING**  
31. Design Load: 4 M 18 (H 20) 41. Posting status: A Open, no restriction  
63. Op. Rating Method: 1 LF Load Factor-Ton Alt. Op. Rating Meth.: 1 LF Load Factor-To  
64. Operating Rating (H / HS / 3-3) : 35.2 49.6 78.6  
66. Inventory Rating (H / HS / 3-3) : 21.0 29.8 47.1  
65. Inv. Rating Method: 1 LF Load Factor-Ton Alt. Inv. Rating Meth.: 1 LF Load Factor-To  
70. Posting: 5 At/Above Legal Loads Date Rated : 8/1/2006

**PROPOSED IMPROVEMENTS**  
94. Bridge Cost: \$1,089,056 75. Type of Work: 31 Repl-Load Capacit  
95. Roadway Cost: \$1,796,942 76. Lgth. of Improvment: 247.1 ft  
96. Total Cost: \$3,049,356 114. Future ADT: 10400  
97. Year of Cost Est.: 2009 115. Year of Future ADT: 2033

**NAVIGATION DATA**  
38. Navigation Control: Permit Not Required  
39. Vertical Clearance: 0.0 ft 40. Horizontal Clearance: 0.0 ft  
111. Pier Protection: 1 Not Required 116. Lift Bridge Vert. Clear.: 0.0 ft

**APPRAISAL**  
36A. Bridge Rail: 0 Substandard 36C. Approach Rail: 0 Substandard  
36B. Transition: 0 Substandard 36D. Approach Rail Ends: 0 Substandard  
67. Str. Evaluation: 4 Minimum Tolerable 68. Deck Geometry: 2 Intolerable - Replace  
69. Underclearance, Vertical and Horizontal: N Not applicable (NBI)  
71. Waterway Adequacy: 7 Above Minimum  
72. Approach Alignment: 8 Equal Desirable Crit  
113. Scour Critical: 8 Stable Above Footing

200c. Temperature: 60  
200d. Weather: CLOUDY  
201. Structural Steel ASTM Desig.: -1 -1  
202. Waterproof Membrane : -1  
Date Installed : 1/1/1901  
203. Type Exp. Dev. : Pourable  
204. Type of Handrail: Concrete Post and Rails  
205. Material and Quantity : 710.0  
208. Type of Abutment : Cantilever  
Type of Foundation : Natural Foundation Matl.  
209. Type of Pier / Found.: 4 Yes  
Concrete Piling  
210. Foundation Elev. -1.0 7616.0  
-1.0 -1.0 -1.0  
211. Wear. Surf. Prot. System : None  
Date Installed : 1/1/1901  
213. Utilities Attached : -1  
-1 -1 -1  
-1 -1 -1

214a. Posted Weight Limit: NR  
b. Posted Speed Limit : 35  
c. Narrow/One Lane Bridge sign : N  
d. Vertical Clearance Sign: NO  
Advanced Warning Sign : NO  
Min. Measured Clearance : -1  
Max. Measured Clearance : -1  
e. Navigation Lights : -  
Working/Not Working : -  
215. Overpass : C - US Highway  
221. Substructure Cond. (U/W) : -  
222. Fill over RCB: 0  
223. Appr. Slab/Rdwy Cond.: Satisfactory  
224. Critical Feature Type: -1  
225. Paint Type : Red Lead Ready  
Overcoat : 9  
226. Date Painted: 2000  
227. Paint Coloring: Red  
233. Deck Forming: Conventional Forming  
236. Deck Cleaning : -1  
238. School Bus Rte: Current and Desired Route  
240. Appr. Roadway Type: Asphalt/Bituminous

243. Girder Spacing/Number : -1.0 / -1  
244. Span Lengths :  
40 -1 -1  
60 -1 -1  
40 -1  
245. Girder Depth : -1.000  
246. Type of Overlay : -  
246. Overlay Thickness : -1.0  
246. Overlay Date : 1/1/1901  
246. Overlay Depth Changed > 1"? -  
247. Protective Systems : 1: -  
2: - 3: -  
4: - 5: -  
248. No. of Field Splices w/ Corrosion : -1  
249. Scour Crit. POA exists?: No  
250. Culvert Headwall Dist.: -1.0  
254. Thru Truss Type : -  
256. Chan. Profile Up/Down Stream?: Up  
257a. OkiePROS Auto. Truck Routing Yes  
258. Plans w/ found. are in file at ODOT  
259. Scour Eval. is in file at ODOT  
263. Interchange at Intersection N  
264. Interstate Milepoint -1.00

# OKLAHOMA DEPARTMENT OF TRANSPORTATION -

# Bridge Inspection Report

Suff. Rating: 29.9  
SD

Health Index :  
59.7

NBI No.: **05017**      Structure No.: 5806 0256 X      Local ID: -1

Inspection Date: 4/6/2015      Reported By: UFD8003

Invoice No.: -1      Inspected With: -1

Agency :

## Structure / Inspection Notes

FX:SEVERAL DIAPHRAGMS SEVERE SECTION LOSS & SEVERAL COMPLETELY DETERIATED.

Elm.	Env.	Description	Un.	Qty.	Qty.St. 1	% 1	Qty.St. 2	% 2	Qty.St. 3	% 3	Qty.St. 4	% 4	Qty.St. 5	% 5
12	4	Reinforced Concrete Deck	(SF)	3,432	0	0 %	0	0 %	3,432	100 %	0	0 %	0	0 %
107	4	Steel Open Girder Beam	(LF)	771	0	0 %	771	100 %	0	0 %	0	0 %	0	0 %
205	4	Reinforced Conc Column or Pile Extension	(EA)	8	0	0 %	8	100 %	0	0 %	0	0 %	0	0 %
210	4	Reinforced Conc Pier Wall	(LF)	79	0	0 %	79	100 %	0	0 %	0	0 %	0	0 %
215	4	Reinforced Conc Abutment	(LF)	112	0	0 %	108	96 %	4	4 %	0	0 %	0	0 %
234	4	Reinforced Conc Cap	(LF)	112	0	0 %	110	98 %	2	2 %	0	0 %	0	0 %
301	4	Pourable Joint Seal	(LF)	187	0	0 %	0	0 %	0	0 %	187	100 %	0	0 %
311	4	Moveable Bearing (roller, sliding, etc.)	(EA)	14	0	0 %	12	86 %	0	0 %	2	14 %	0	0 %
313	4	Fixed Bearing	(EA)	14	0	0 %	11	79 %	0	0 %	3	21 %	0	0 %
515	4	Steel (Superstructure) Protective Coating	(SF)	3,362	0	0 %	3,362	100 %	0	0 %	0	0 %	0	0 %
859	4	Soffit of Concrete Decks and Slabs	(EA)	1	0	0 %	0	0 %	1	100 %	0	0 %	0	0 %
865	4	Steel Open Girder/Beam End (5 Ft.)	(LF)	210	0	0 %	60	29 %	150	71 %	0	0 %	0	0 %
958	4	Concrete Cracking	(EA)	1	0	0 %	1	100 %	0	0 %	0	0 %	0	0 %
963	4	Steel Section Loss	(EA)	1	0	0 %	1	100 %	0	0 %	0	0 %	0	0 %

Additional  
Elements

Elem.	Element Notes (Include Size and Location of Deterioration)
12	FX:Several Patched areas,spalls & Impending potholes w/ exposed rebar.Note:Deck makes chatter noise upon Impact.
107	< none >
205	< none >
210	< none >
215	FX:E.ABUT. MODERATE DIAG.CRACKS W/EFFLORESCENCE S.E.COR. AND W.ABUT SPALLS W/ EXPOSED REBAR & CRACKS W/ EFFLOR.
234	< none >
301	PX:Exp.Jts.have failed sidewalk areas,others failing.
311	FX: BEARINGS HAVE MODERATE to HEAVY CORROSSION.
313	FX: BEARINGS HAVE MODERATE to HEAVY CORROSSION.
515	FX:PAINT FAILED @ BM.ENDS.
859	FX:SOFFIT FALSEWORK,SEVERAL SPALLS REBAR EXPOSED,CRACKS WITH EFFLOR.THROUGHOUT.
865	FX: BEAM ENDS HAVE MODERATE SECTION LOSS. NOTE: ENDS HAVE WELDED ANGLES.
958	FX:MOD.DECK CRACKS.
963	PX: SECTION LOSS AT BEAM ENDS AND BEARINGS.

## Channel Profile

	Baseline	1	2	3	4	5	6	7	8	9	10	11	12	13	14	15
Distance	0	70.0	-1.0	-1.0	-1.0	-1.0	-1.0	-1.0	-1.0	-1.0	-1.0	-1.0	-1.0	-1.0	-1.0	-1.0
Profile		24.0	-1.0	-1.0	-1.0	-1.0	-1.0	-1.0	-1.0	-1.0	-1.0	-1.0	-1.0	-1.0	-1.0	-1.0
Event	Flowline	-	-	-	-	-	-	-	-	-	-	-	-	-	-	-

## **Appendix B.     Project Location Map**

**THIS PAGE INTENTIONALLY LEFT BLANK**





**THIS PAGE INTENTIONALLY LEFT BLANK**

## **Appendix C.     Photographs (April 2016)**

**THIS PAGE INTENTIONALLY LEFT BLANK**



*Photo 1. US 60 west roadway approach to the bridge, looking east.*



*Photo 2. South side of bridge; note sanitary sewer manhole and drainage swale.*





*Photo 3. South side of Span 2 and Pier 2; unknown vertical pipe attached to bridge.*



*Photo 4. East abutment, south wingwall, cracking and spalling with efflorescence.*



*Photo 5. Underside of bridge deck at west abutment; note severely deteriorated steel diaphragm, spalled concrete deck with exposed rebar, and failed deck joint.*



*Photo 6. Underside of bridge deck at Pier 1; note severely deteriorated steel diaphragm, spalled concrete deck with exposed rebar, and failed deck joint.*





*Photo 7. West end of bridge, south side at end of sidewalk, showing concrete railings.*



*Photo 8. Condition of bridge deck, looking east from west end of bridge; note patched concrete, potholes, and failed deck joints.*





*Photo 9. Failed joint between bridge deck and roadway at west end of bridge.*



*Photo 10. Horse Creek waterway channel under westerly span of bridge; note sediment and soil buildup, reducing waterway opening.*



*Photo 11. View looking upstream (north) of Horse Creek from north side of bridge.*



*Photo 12. Repaired concrete bridge railing; note color and texture of repaired section compared to original railing.*





*Photo 13. Repaired concrete railing post; note color and texture of repaired post compared to original post.*



*Photo 14. Underside of bridge deck at east abutment; note plywood used to form underside of concrete patch in deck; also note supplemental steel support under steel diaphragm.*



*Photo 15. US 60 east roadway approach to the bridge, looking west.*



*Photo 16. Condition of bridge deck at east abutment, south side; note patched and potholed concrete and failed deck joint.*



*Photo 17. View looking downstream (south) of Horse Creek from south side of bridge.*

**THIS PAGE INTENTIONALLY LEFT BLANK**

**Appendix D.      1935 Design Plans for U.S. Highway 60 and Horse  
Creek Bridge (Select Sheets)**

**THIS PAGE INTENTIONALLY LEFT BLANK**



CHIEF DRAFTER	LOCATING ENGR.	BRIDGE ENGR.	DIVISION ENGR.	U. S. P. H.
<i>W.H.K.</i> 8/24/35	HSE	H.W.	ADW	JSL

FED. ROAD DIST. NO.	STATE	U.S.W.P. PROJ. NO.	FISCAL YEAR	SHEET NO.	TOTAL SHEETS
6	OKLA.	W.P.H. 8 D.	1936	1	53

REVISED AS BUILT Aug-1936

## INDEX OF SHEETS

SHEET NO. 1	TITLE PAGE
" 2	TYPICAL GRADING SECTION 36' RDY.
" 3	OKLA. STATE HIGHWAY COMM. STDS.
" 4	SUMMARY SHEET & TYPICAL SURFACING SECTION
" 5-16	PLAN & PROFILE SHEETS <i>254</i>
" 17	STD. MANHOLE FRAME & COVER
" 18	STD. REINF. CONC. CULV. DES. C.P.2
" 19	" " " " " " B.C.5
" 20	" " " " " " B.C.5 <sub>2</sub>
" 21	" " " " " " B.C.5A <sub>2</sub>
" 22	" " " " " " B.C.5A <sub>2</sub>
" 23	" " " " " " B.C.6
" 24	GENERAL ELEV. & PLAN-SUMMARY OF QUANTITIES FOR 1-60' & 2-40' I-BM. SPANS 24' RDY. WITH 2-5' 0" SIDEWALKS-SKEWED 45° RT. FWD.
" 25	DETAILS OF ABUTMENTS
" 26	" " PIERS & RDY.
" 27	" " SUPER STRUCTURE
" 28	STD. 18-6
" 29	STD. MANHOLE
" 30-53	CROSS SECTIONS

## STATE OF OKLAHOMA DEPARTMENT OF HIGHWAYS

# PLAN AND PROFILE OF PROPOSED STATE HIGHWAY

U.S. WORKS PROGRAM HY. PROJ. NO. W.P.H. 8 D (1936)

U.S. HIGHWAY NO. 66.

*58-02 & 06*

## OTTAWA COUNTY


GRADE CROSSINGS	1
GRADE CROSSINGS ELIMINATED	1
BY SEPARATION OVERPASS	1
UNDERPASS	0
BY RELOCATION	0
GRADE CROSSINGS REMAINING	0

## SCALES

PLAN 1"=100'  
PROFILE HOR. 1"=100'  
VER. 1"=10'  
CROSS SECTIONS 1"=5'  
LAYOUT MAP 1"=5000'

## CONVENTIONAL SIGNS

	PROPOSED ROAD
	RAILROADS
	RANGE & TOWNSHIP LINES
	SECTION LINES
	QUARTER SECTION LINES
	FENCES
	BASE LINE
	RIGHT-OF-WAY LINES
	GROUND LINES
	GRADE LINE
	TRAVELLED ROADS
	CULVERTS & BRIDGES
	TELEPHONE & TELEGRAPH
	POWER LINES
	BUILDINGS
	UNLOADING POINTS
	OIL WELLS

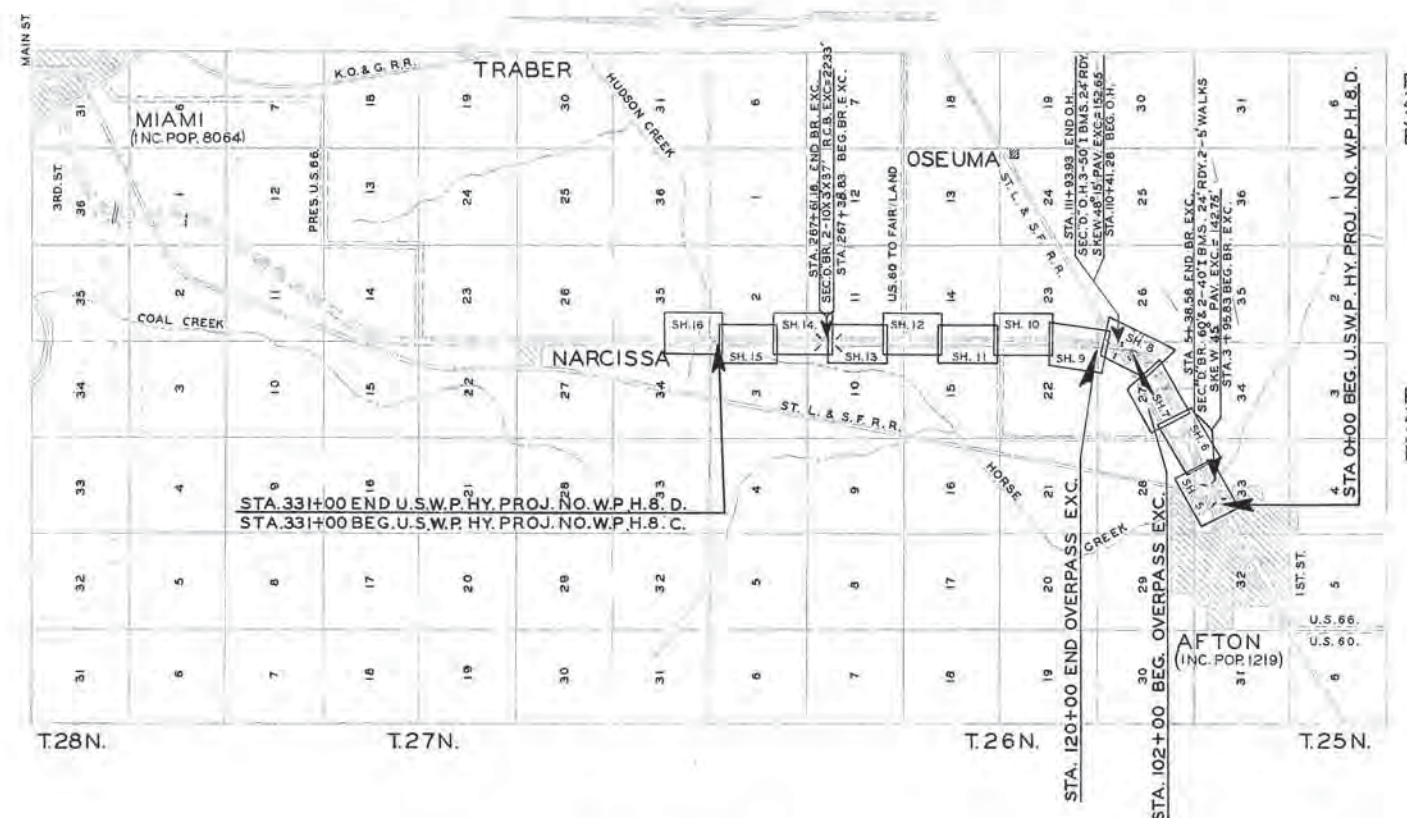

ROADWAY LENGTH-----31134.92 FT.-----5.896 MI.  
BRIDGE LENGTH-----165.08 FT.-----0.031 MI.  
PROJECT LENGTH-----5.927 MI.

EXCEPTIONS STA. 102+00 TO STA. 120+00 (OVERPASS) 1800 FT.  
EQUATIONS- NONE.

EXAMINED AND APPROVED This <input type="text"/> Day of <input type="text"/> 1935 DIVISION ENGINEER	EXAMINED AND APPROVED This <input type="text"/> Day of <input type="text"/> 1935 ENGINEER OF DESIGN
EXAMINED AND APPROVED This <input type="text"/> Day of <input type="text"/> 1935 STATE HIGHWAY ENGINEER	EXAMINED AND APPROVED This <input type="text"/> Day of <input type="text"/> 1935 CHAIRMAN STATE HIGHWAY COMMISSION
RECOMMENDED FOR APPROVAL This <input type="text"/> Day of <input type="text"/> 1935 SENIOR HIGHWAY ENGINEER BUREAU OF PUBLIC ROADS	RECOMMENDED FOR APPROVAL This <input type="text"/> Day of <input type="text"/> 1935 DISTRICT ENGINEER BUREAU OF PUBLIC ROADS
RECOMMENDED FOR APPROVAL This <input type="text"/> Day of <input type="text"/> 1935 CHIEF ENGINEER BUREAU OF PUBLIC ROADS	APPROVED This <input type="text"/> Day of <input type="text"/> 1935 CHIEF OF BUREAU OF PUBLIC ROADS

W.P.H. SPECIAL PROVISIONS GOVERN  
STATE STANDARD SPECIFICATIONS GOVERN APPROVED DEC. 1932



SUMMARY SHEET

U.S. WORKS PROGRAM HIGHWAY PROJ. NO. W.P.H. 8 D.

FILE NO. STATE U.S.W.P. FISCAL SHEET TOTAL  
DIST. NO. YEAR NO. SHEETS  
9 OKLA. W.P.H. 8-D 1936 4 53  
Revised as Built Aug-1936

SUMMARY OF GRADING QUANTITIES


P. & S. Sheet No.	Station To Station	Embankment +10 % C. Y.	Excavation			Wire Cable Guard Rail Setting C. Y.	Ponding & Overhaul Sta. Yds.	4" Lip Curb Lin. Ft.	Lip Curb Drains		Additional 4" Diarn. Vertical Manhole 4' deep Feet of With Fr. Manhole & Cover Each	Remove Asph. Top and Conc. Base S. Y.
			Class A	Class B	Class C				Class AA Conc. C. Y.	Reinf. Steel Lbs.		
5	0+00 ~ 26+00	33,640.2	33,640.2									
6	26+00 ~ 36+00	7,496.6	7,496.6									
7	36+00 ~ 102+00	12,754.5	12,754.5									
8	Sec. D. Overpass Exception											
9	120+00 ~ 140+00	5,379.9	5,379.9									
10	140+00 ~ 176+00	9,207.9	9,207.9									
11	176+00 ~ 206+00	9,653.4	9,653.4									
12	206+00 ~ 236+00	7,627.7	7,627.7									
13	236+00 ~ 266+00	6,461.8	5,933.9	515.2	134							
14	266+00 ~ 296+00	7,753.5	7,753.5									
15-16	296+00 ~ 331+00	8,052.3	6,760.7	954.1	337.5							
Total Sec. D. Rdy.		102,030.3	106,210.4	1,469.1	350.8					18.5	2	16,568.0

SUMMARY OF DRAINAGE STRUCTURES

Structure No.	P. & S. Sheet No.	Station	Description	Design	Design Sheet No.	Class A Concrete C. Y.	Reinf. Steel Lbs.	R. C. Pipe Lin. Ft.				D. A. Acres C.	Remarks
								15"	18"	24"	30"		
1	5	4+672	Sec. D. Bridge										In Place
2	5	10+00	3x3x35' Rdy. R.C.B.	B.C. 6	23	9.03	1695					17.54	0.8
3	5-6	25+40	15'x15' Rdy. R.C.P.-S.D. Lt. No HdW's.	C.P. 2	18			15				14	0.8
4	6	39+07	30x38-4' Rdy. R.C.P. 45° Wings	C.P. 2	18	2.77	62				40	10	0.6
5	6	39+75	4x2x36' Rdy. R.C.B.	B.C. 5a	20	15.08	1361					30	0.6
6	7	59+75	2-8x3x36' " "	B.C. 5a	22	68.59	6356					226	0.8
7	7	82+70	2x2x41' " "	B.C. 5a	20	11.19	987					11	0.6
8	9	139+06	18'x18' Rdy. R.C.P.-S.D. Rt. No HdW's.	C.P. 2	18								
9	10	156+00	6x2x10' Rdy. R.C.B.	B.C. 5a	20	23.62	2170					60	0.6
10	10	172+65	3x2x140' Rdy. R.C.B.-S.D. Lt.	B.C. 5	19	34.39	3401					15	0.6
11	10	172+65	24'x26'-4" R.C.P.-S.D. Rt. 90° W.	C.P. 2	18	4.38	52			28		Small	0.6
12	11	185+65	5x4x36' Rdy. R.C.B.	B.C. 5	19	25.15	2003					115	0.6
13	11	188+50	Extend 18' Rt. 8c. 12' Lt.	B.C. 5a	21	38.10	3297					530	0.6
14	11	193+50	18'x21' Rdy. R.C.P.-S.D. Lt. No HdW's.	C.P. 2	18			21					
15	12	208+22	4x3x36' Rdy. R.C.B.	B.C. 5a	20	18.30	1572					45	0.6
16	12	208+88	30'x20' R.C.P.-S.D. Rt. No HdW's.	C.P. 2	18					20		130	0.6
17	12	223+16	8x3x36' Rdy. R.C.B.	B.C. 5	19	33.78	3181					20	0.8
18	12	225+78	3x2x30' Rdy. R.C.B.-S.D. Lt.	B.C. 5	19	9.97	874						
19	13	243+81	15'x21' R.C.P.-S.D. Lt. No HdW's.	C.P. 2	18			21					
20	13	254+08	15'x21' " S.D. Rt. " "	"	18								
21	13	256+66	15'x21' " S.D. Lt. " "	"	18								
22	13	260+	10x3x39-4' Rdy. R.C.B.	B.C. 5a	20	47.23	4551					190	0.6
23	14	267+50	Sec. D. Bridge									310	0.8
24	14	270+13	Divert										
25	14	272+68	Divert										
26	14	278+56	18'x31'-4' Rdy. R.C.P.-S.D. Rt. 90° W.	C.P. 2	18	2.98	42			33		3	0.8
27	14	278+56	3x2x30' Rdy. R.C.B.-S.D. Lt.	B.C. 5	19	9.97	874					20	0.6
28	15	311+45	15'x21' R.C.P.-S.D. Rt. No HdW's.	C.P. 2	18			21					
29	15	304+50	15'x21' " " Lt. " "	"	18			21					
30	15	319+80	2-8x3x36' Rdy. R.C.B.	B.C. 5a	22	65.77	6073					250	0.8
31	15	323+90	15'x21' Rdy. R.C.P.-S.D. Lt. No HdW's.	C.P. 2	18			21					In Place

SUMMARY OF STRUCTURES OVER 20'

Structure No.	P. & S. Sheet No.	Station	Description	Design	Design Sheet No.	Reinf. Conc. Structural		Concrete C. Y.			Reinforcing Laid Lip	
						Hand Rail Lin. Ft.	Steel Lbs.	Class A	Class A Pier Base	Class AA	Steel Lbs.	Rip-Rap Sq. Yds.
1	5	4+672	60' & 2-40' I-Bm. Spans With 2-5'-0" Sidewalks 24' Rdy. 45° Skew R.C. P.W.	IB-G	24-25-26 27-28	580	142,077	670.85		144.3	63,360	356.4
23	14	267+50	2-10x3x37' Rdy. R.C.B.	B.C. 5a2	21			82.57			7987	
Total Sec. D. Bridges						580	142,077	753.42		144.3	71,347	356.4

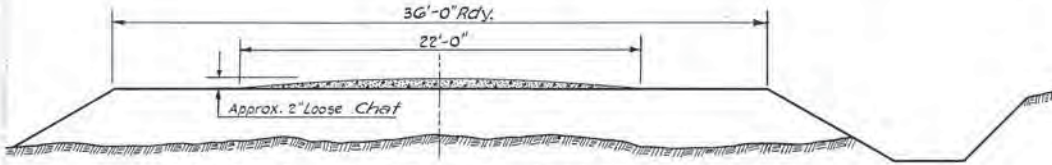

TYPICAL CHAT SECTION 36'-0" RDY.

CONSTRUCTION NOTE  
The grade shall be bladed to a uniform surface conforming to the typical section shown on the plans and the existing grade line prior to placing Chat.  
The approved Chat Material shall then be deposited on the road at the uniform rate of nine & one-half (9 1/2) Cu. Yds. per station, and bladed over the proposed grade to conform to the proposed Chat Section.  
(On the completion of the Chat Surfacing, the entire project shall be bladed to conform to the proposed cross section prior to final acceptance)  
Chat Material shall be measured by the Cu. Yd. in the Vehicle, at the point where it is to be dumped on the Road.

Total Sec. D. Rdy. 430.30 38,551 120 93 28 60

SUMMARY OF PAY QUANTITIES


Section	Unit	Excavation C.Y.			Rolling Hours	Sprinkling 1000 Gal.	Surfacing S.Y.		Reinf. Conc. Struct.		Concrete C.Y.			Reinf. Steel Lbs.	Reinf. Conc. Pipe L.F.					Laid Up Rip-Rap S.Y.	Wire Cable		Removal of Asph. Top and Conc. Base Sq. Yds.	Additional Vertical Manhole Feet Vert. Ft.	4" Diarn. Manhole deep with Fr. & Cover Each	Chat Surfacing C.Y.	
		Class "A"	Class "B"	Class "C"			R.C. Paving	Reinf. Conc. Appr. Slab	4" Lip Curb L.F.	Steel Lbs.	Class "A" Pier Base	Class "AA"	15"		18"	24"	30"	12" Corr. Iron Pipe L.F.	Guard Rail Lin. Ft.		Monuments Each						
Item No		10.14a	10.14b	10.14c	10.14e	10.14f	Spec.	Spec.	Spec.	74.07	75.55a	81.26a	81.26d	83.05	84.15a	84.15b	84.15c	84.15d	85.25	102.04	106.06a	108.04	Spec.	Spec.	Spec.	Spec.	
D. Rdy.	2	106,210.4	1469.1	350.8	729.	412.5						430.30		38,551	120	93	28	60					16,568.0	18.5	2	3059.9	
D. Bridge	2									580	142,077	753.42		144.3	71,347					356.4							2.1

\*Based on 20 hrs. per 1000 C. Y. of Embankment  
\*Based on 30 Gal. per C. Y. of Embankment

\*Old Paving removed shall be piled neatly at places designated by the Resident Engineer along the right of way and shall remain the property of the State.

\*Based on 2" Loose Chat  
And Includes 832 C.Y. For Intersection



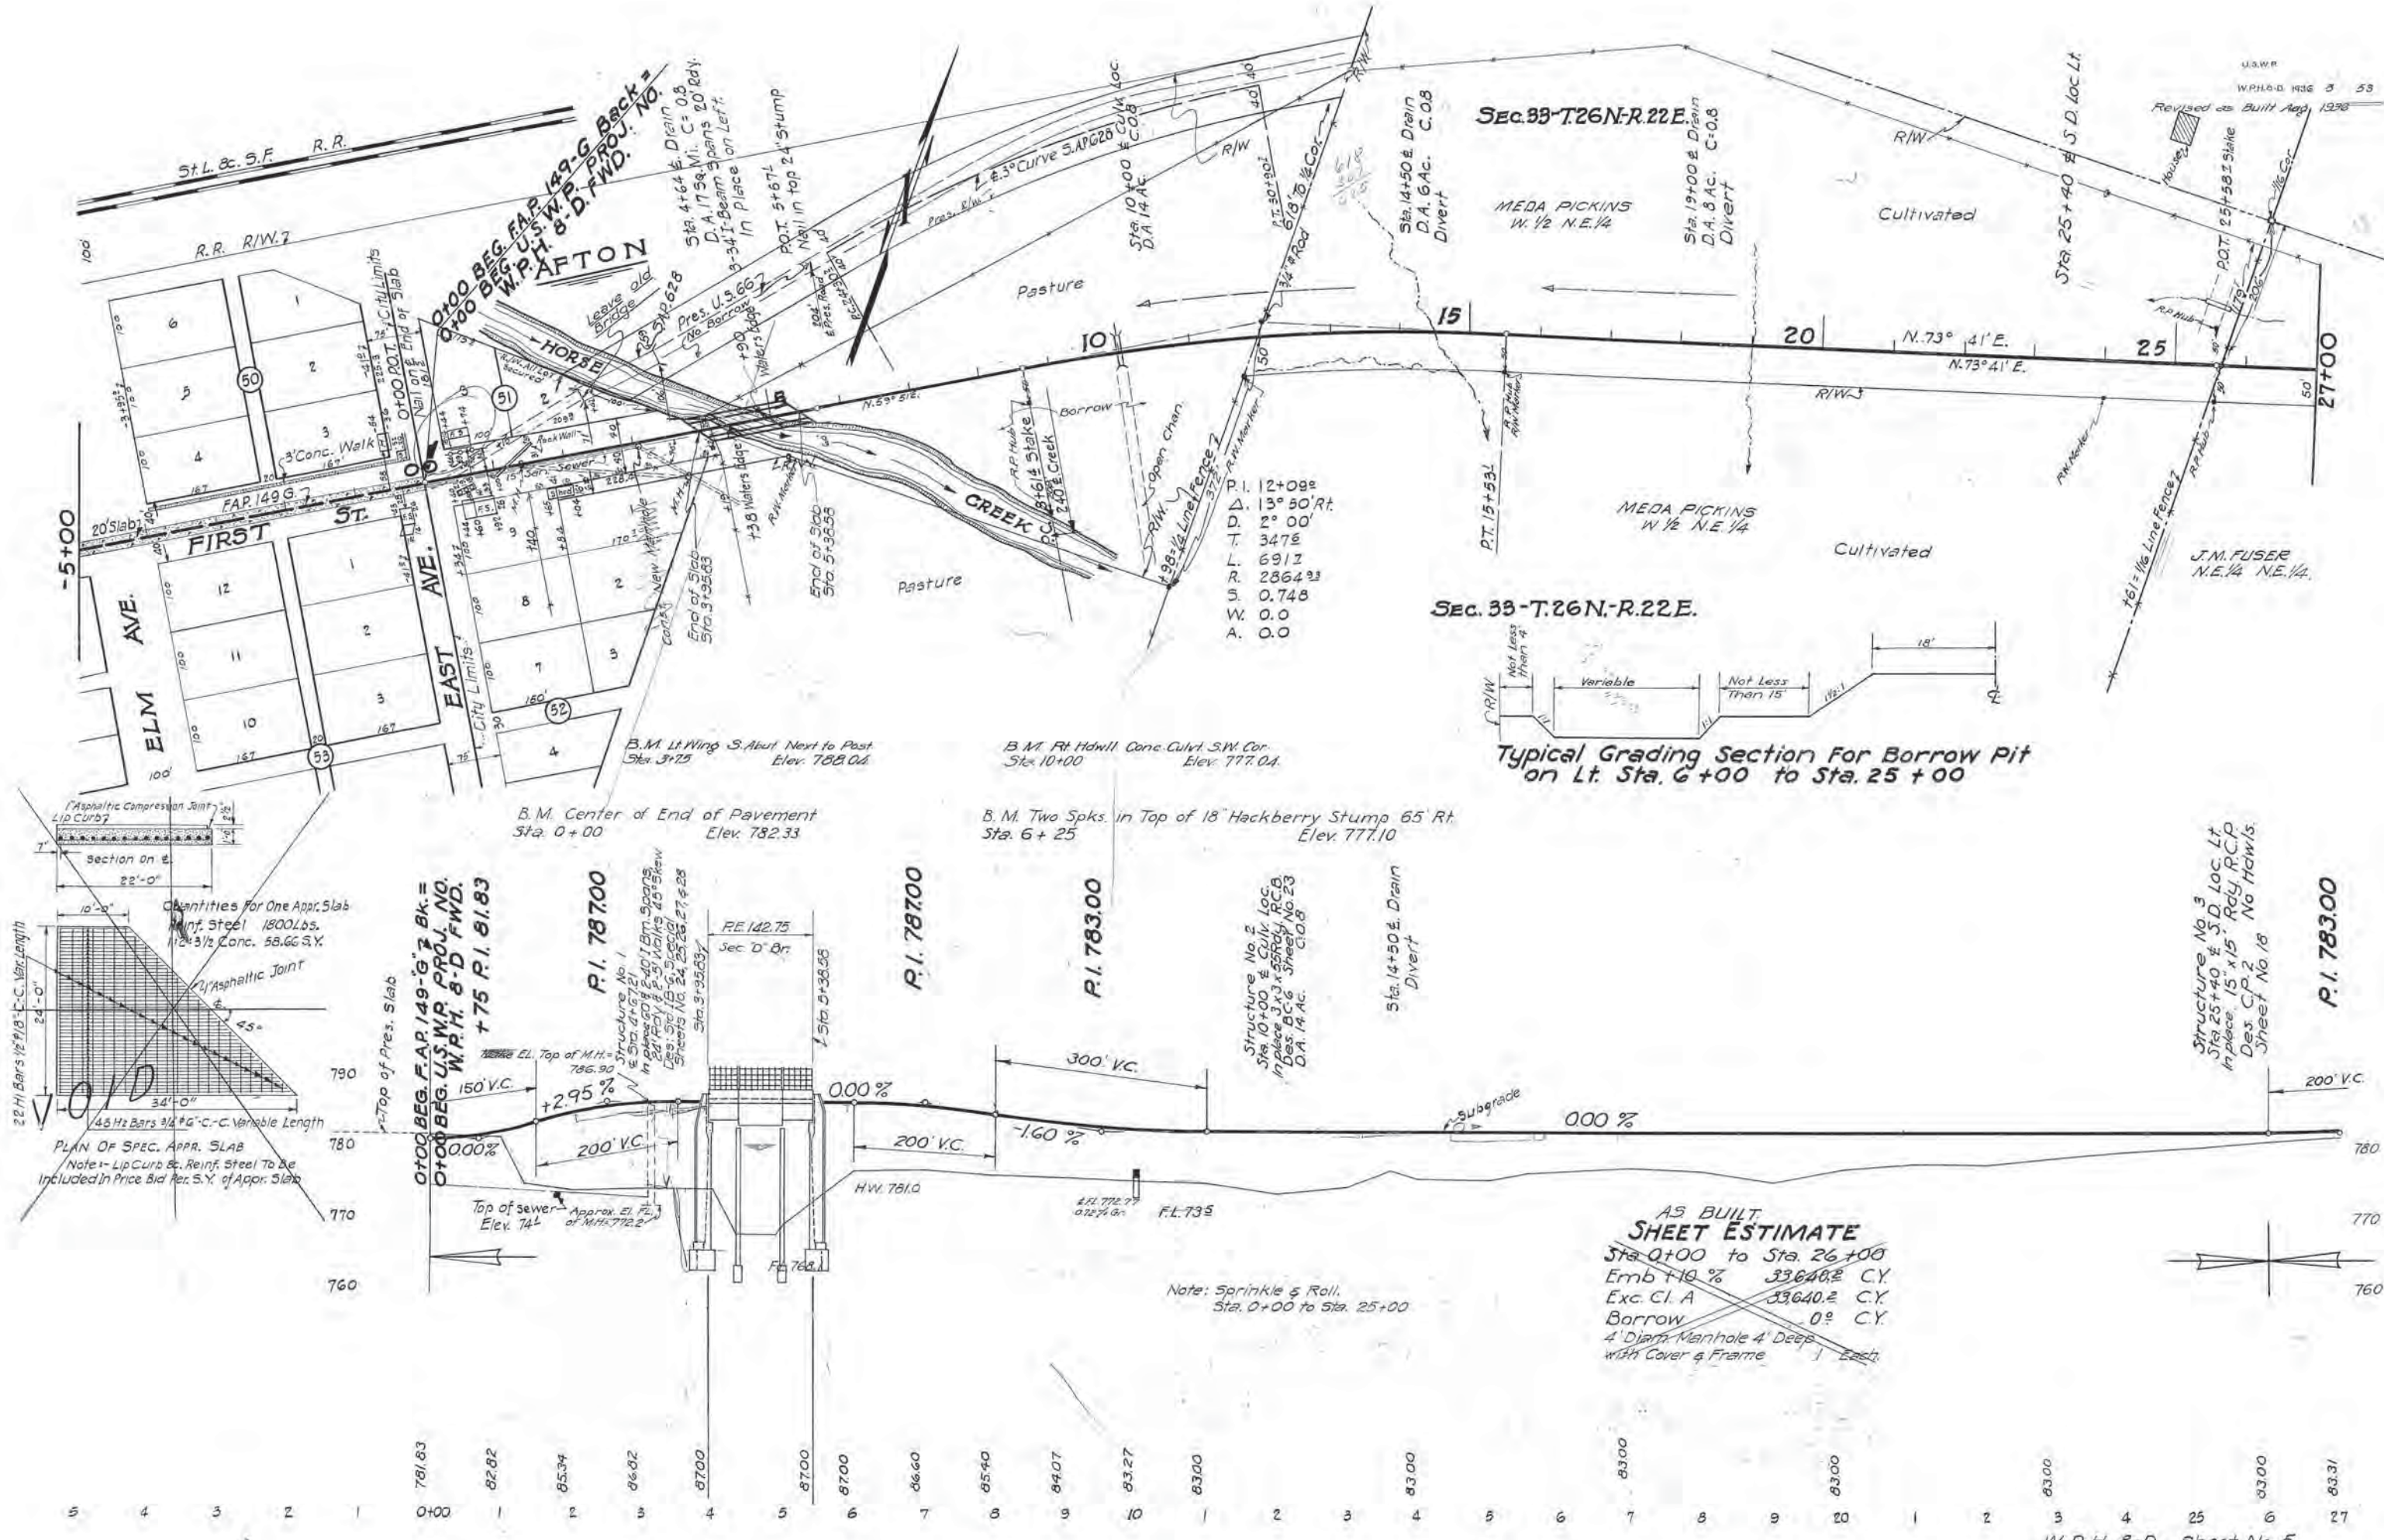

Sec. 33-T.26N-R.22E.

Sec. 33-T.26N-R.22E.

Typical Grading Section For Borrow Pit on Lt. Sta. 6+00 to Sta. 25+00

AS BUILT SHEET ESTIMATE


Sta. 0+00 to Sta. 26+00	
Emb + 10 %	33,640.2 C.Y.
Exc. Cl. A	33,640.2 C.Y.
Borrow	0.0 C.Y.
4" Diam. Mainhole 4' Deep with Cover & Frame	1 East



37702-887118



LAYOUT OF PROPOSED SEWER LINE.

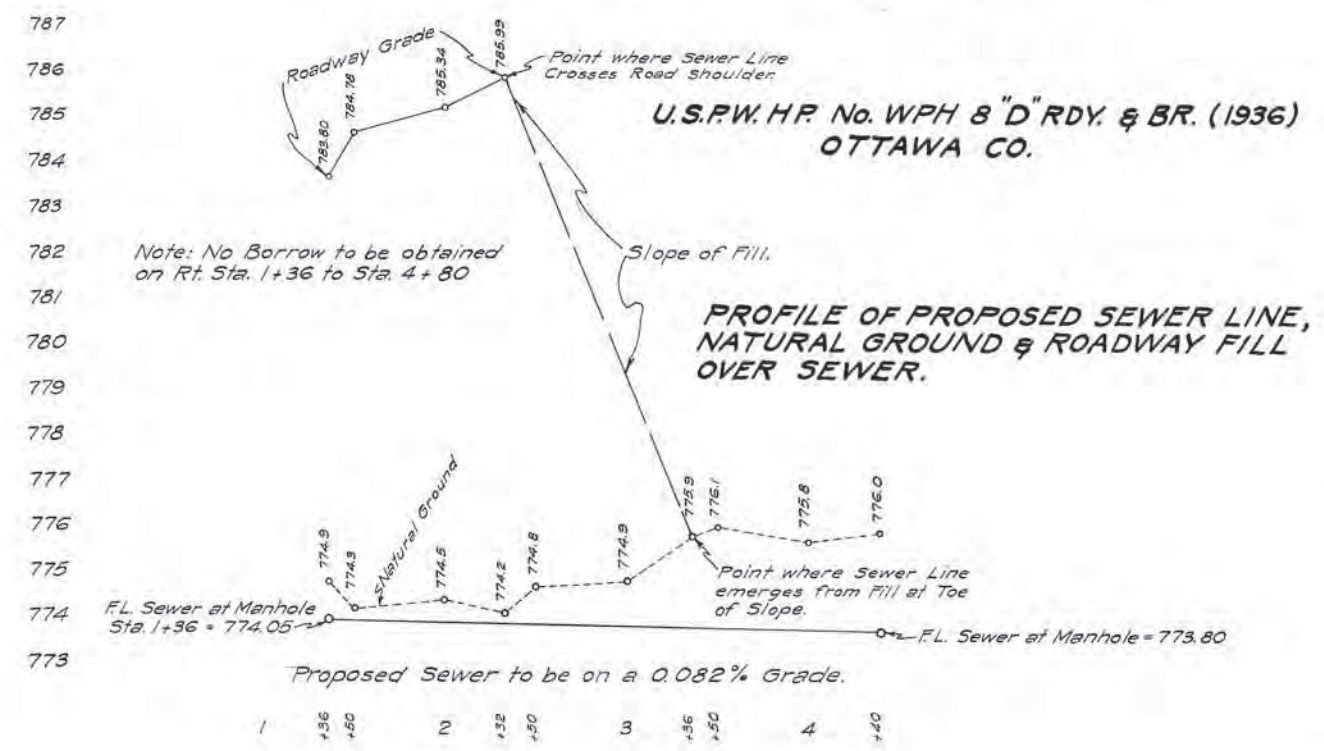


U.S.P.W. H.P. No. WPH 8 "D" RDY. & BR. (1936)  
OTTAWA CO.

Note: No Borrow to be obtained on Rt. Sta. 1+36 to Sta. 4+80

PROFILE OF PROPOSED SEWER LINE, NATURAL GROUND & ROADWAY FILL OVER SEWER.

Proposed Sewer to be on a 0.082% Grade.

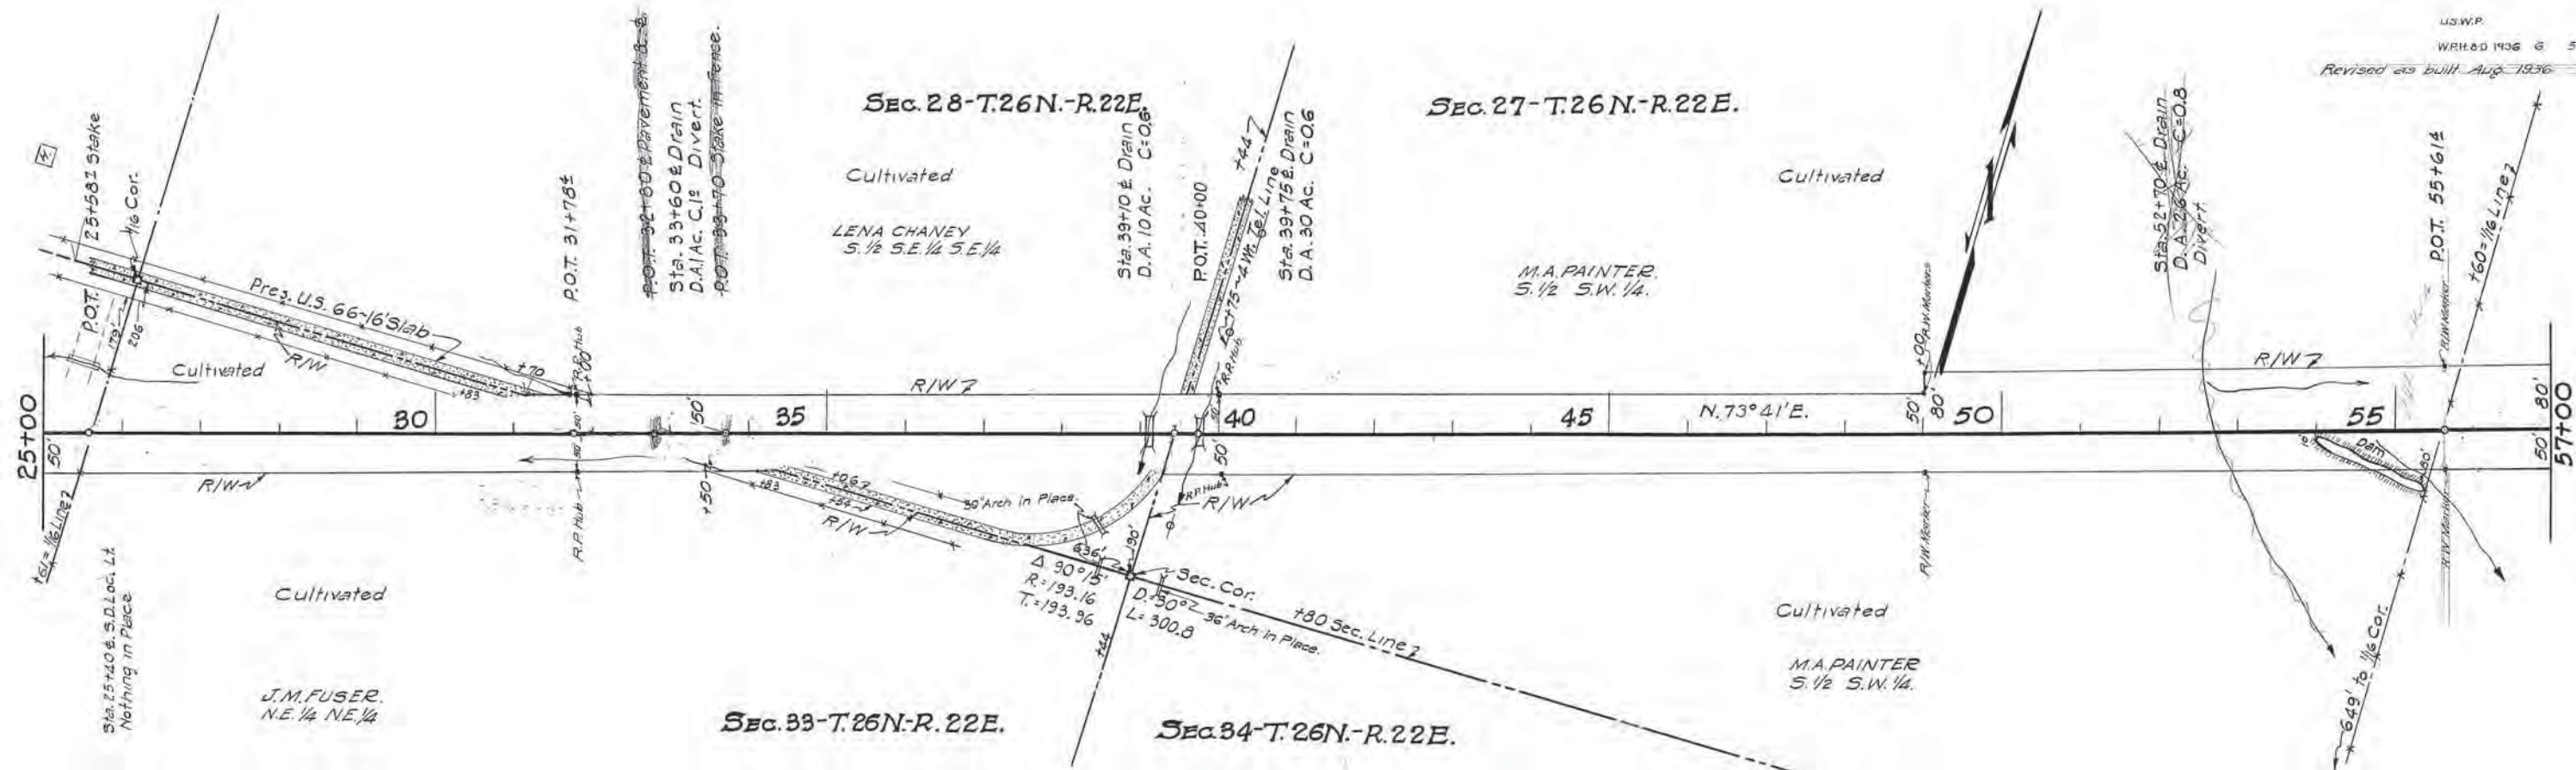


B.M. 'X' on S. Hd. Wl. of Culv. 175' Rt.  
Sta. 38+70 Elev. 790.63

B.M. S.W. Cor. S. Hd. Wl. 30" R.C.P.  
Sta. 39+75 Elev. 790.57


AS BUILT  
SHEET ESTIMATE  
Sta. 26+00 to Sta. 56+00  
Emb. 7496.6 C.Y.  
Exc. C.I.A. 7496.6 "  
Borrow 0.0 "  
Over Haul 0.0 Sta. Yds.  
Remove Pres. Slab 5.4

Structure No. 3  
Sta. 25+40 & S.D. Loc. Lt.  
In place 15' x 15' R.C.P.  
Des. C.P. 2 No. 18  
Sheet No. 18

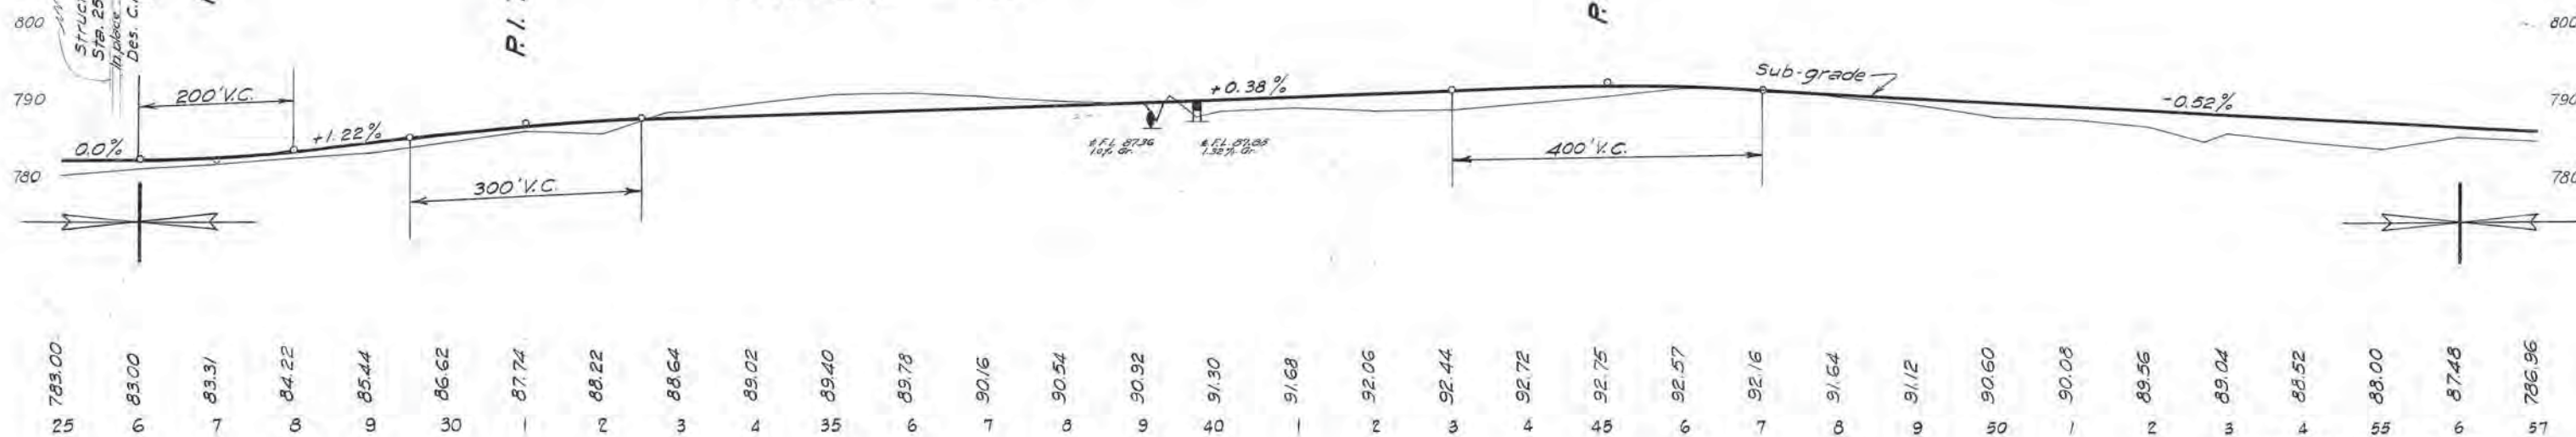



Sec. 27-T.26N.-R.22E.

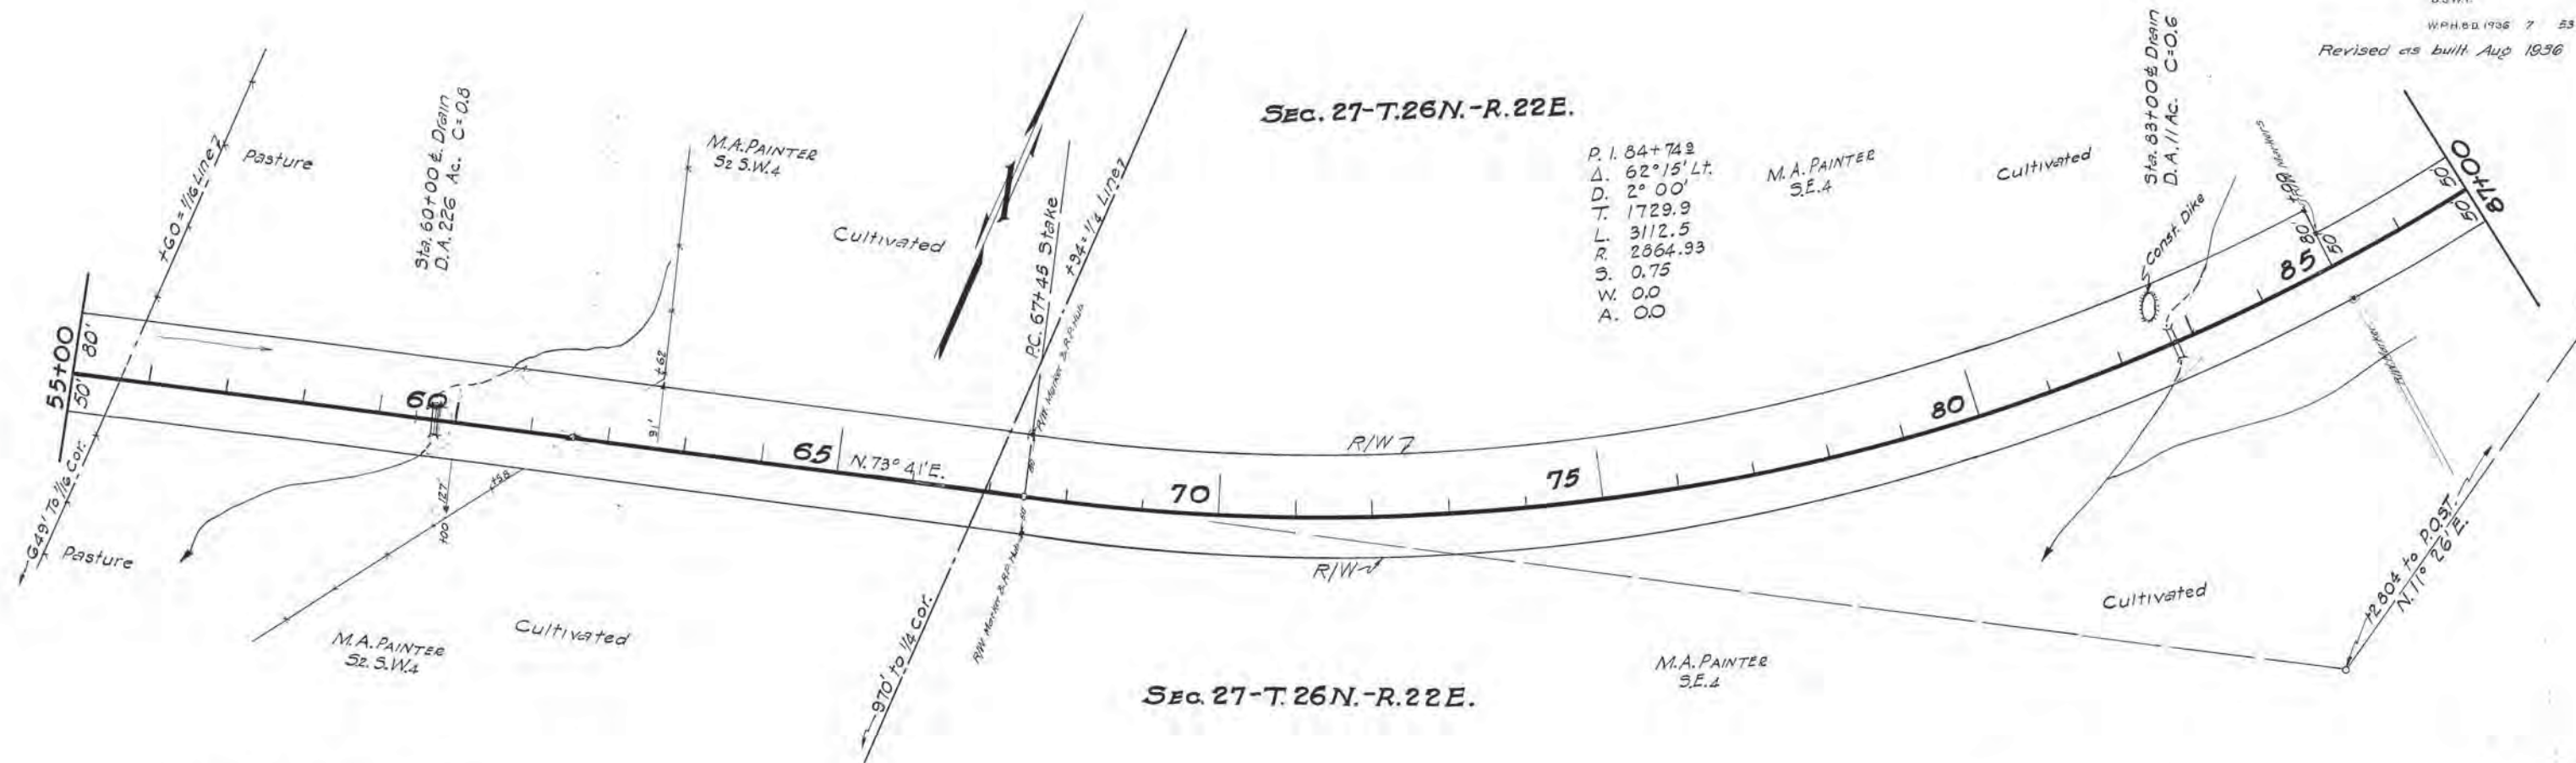

Sec. 27-T.26N.-R.22E.

B.M. S.W. Cor. Hdwl Culvt.  
Sta. 59+75 Elev. 785.19

Structure No. 6  
Sta. 59+75 E. Drain  
In place 2'-8" x 3'-8" Rd. R.C.B.  
Des. B.C. 5A2 Sheet No. 22  
D.A. 226 Ac. C=0.6


P.I. 784.62

AS BUILT  
SHEET ESTIMATE  
Sta. 56+00 to Sta. 102+00  
Emb. 710' 12.7545 C.Y.  
Exc. Cl. A. 12.7545 "  
Borrow 0° "  
Overhaul 0° 31' 11"

B.M. S. Cor. S.E. Hdwl Culvt.  
Sta. 82+70 Elev. 799.12



Structure No. 7  
Sta. 82+70 E. Drain  
In place 2'-8" x 3'-8" Rd. R.C.B.  
Des. B.C. 52 Sheet No. 20  
D.A. 114 Ac. C=0.6

P.I. = 800.23

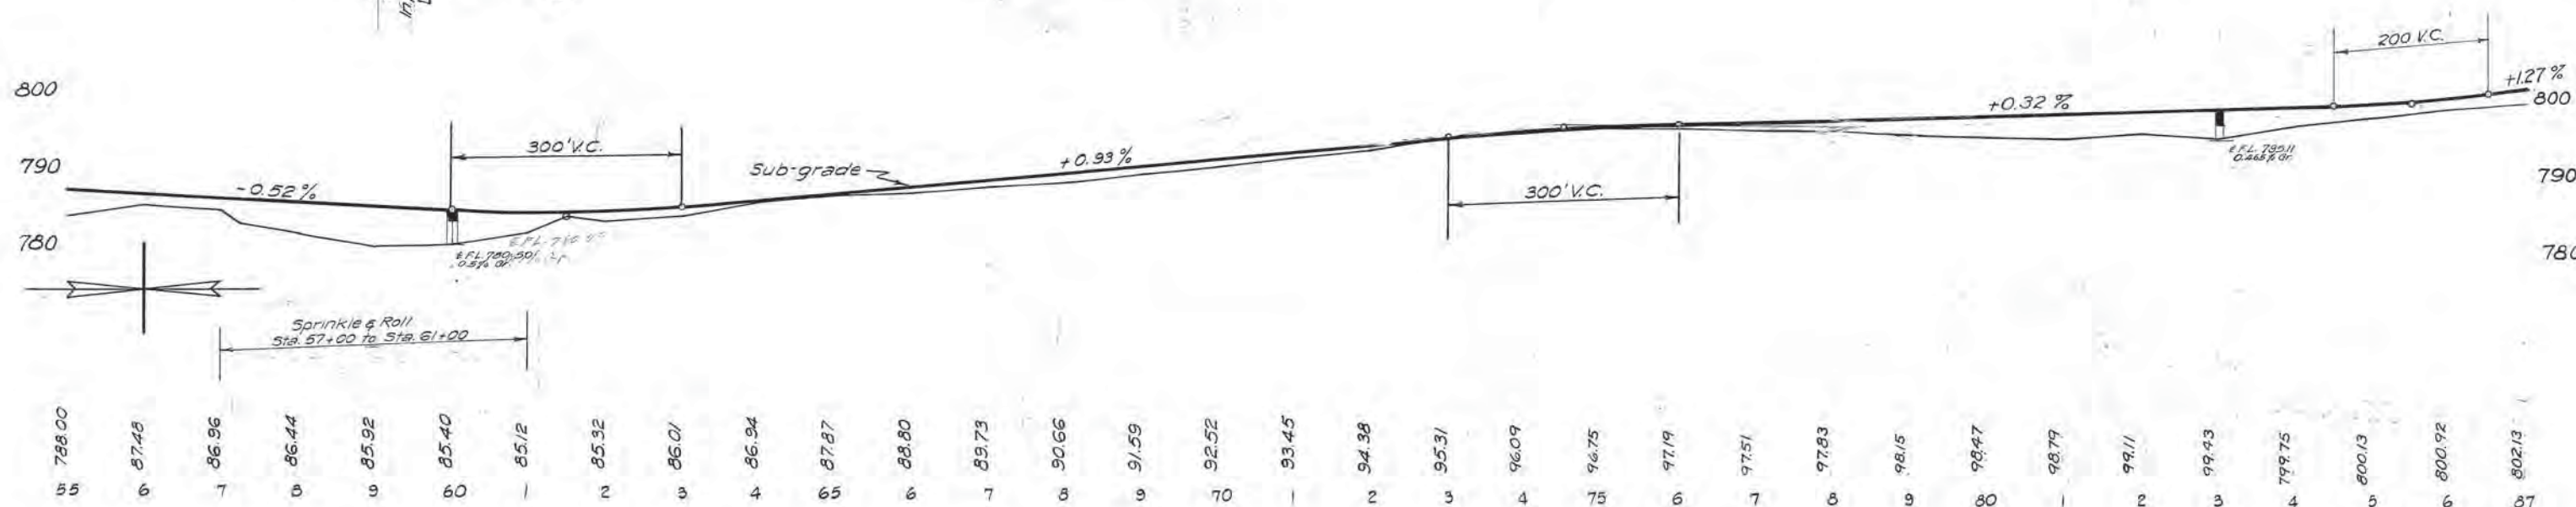



Revised as built, Aug. 1936

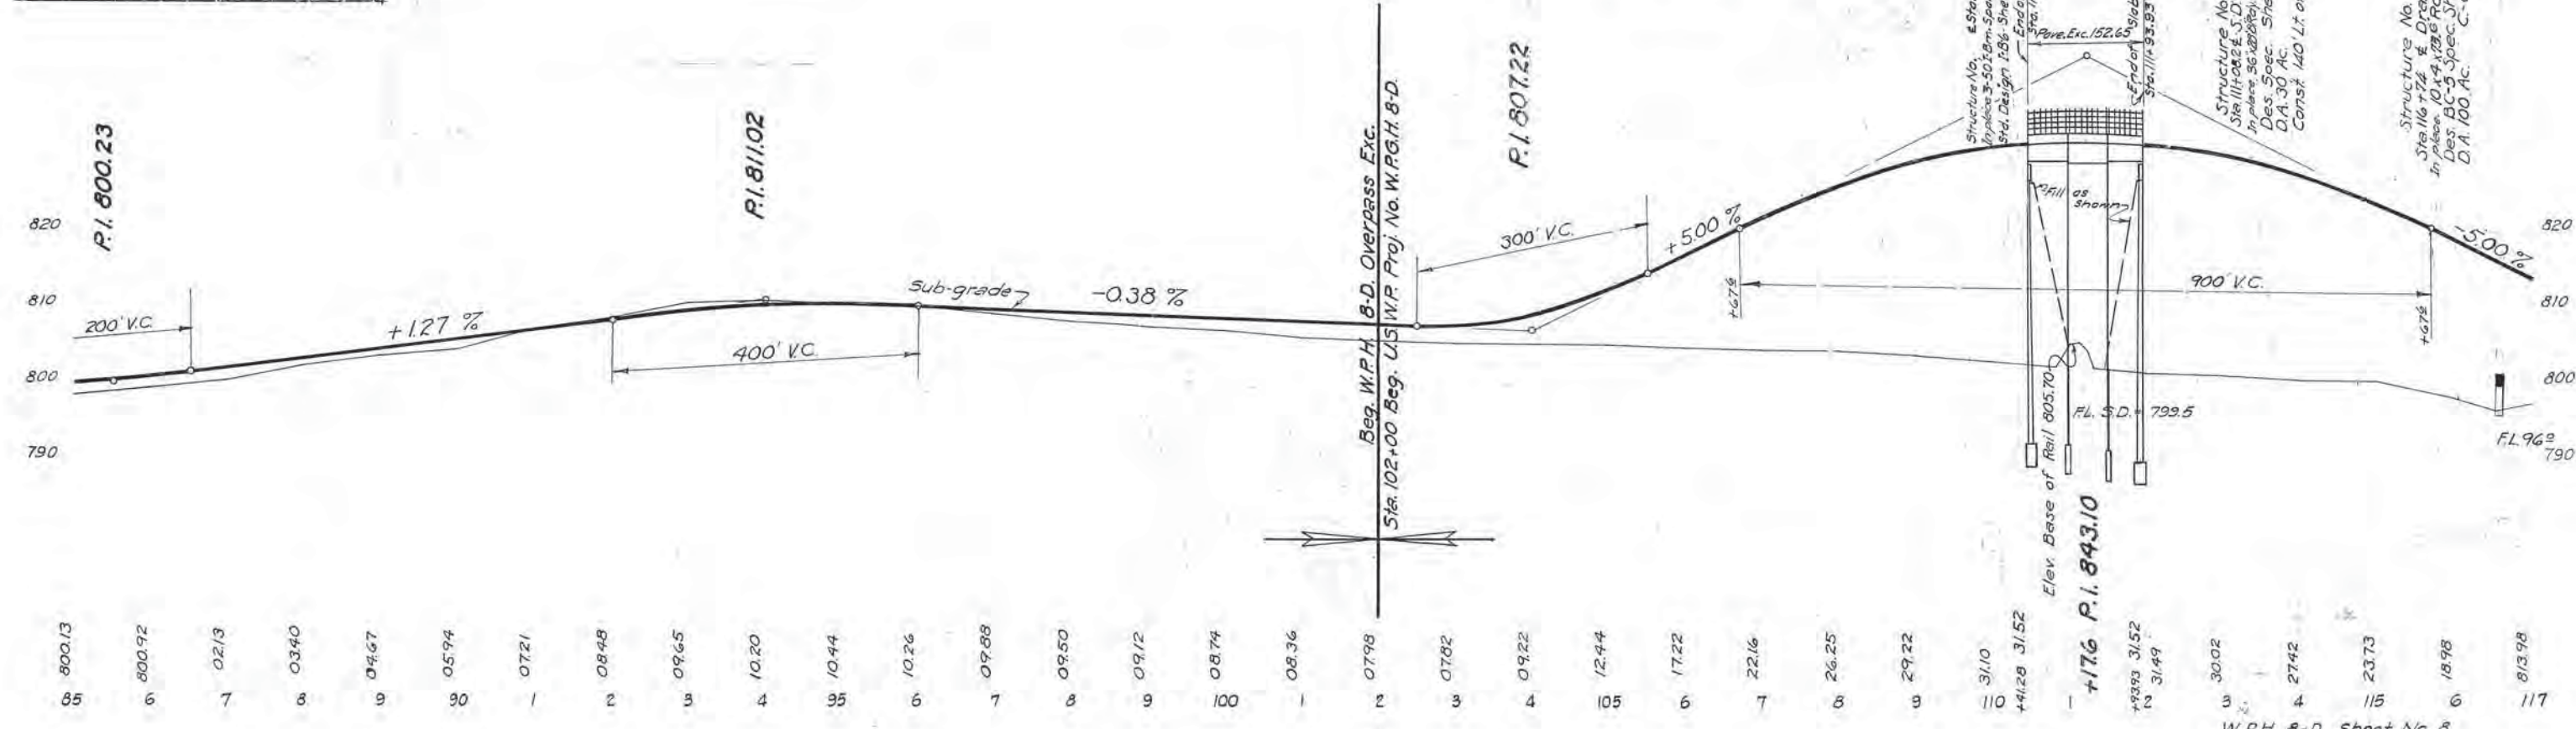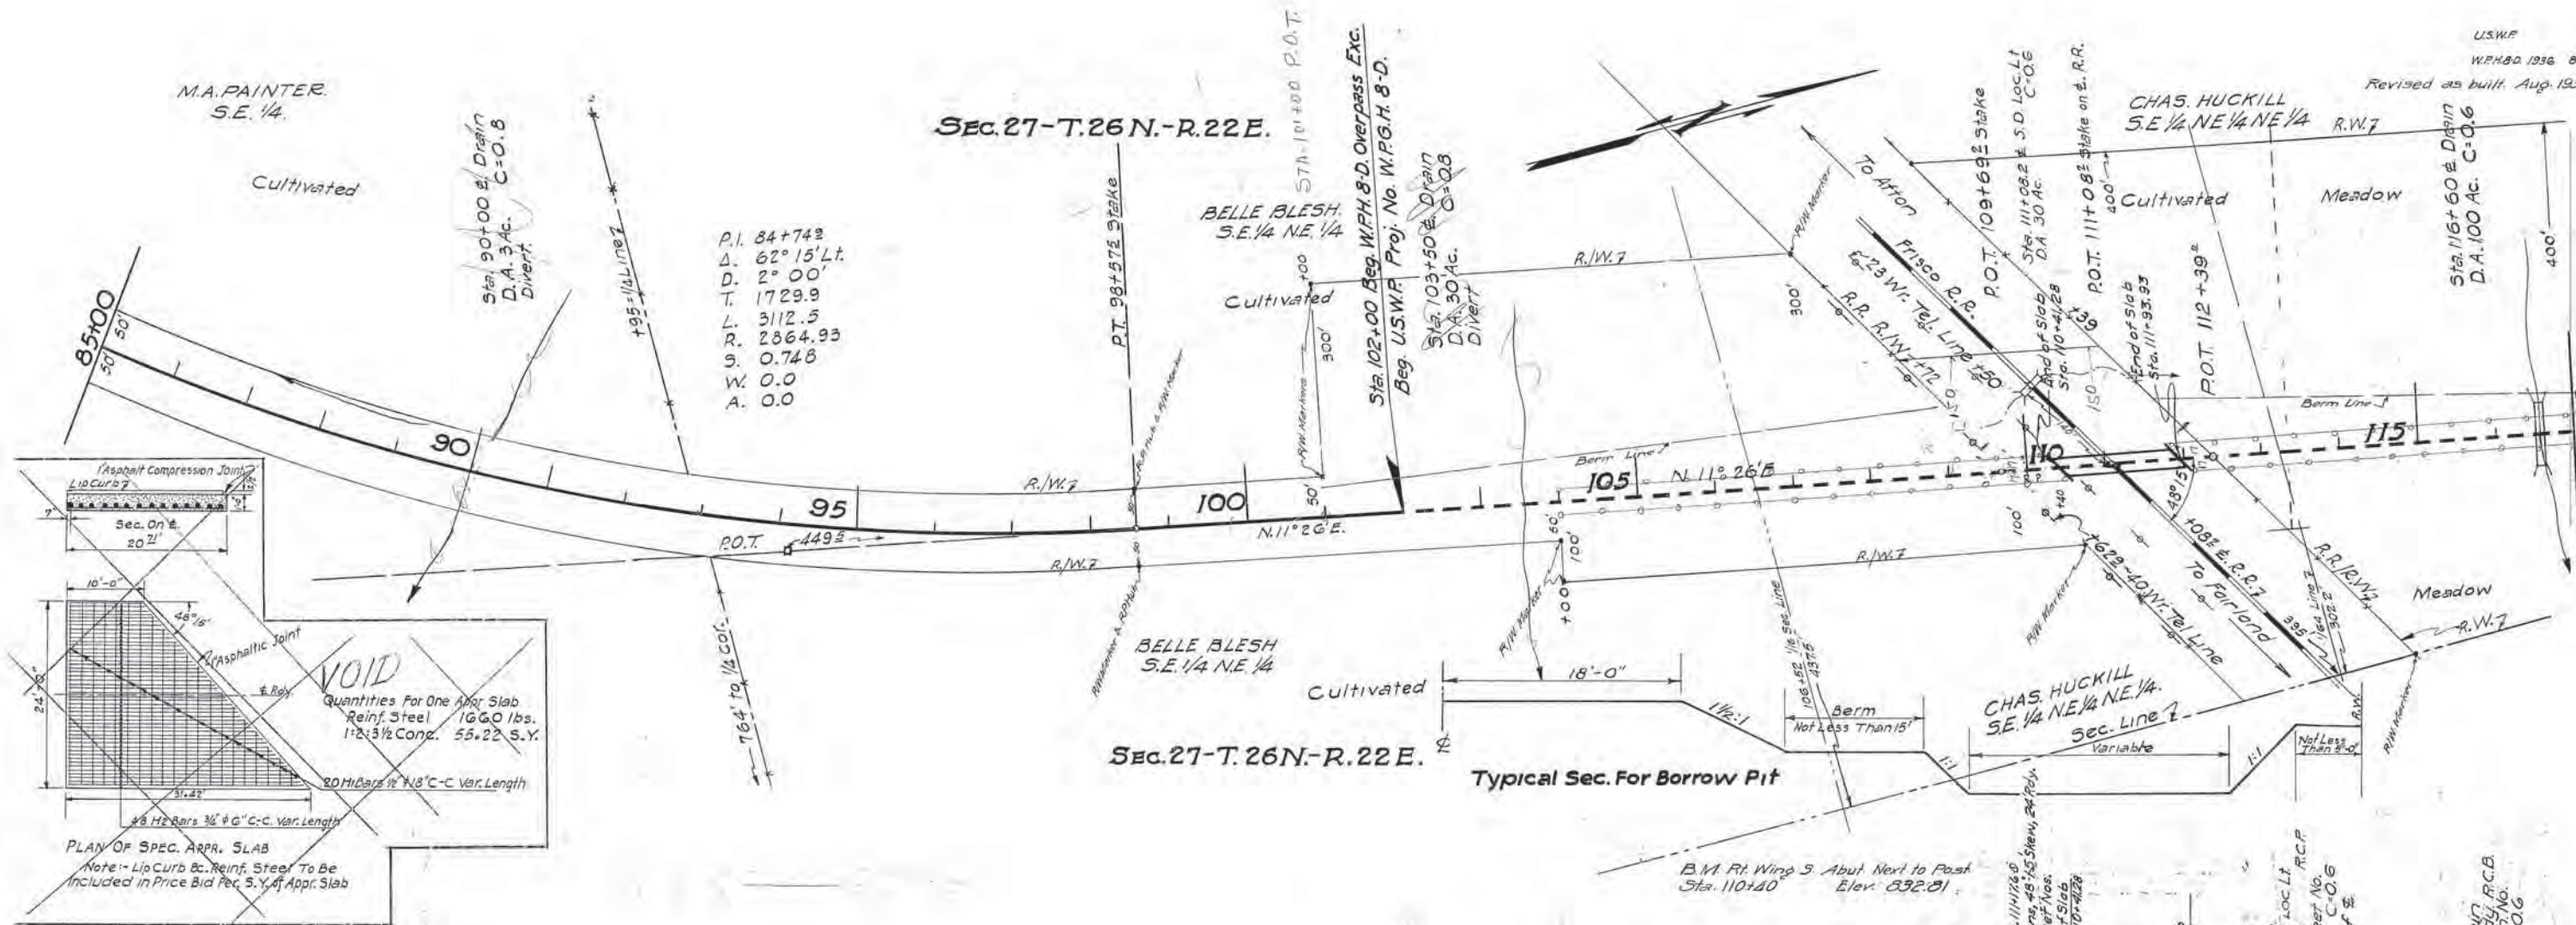








Revised as built Aug 1936


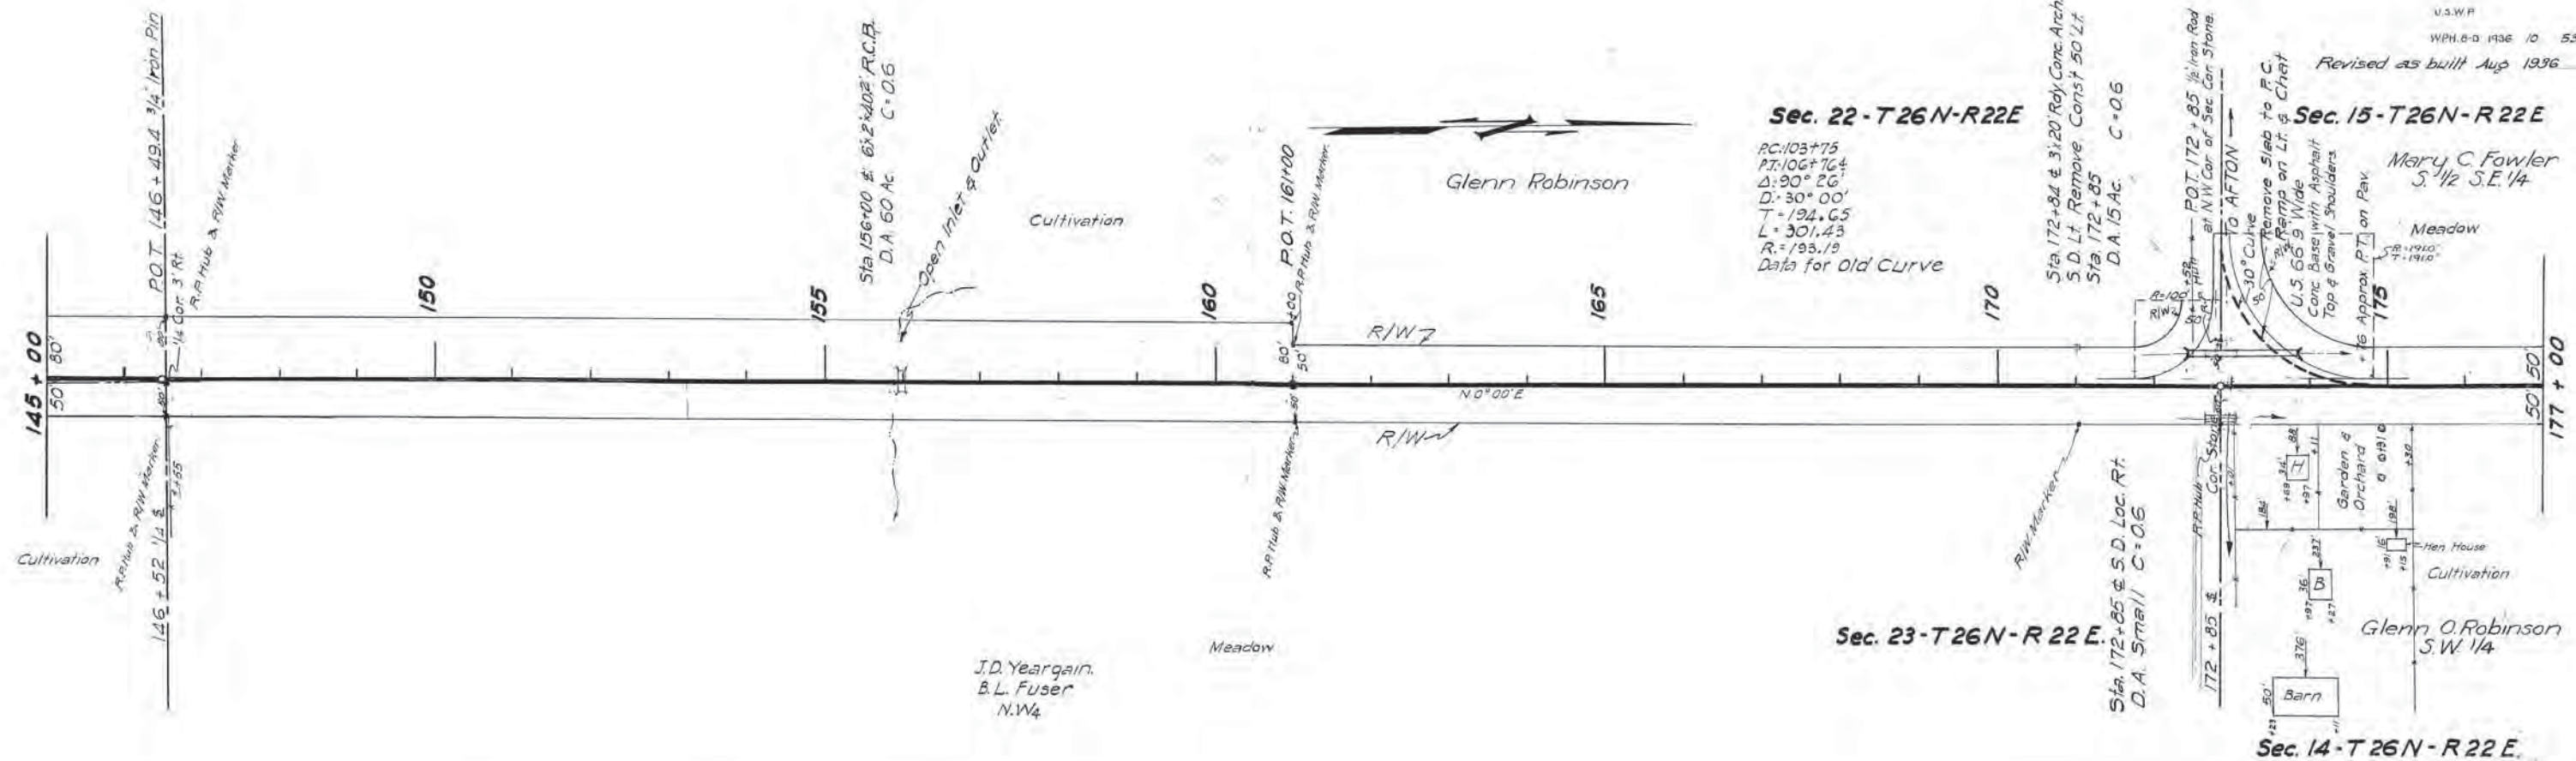


B.M. S.E. Cor. E. Hdwl. Culvt.  
Sta. 156+00 Elev. 808.28

P.I. 809.10  
Structure No. 9  
Sta. 156+00 E. Drain  
Inplace 6x2x102 R.C.B.  
Des. B.C. 52 Sheet No. 20  
D.A. 60 Ac. C=0.6  
Remove 18'x18' Conc. Pipe


AS BUILT  
SHEET ESTIMATE  
Sta. 146+00 to Sta. 176+00  
Emb. +10% 9207.9 C.Y.  
Exc. Cl. A. 9207.9 "  
Borrow 0.0 "  
Rem. Asphalt Top & Conc. Base 421.7 S.Y.  
Check For Intersection 83.0 C.Y. Based on 2" Loose

B.M. S.W. Cor. S. Hdwl. S.D. Lt.  
Sta. 172+85 Elev. 811.27  
Structure No. 10  
Sta. 172+85 S.D. Loc. Lt.  
Inplace 3x2x140 Roly. R.C.B.  
Des. B.C. 5 Sheet No. 19  
D.A. 15 Ac. C=0.6  
Remove 3x20 Conc. Arch  
Const. 50' Lt.  
Structure No. 11  
Sta. 172+85 S.D. Loc. Rt.  
Inplace 24x30 Roly. R.C.P.  
Des. C.F. 2 90-Wings  
Sheet No. 18  
D.A. Small C=0.6

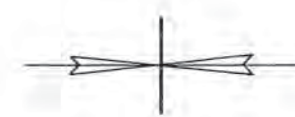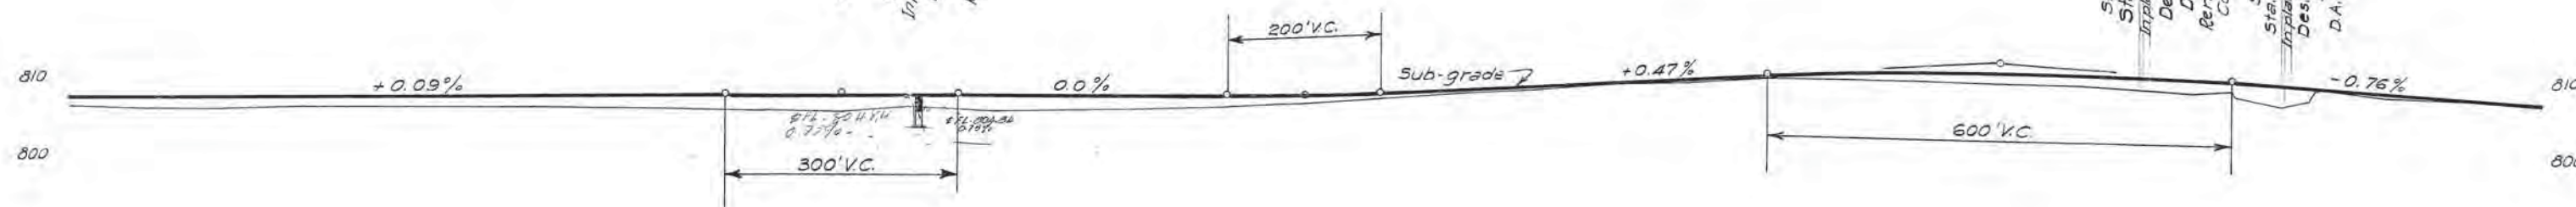

808.21	08.30	08.39	08.48	08.57	08.66	08.75	08.84	08.93	09.01	09.07	09.09	09.10	09.10	09.10	09.22	09.57	10.04	10.51	10.98	11.45	11.92	12.30	12.48	12.48	12.19	11.72	11.05	10.29	09.53	08.77	808.01	
145	6	7	8	9	150	1	2	3	4	5	6	7	8	9	160	1	2	3	4	5	6	7	8	9	170	1	2	3	4	5	6	177



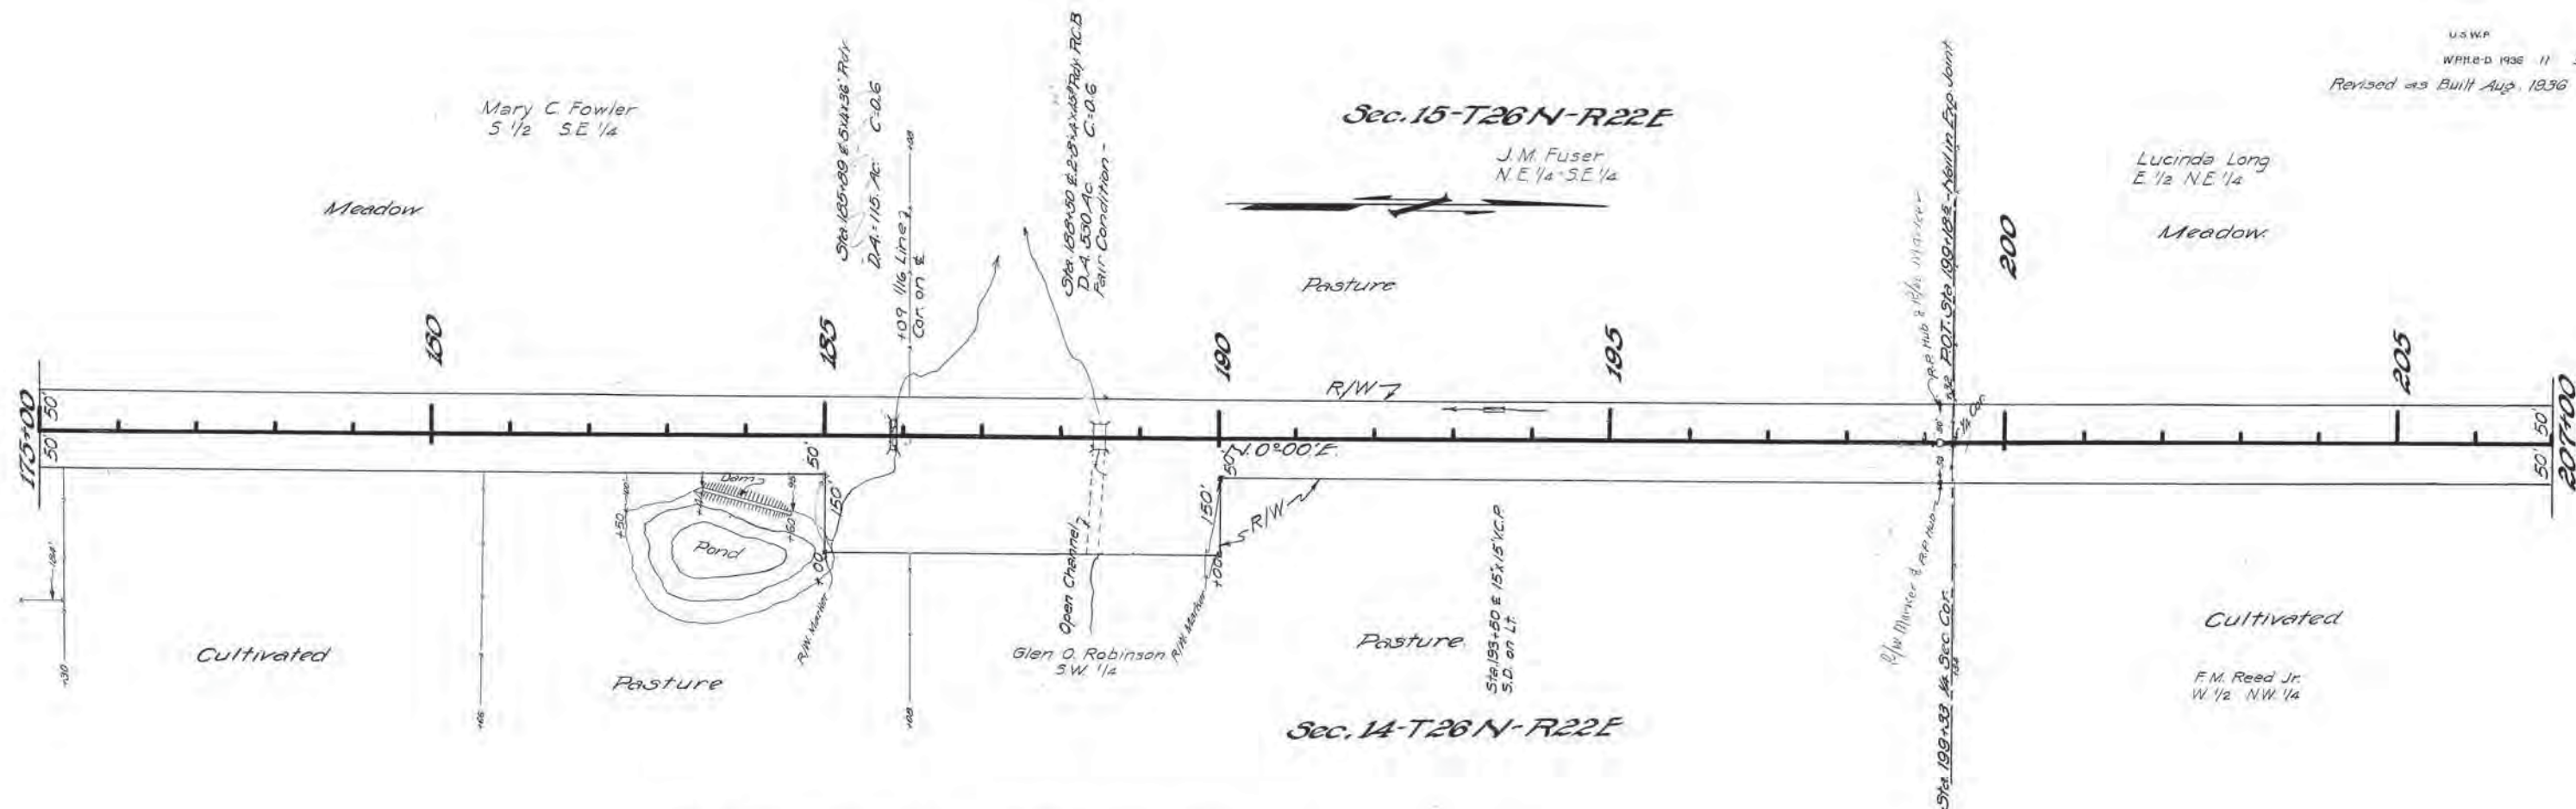

B.M. S.E. Cor. E. Hdwl. Culvt.  
 Sta. 185+65 Elev. 802.63

B.M. S.E. Cor. E. Hdwl. Culvt.  
 Sta. 188+50 Elev. 800.63

P.I. 803.07

Structure No. 12  
 Sta. 185+65 & Drain  
 Const. 5' x 4' x 36' R.C.B.  
 Des. B.C. 5' Sheet No. 19  
 D.A. 1/15 Ac. C=0.6  
 Remove 6' x 4' x 27' Conc. Arch


P.I. 801.97

Structure No. 13  
 Sta. 188+50 & 2-8' x 4' x 30' R.C.B.  
 Leave & Extend to R/W & 7' Lt.  
 Des. B.C. 5A Sheet No. 21  
 D.A. 530 Ac. C=0.6

Structure No. 14  
 Sta. 193+50 & Drain  
 In place. 18' x 21' Rdy.  
 R.C.P. Des. C.P. 2 No Hdwl's.  
 Sheet No. 18

P.I. 806.94

AS BUILT  
**SHEET ESTIMATE**  
 Sta. 176+00 to Sta. 206+00  
 Emb 9655.3 C.Y.  
 Exc. Cl. A 9655.9 C.Y.  
 Borrow 0.0 C.Y.  
 Ret. Asphalt Top & Conc. Base 5V.

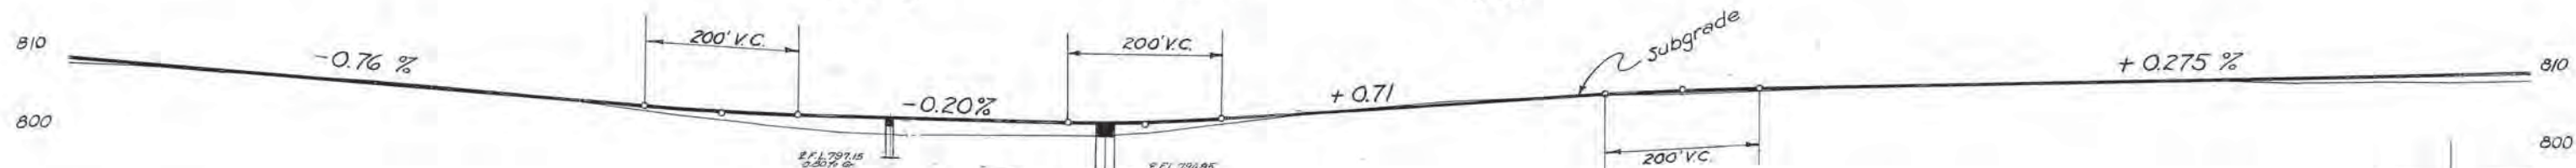

809.53	08.77	08.01	07.25	06.49	05.73	04.97	04.21	03.49	03.01	02.77	02.57	02.37	02.17	02.20	02.68	03.39	04.10	04.81	05.52	06.23	06.83	07.22	07.49	07.77	08.04	08.32	08.59	08.87	09.14	09.42	09.69	09.97
175	6	7	8	9	180	1	2	3	4	5	6	7	8	9	190	1	8	9	4	5	6	7	8	9	200	1	2	3	4	5	6	207








SEC-10-T.26 N.-R.22 E.




SEC-11-T.26 N.-R.22 E.

AS. BUILT  
**SHEET ESTIMATE**  
Sta. 235+00 to Sta. 266+00  
Emb. + 6461.9 C.Y.  
Exc. Cl. A. 5933.5 "  
Exc. Cl. B. 515.2 "  
Exc. Cl. C. 13.2 "  
Rem. Asphalt Top & Conc. Base 5 Y.

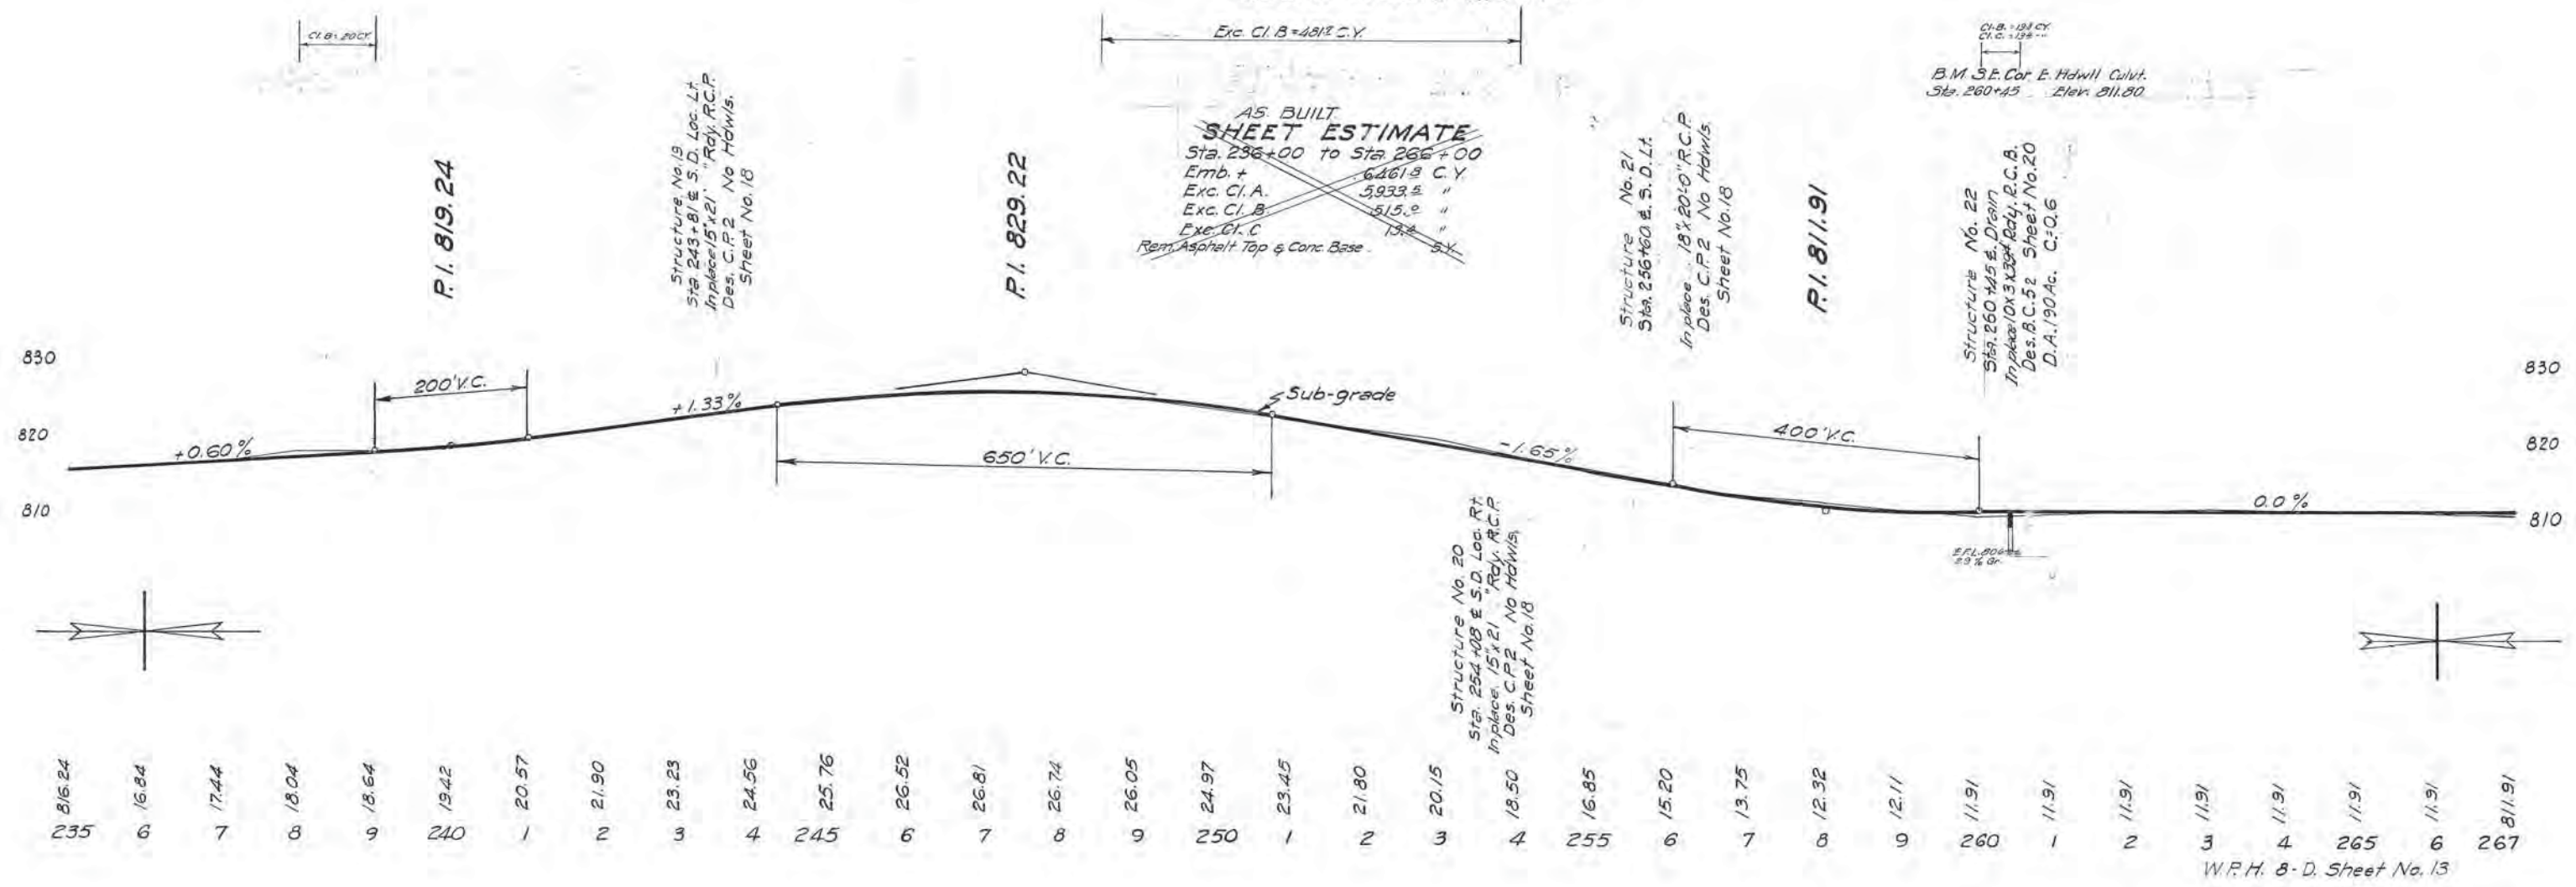




Revised as Built Aug - 1936

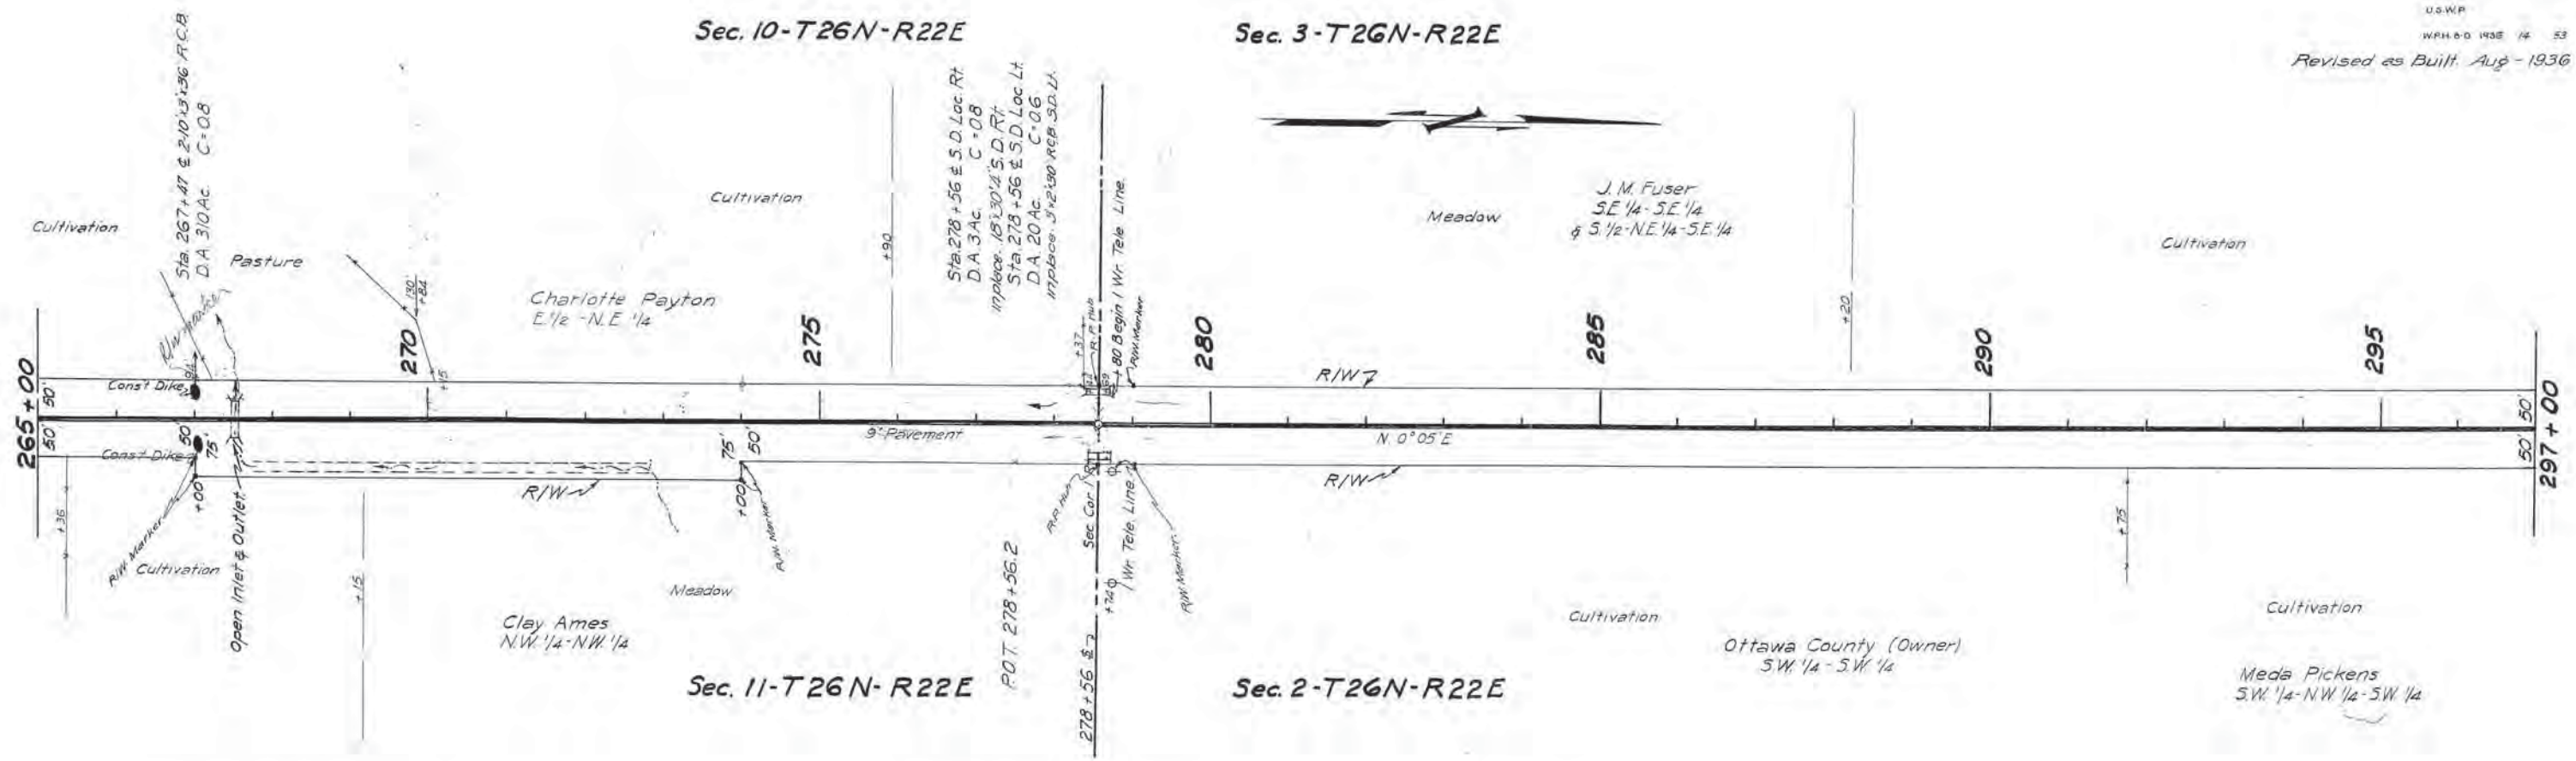

B.M. S.E. Cor. E. Hdwl. Culvt.  
Sta. 267+47 Elev. 812.43


B.M. S.W. Cor. S. Hdwl. S.D. Lt.  
Sta. 278+56 Elev. 815.73

AS BUILT  
**SHEET ESTIMATE**  
Sta. 266+00 to Sta. 296+00  
Emb't 7753.2 C.Y.  
Exc. Cl. "A" 7753.2 C.Y.  
Borrow C.Y.  
Rem. Asphalt Top & Conc. Base S.Y.

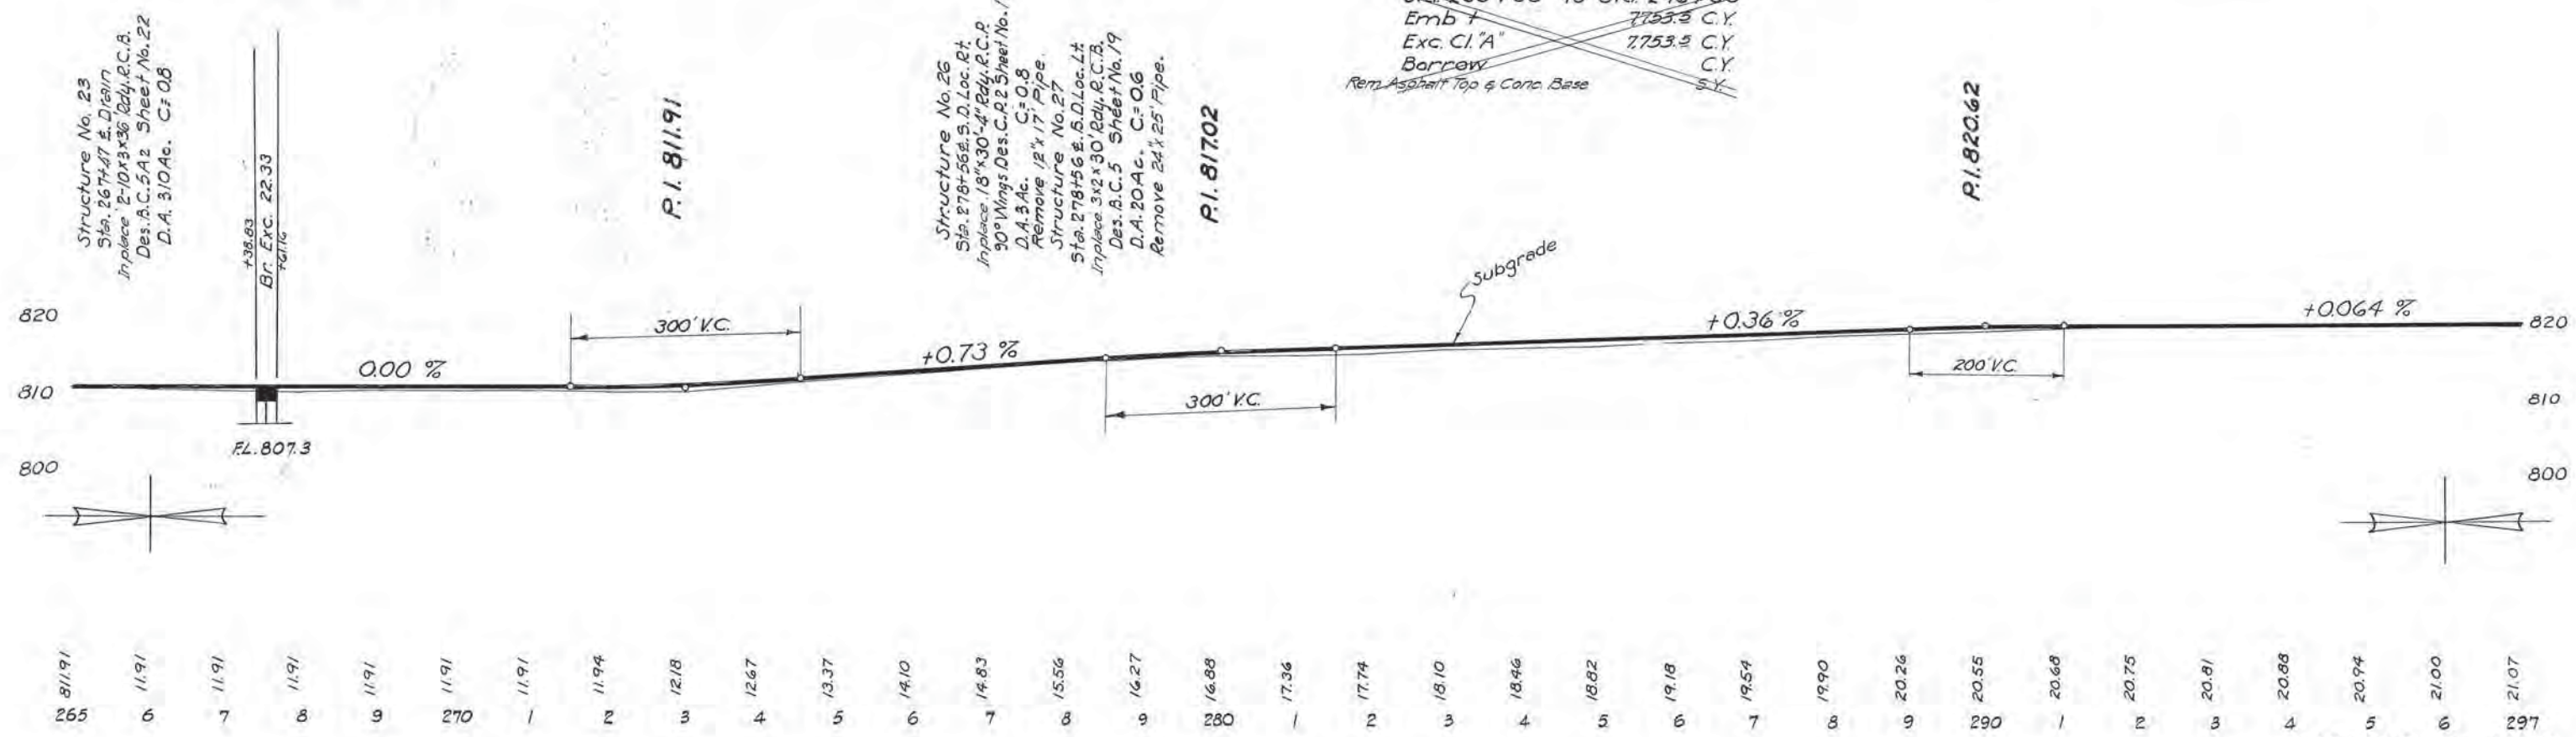




Sec. 3 T26N-R22E

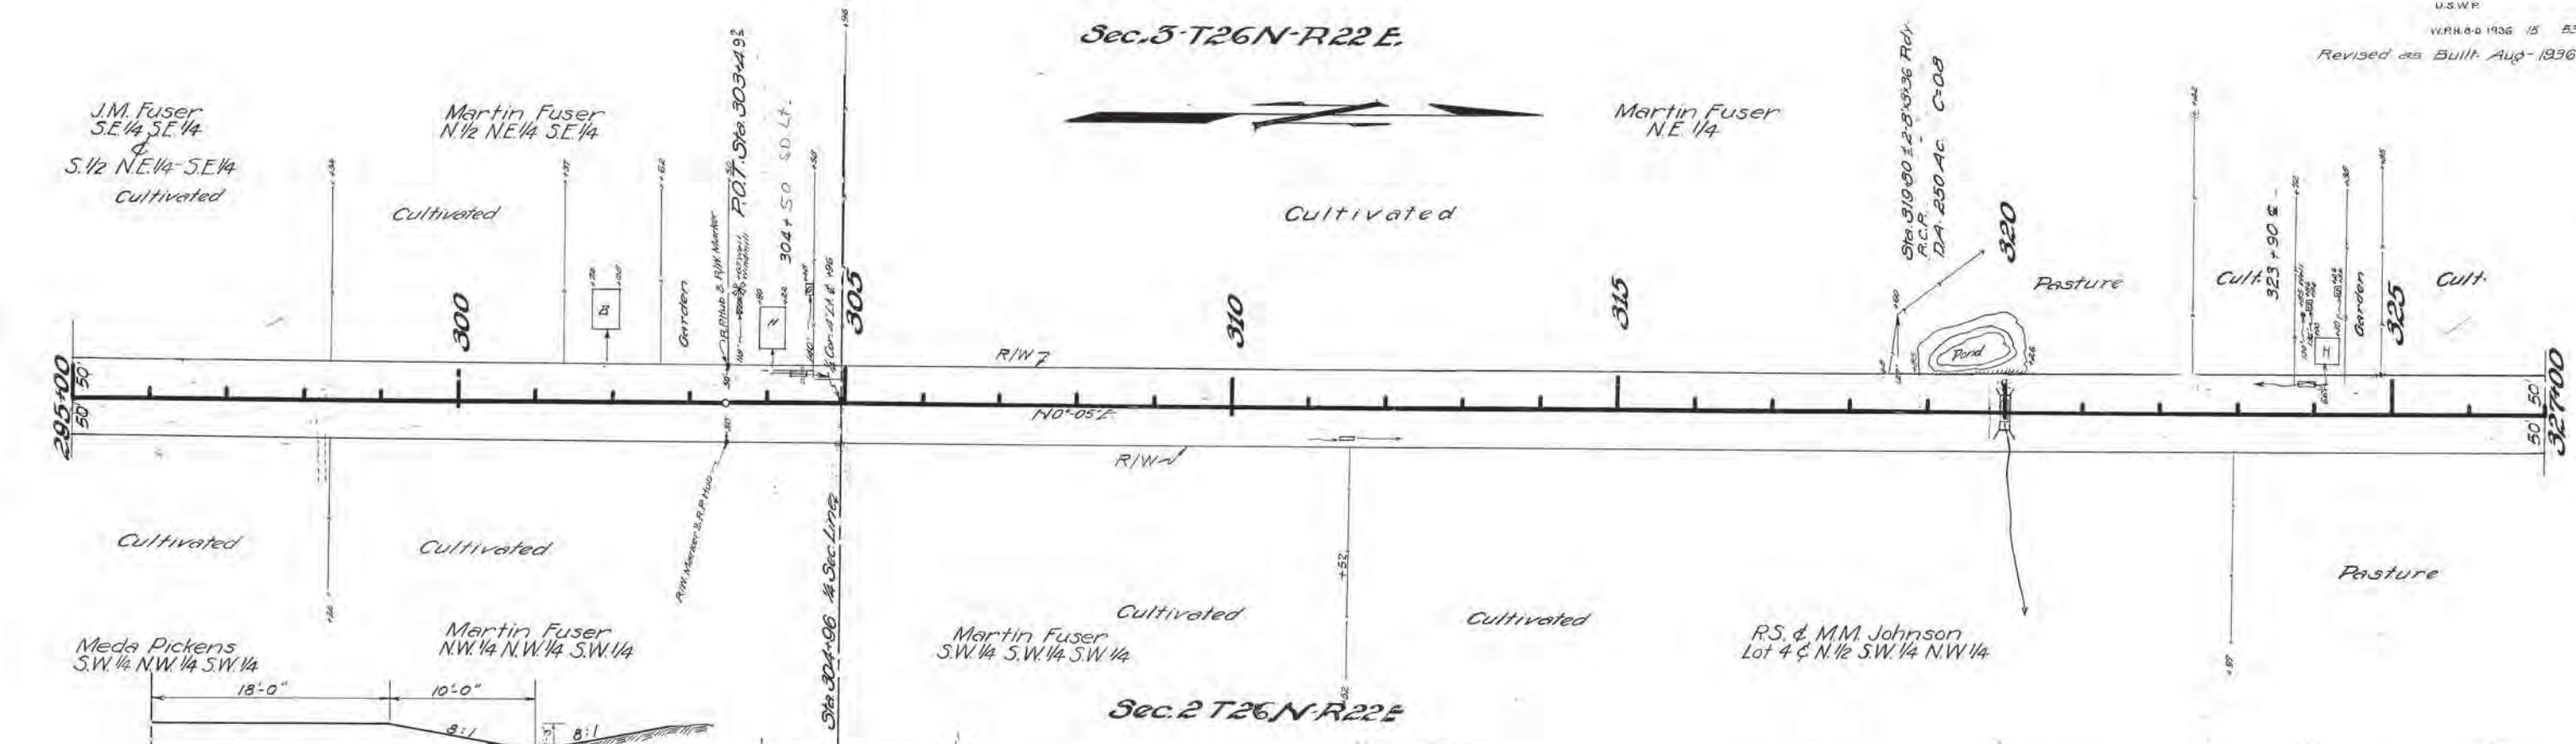



TYPICAL GRADING SECTION on Lt Sta. 301+00 to Sta. 302+00 Showing Flat Ditch for Farm Entrance.

AS BUILT  
**SHEET ESTIMATE**  
 Sta. 296+00 to Sta. 331+00


Emb.	80523	C.Y.
Exc. Cl. A	6760.7	"
Exc. Cl. B	9541	"
Exc. Cl. C	337.5	"
Borrow + Bk. Fill		"
Rem. Asphalt Top & Conc. Base		"
Overhaul		"

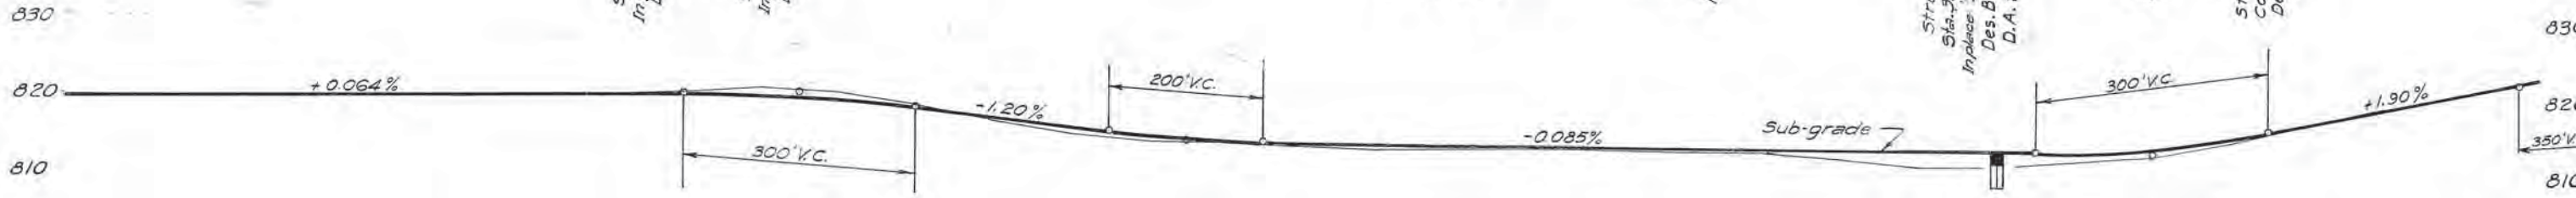

295	6	7	8	9	300	1	2	3	4	305	6	7	8	9	310	1	2	3	4	315	6	7	8	9	320	1	2	3	4	325	6	327
820.94	21.00	21.07	21.13	21.20	21.26	21.32	21.39	21.45	21.51	20.64	19.75	18.55	17.35	16.22	15.58	15.42	15.34	15.25	15.17	15.08	14.99	14.91	14.83	14.74	14.66	14.66	15.25	15.48	18.29	20.19	22.09	823.07

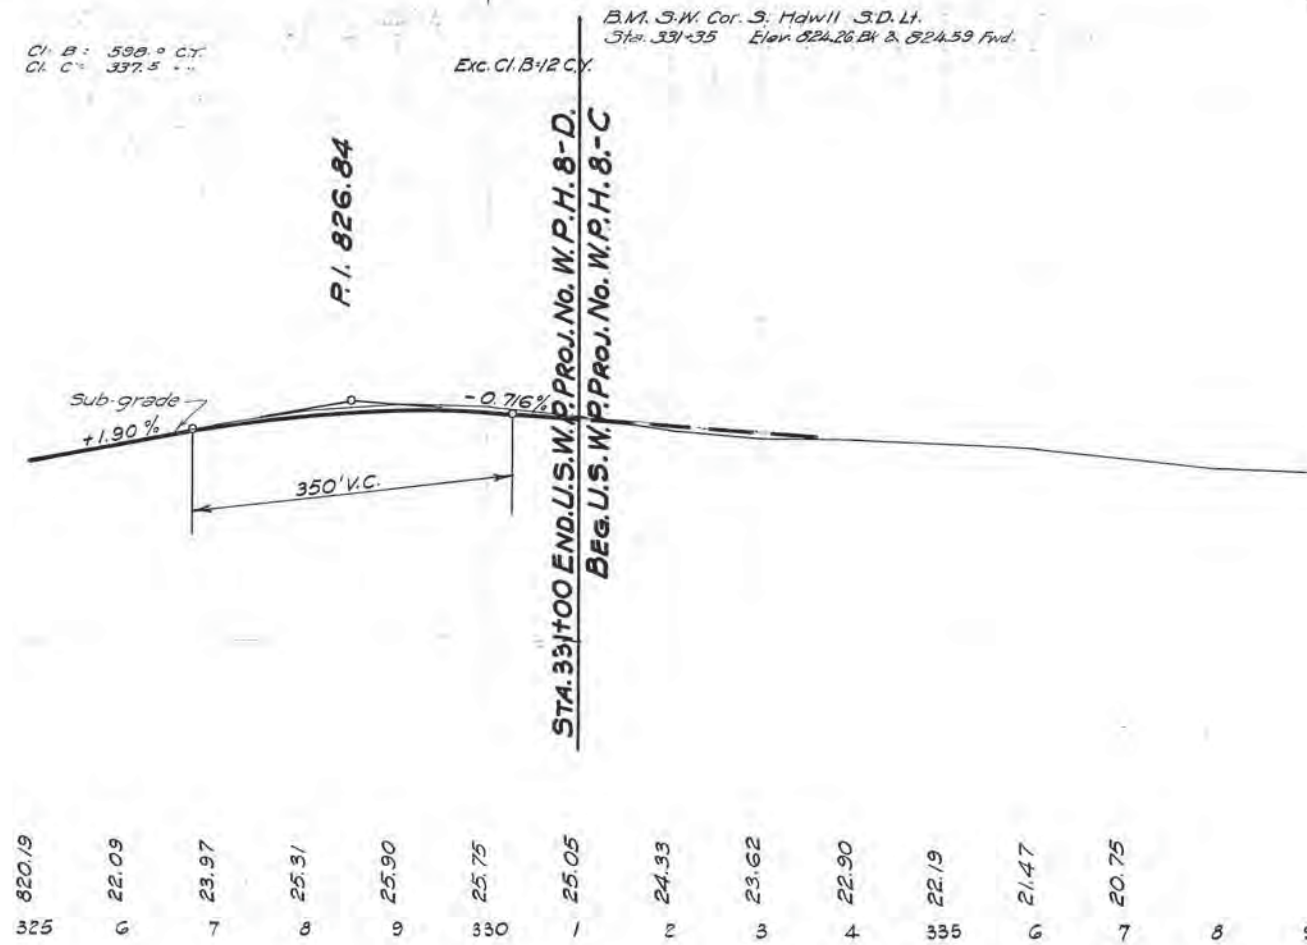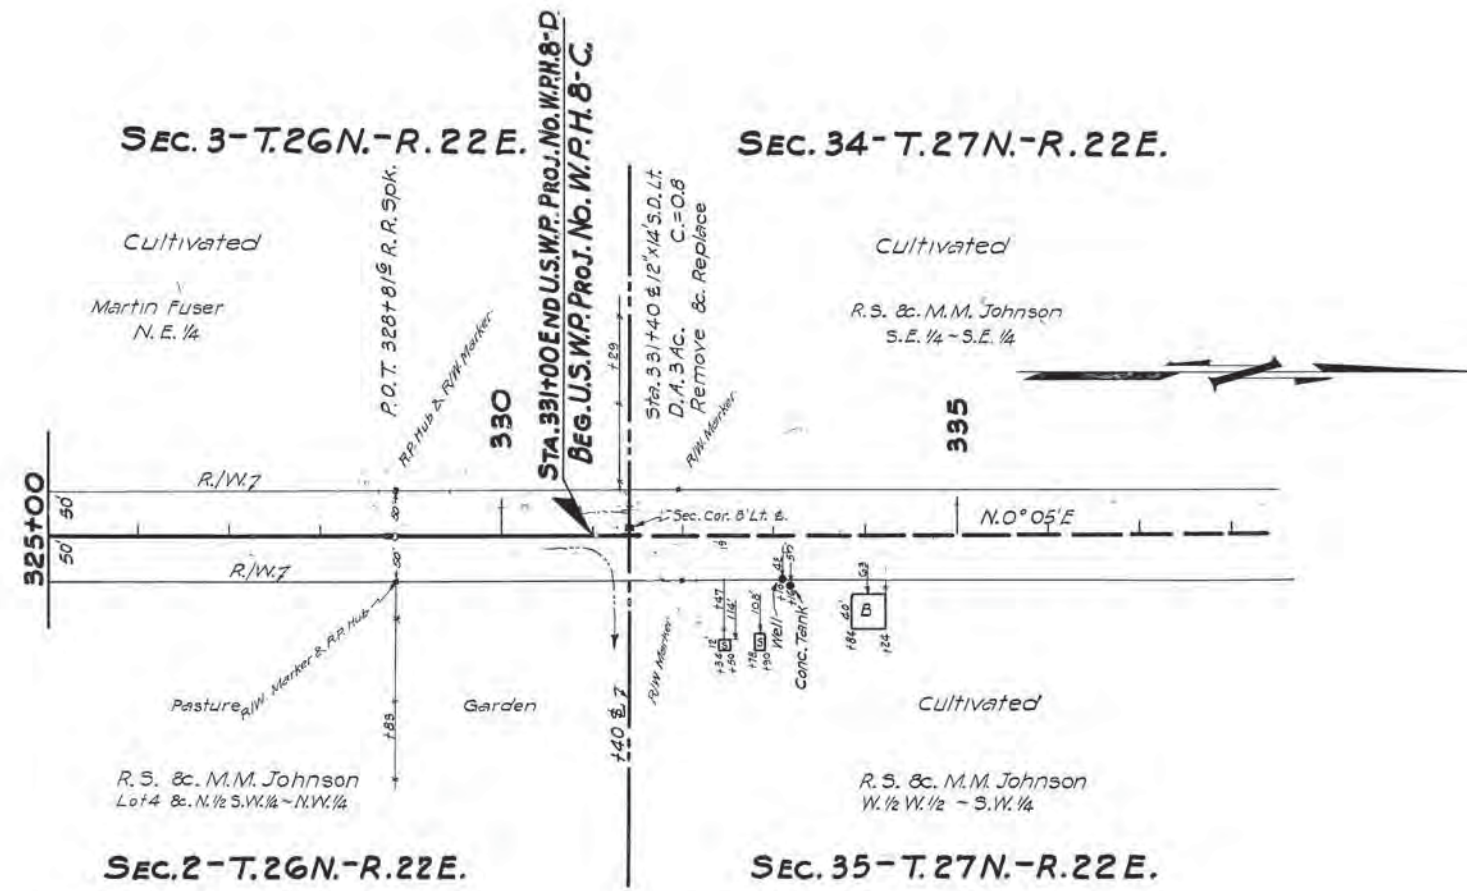



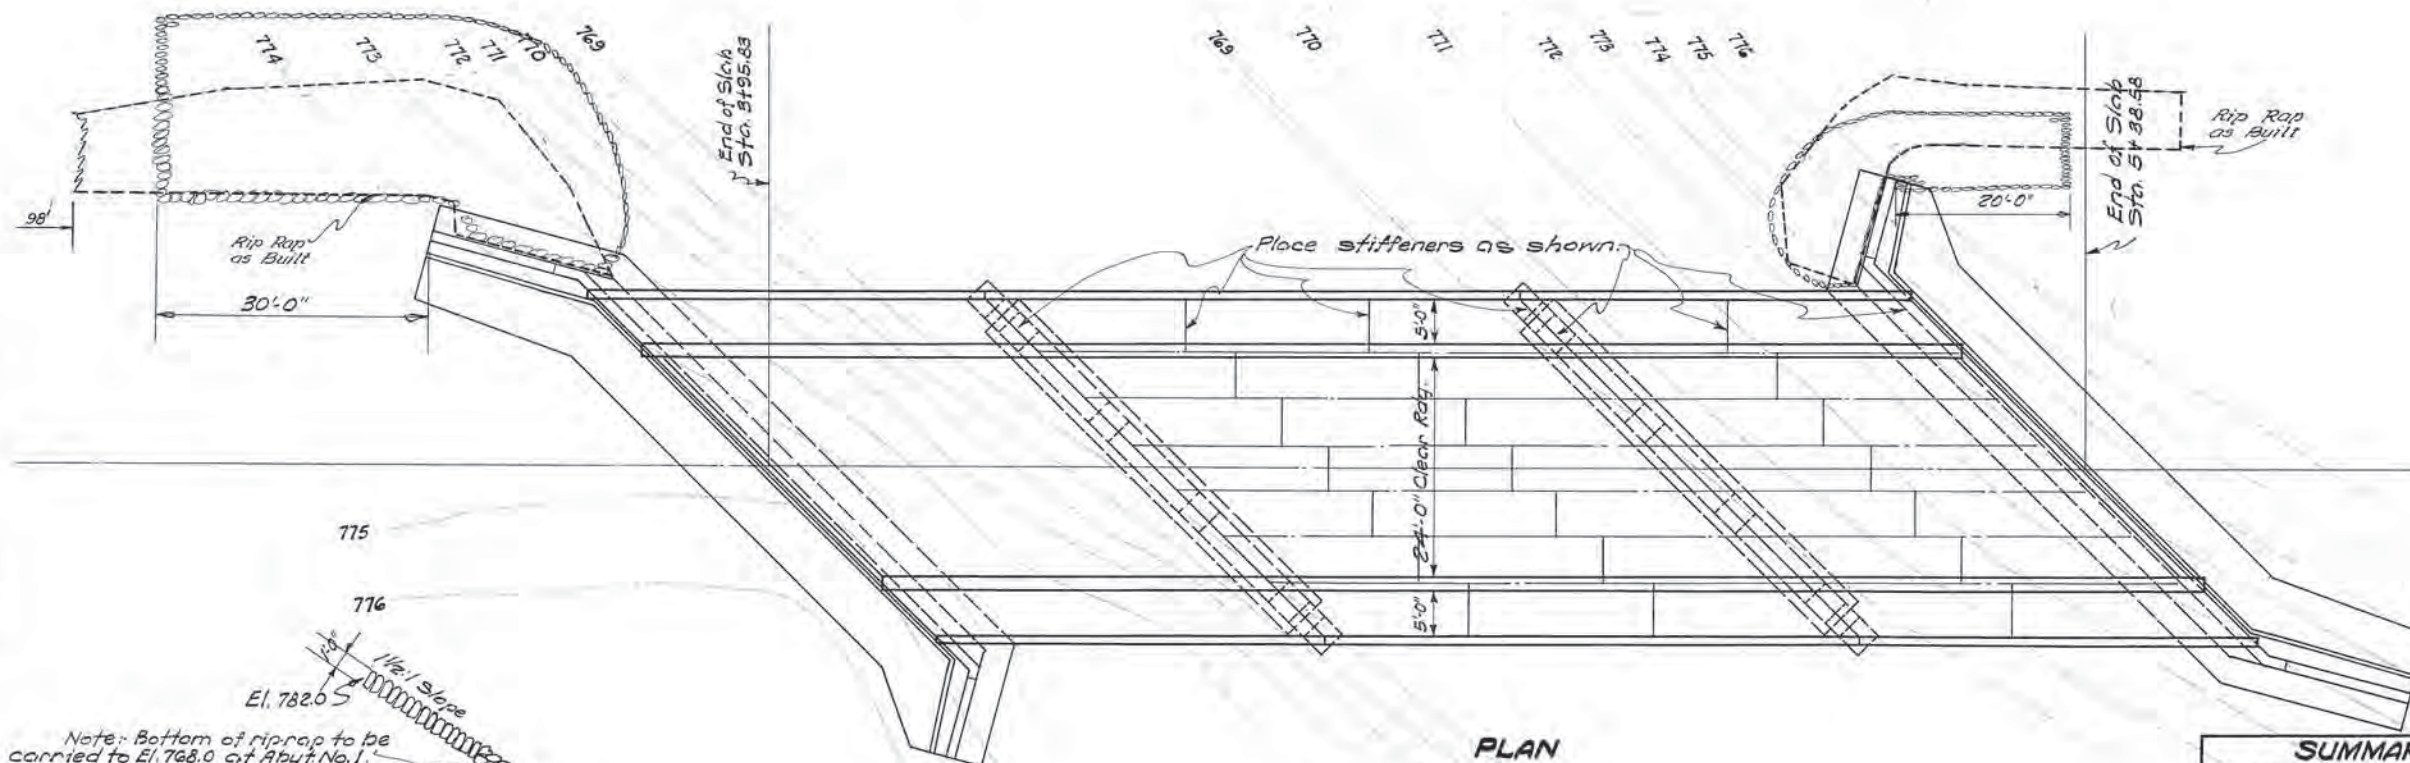


Note: Bottom of rip-rap to be carried to El. 768.0 at Abut. No. 1.  
Bottom of rip-rap to be carried 2'-0" below natural ground line at Abut. No. 2

SECTION THROUGH RIPRAP  
The bridge contractor shall dig trench and rip-rap as shown to Elev. 768.0  
Rip-rap will be paid for at the unit price per sq. yd. of surface regardless of thickness.

SUMMARY OF QUANTITIES						
Item Nos.	74.07	75.55a	81.26a	81.26d	83.05	102.04
Location	Reinf. Conc. HandRail Lin. Ft.	Struct. Steel-Lbs.	Concrete-Class A	Concrete-Class AA	Reinf. Steel-Lbs.	Load-Up Rip-Rap Sq. Yds.
Abutments			519.8		30,620	200
Piers		142,077	151.05	144.3	13,360	
Superstructure	580	142,077	151.05	144.3	13,360	
Totals	580	142,077	670.85	144.3	43,980	200

B.M. Center of end of Pavement Sta. 0+00 Elev. 782.33  
B.M. 2 spikes in top of 18" Hackberry stump 65' Rt. Sta. 6+25. Elev. 777.10

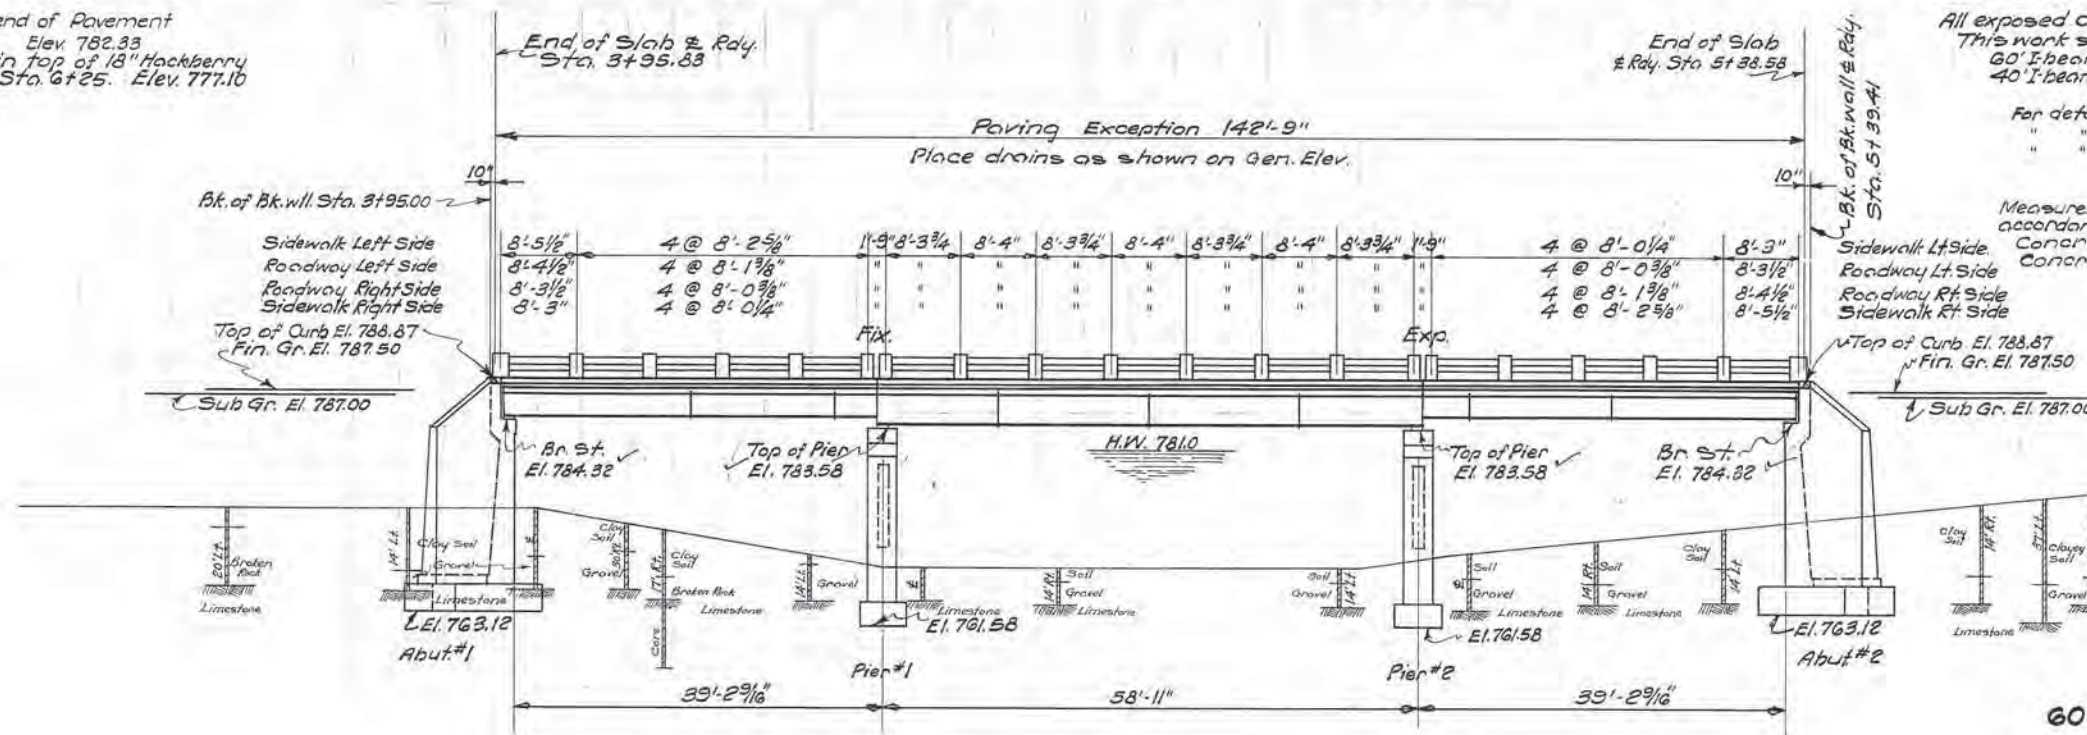

All exposed concrete surfaces are to have a carborundum finish.  
This work shall be constructed according to Okla. Std. Spec. of 1932.  
60' I-beams shall be rolled with 1 1/4" camber.  
40' I-beams shall be rolled with 3/4" camber.


For details of Superstructure see Std. I.B.-G, Sht. No. 28 & Sht. No. 27.  
" " " Abutments see Sht. No. 25.  
" " " Piers see Sht. No. 26.

Measurement of fine and coarse aggregate shall be by weight in accordance with the second & third paragraphs of Section No. 81.07.  
Concrete mixer shall comply with the requirements of Sec. No. 81.08.  
Concrete materials shall be handled as specified in Sec. No. 82.20.


D.A. 17 Sq. Mi.  
C.O.B.  
Reqd. Area 850±

REVISED AS BUILT  
HORSE CREEK  
GENERAL ELEVATION AND PLAN  
SUMMARY OF QUANTITIES  
60' AND 2-40' I.B.M. SPANS WITH 2-5'-0" SIDEWALKS  
24'-0" ROADWAY 45° SKEW RT. FWD.  
± STA. 4 + 67.21  
U.S.W.P.H. PROJ. NO. W.P.H. 8 SEC. "D-BR."





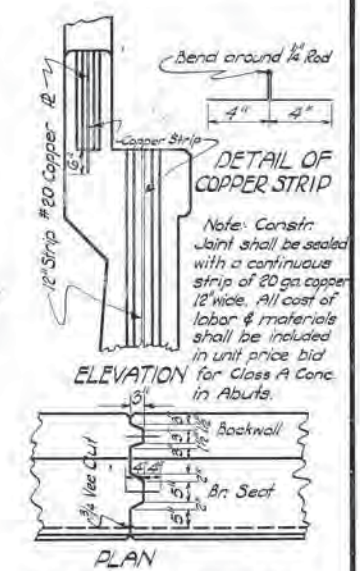

DETAIL OF PEDESTAL


  
 H3 - 1/2"  $\phi$  x 4'-2"  
 D2 - 1/2"  $\phi$  x 6'-9"


Mark	No	Size	Form	Length
F <sub>1</sub>	232	1/4" φ	Str	11'-8"
F <sub>2</sub>	36	"	"	23'-11"
WF <sub>1</sub>	82	"	"	10'-7"
WF <sub>2</sub>	16	"	"	20'-4"
WF <sub>3</sub>	20	"	"	8'-10"
WF <sub>4</sub>	34	"	"	5'-0"
WF <sub>5</sub>	8	"	"	13'-4"
N <sub>1</sub>	6	"	"	7'-2"
V <sub>1</sub>	66	1" φ	Ant	10'-2"
V <sub>2</sub>	33	"	"	14'-2"
V <sub>3</sub>	85	"	"	22'-3"
V <sub>4</sub>	40	3/4" φ	"	8'-2"
V <sub>5</sub>	16	"	"	5'-3"
WV <sub>1</sub>	22	1" φ	"	10'-2"
WV <sub>2</sub>	11	"	"	14'-2"
WV <sub>3</sub>	9	"	"	24'-9" Av.
WV <sub>4</sub>	3	"	"	26'-0"
WV <sub>5</sub>	1	"	"	22'-3"
WV <sub>6</sub>	12	"	"	10'-2"
WV <sub>7</sub>	6	"	"	14'-2"
WV <sub>8</sub>	6	"	"	28'-11" Av.
WV <sub>9</sub>	2	1/2" φ	Str	5'-7"
H <sub>1</sub>	4	1/2" φ	Ant	31'-9"
H <sub>2</sub>	4	"	"	31'-9"
H <sub>3</sub>	18	"	"	4'-2"
H <sub>4</sub>	2	"	Str	23'-8"
H <sub>5</sub>	3	"	Ant	27'-9"
H <sub>6</sub>	3	"	"	30'-5"
H <sub>7</sub>	11	"	"	31'-2" Av.
H <sub>8</sub>	11	"	"	31'-7 1/2" Av.
H <sub>9</sub>	21	"	"	28'-1"
H <sub>10</sub>	21	"	"	30'-6"
WH <sub>1</sub>	1	"	Str	4'-6"
WH <sub>2</sub>	1	"	Ant	15'-4"
WH <sub>3</sub>	1	"	"	20'-2"
WH <sub>4</sub>	12	"	"	24'-8" Av.
WH <sub>5</sub>	1	"	"	5'-11"
WH <sub>6</sub>	1	"	"	8'-3"
WH <sub>7</sub>	1	"	"	12'-5"
WH <sub>8</sub>	11	"	"	14'-8" Av.
WH <sub>9</sub>	4	"	Str	10'-0" Av.
WH <sub>10</sub>	1	"	"	13'-10"
WH <sub>11</sub>	23	"	Ant	21'-10"
WH <sub>12</sub>	4	"	Str	4'-1/2" Av.
WH <sub>13</sub>	3	"	Ant	11'-10" Av.
WH <sub>14</sub>	20	"	"	13'-8"
H <sub>11</sub>	2	"	Str	7'-4"
WV <sub>10</sub>	7	"	"	13'-4" Av.
WV <sub>11</sub>	2	"	"	20'-8"
WV <sub>12</sub>	5	"	"	17'-7" Av.
V <sub>6</sub>	31	"	"	16'-11"
P <sub>1</sub>	8	"	"	2'-5"
P <sub>2</sub>	6	"	Ant	6'-5"

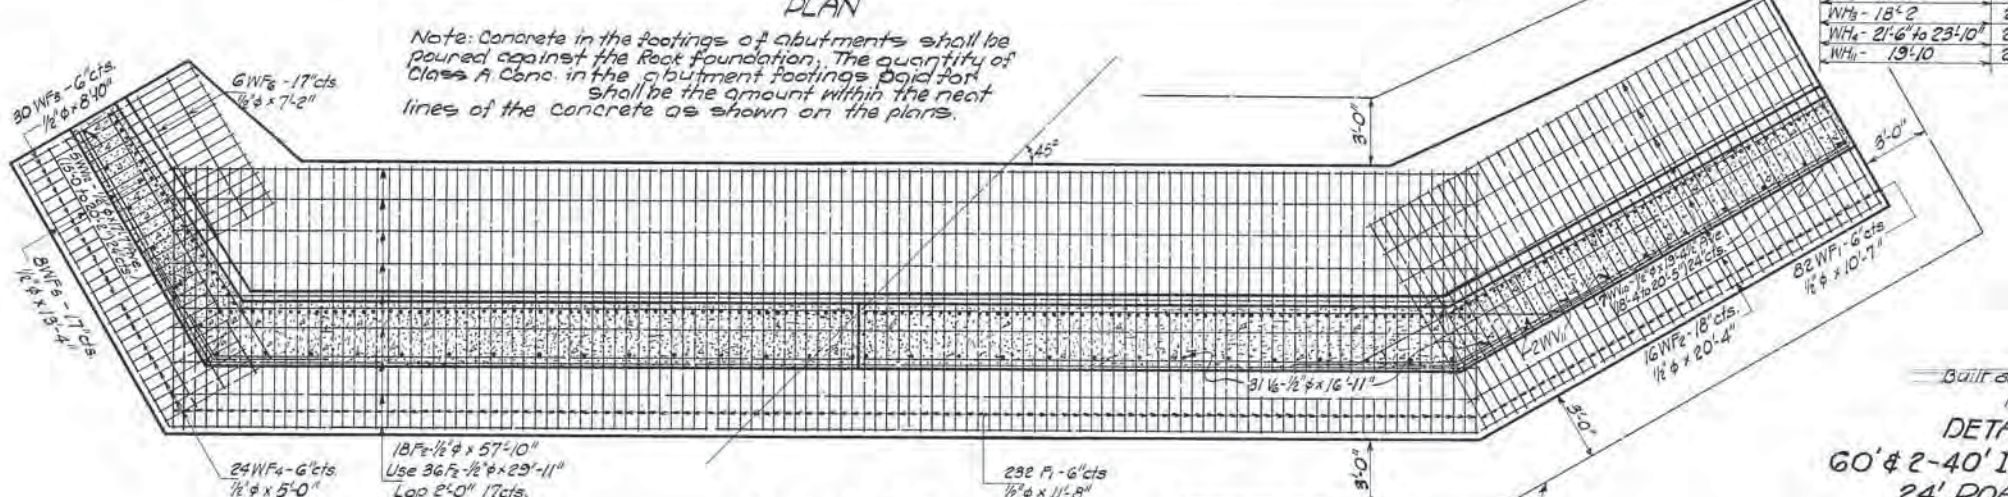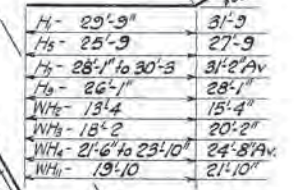

Note: Excavation for base must not disturb the original ground outside this line.

Drawn by Forbis May 1935  
Traced by Blackford May 1935  
Checked by Zwick " 4












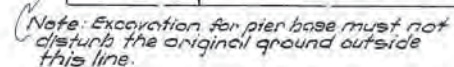

25 26




FED. ROAD DIST. NO.	STATE	USW.F.H. Proj. No. W. P. H.	FISCAL YEAR	SHEET NO.	TOTAL SHEETS
6	OKLA.	8-D-Br.	1936	21	58

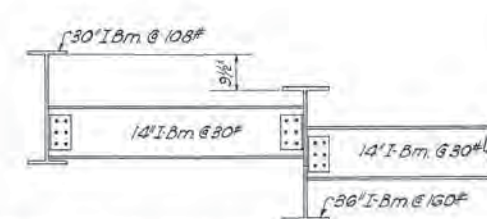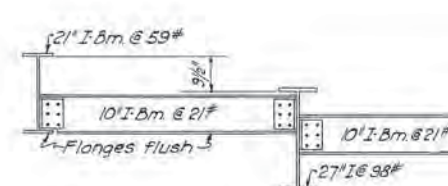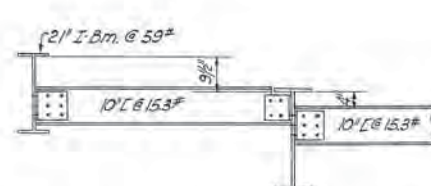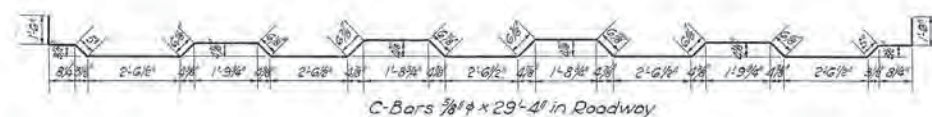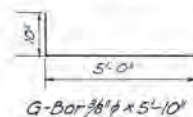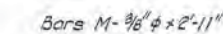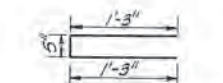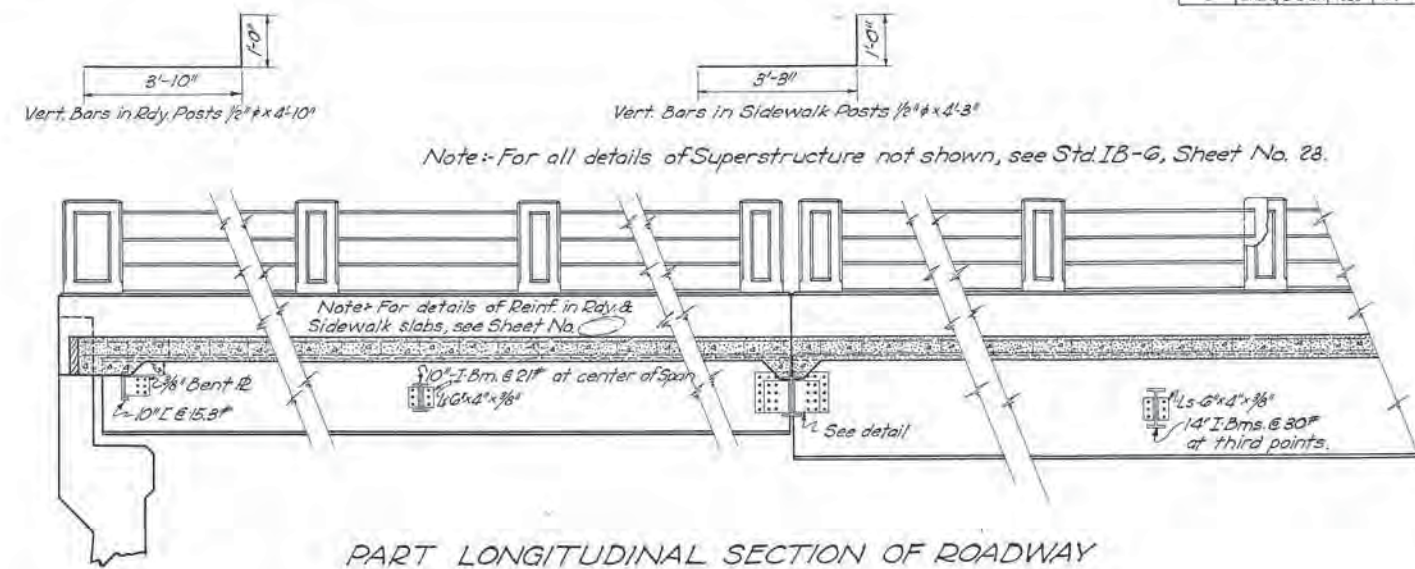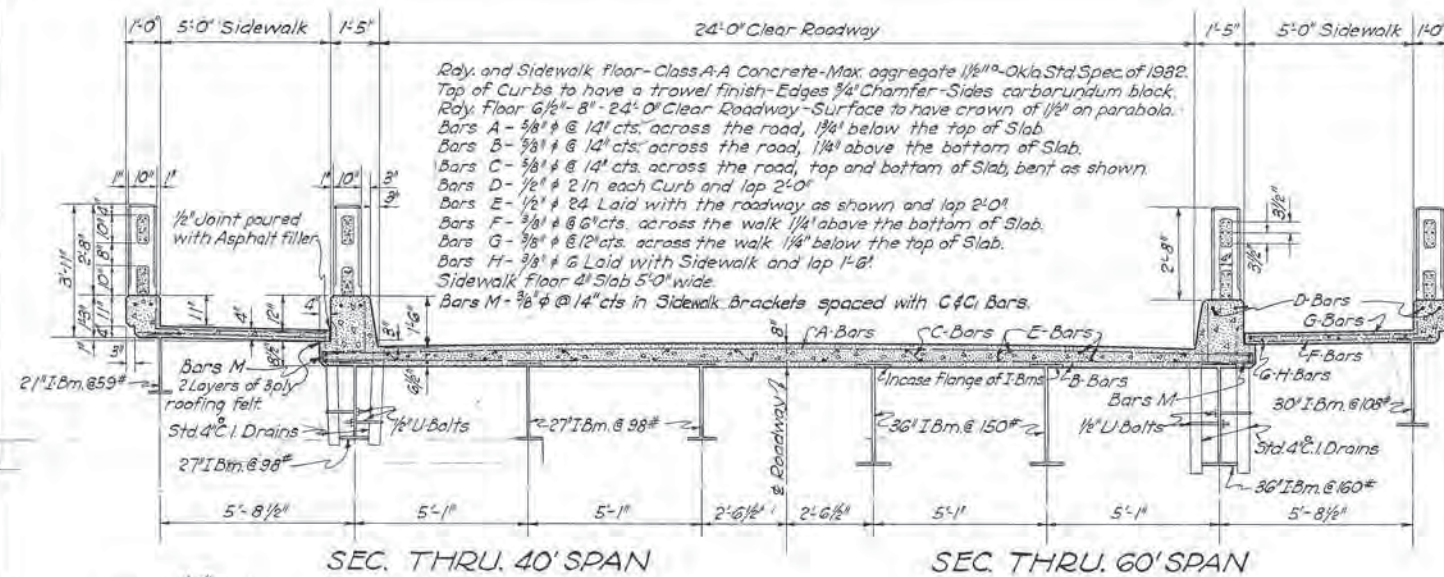


DETAILS OF STIFFENERS AT ABUT.

DETAILS OF INT. STIFFENERS-40' SPANS


### DETAILS OF INT. STIFFENERS - 60' SPANS

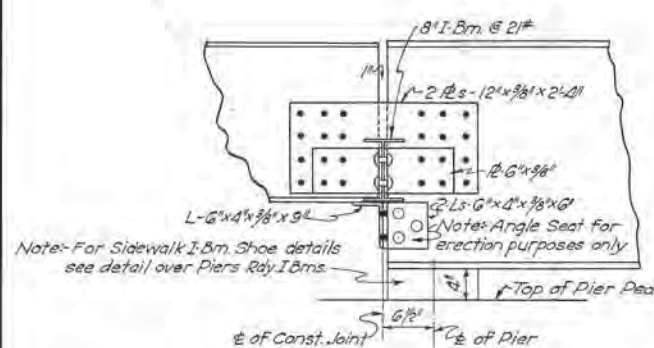

DETAIL OVER PIERS  
SIDEWALK I-BMS.

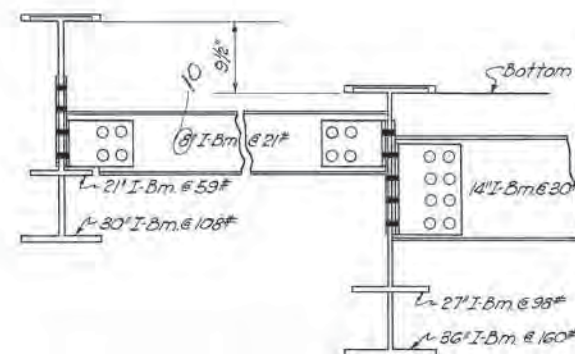

DETAIL OF STIFFNERS  
OVER PIERS

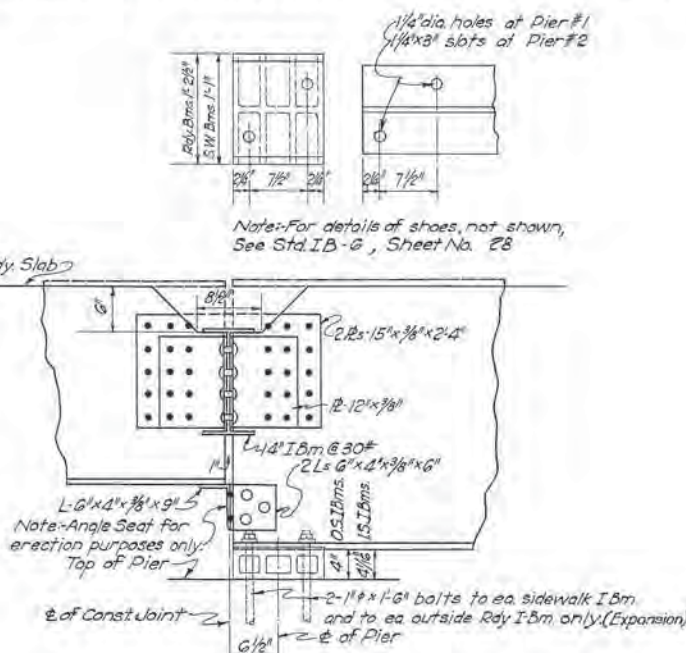

DETAIL OVER PIERS  
ROADWAY I-BMS.

Note: All beams shall be anchored at fixed pier with 2-1"  $\phi$  anchor bolts set a minimum of 1'-0" into concrete.

HORSE CREEK  
DETAILS OF SUPERSTRUCTURE  
1-60' & 2-40' I-BM. SPANS  
24'-0" ROADWAY & 2-5'-0" SIDEWALKS  
SKEWED 45° RIGHT FWD.  
CL STA. = 4+67.21  
U.S.W.P.H. PROJ. NO. W.P.H. 8-SEC."D-BR."

THIS PAGE INTENTIONALLY LEFT BLANK

## **Appendix E.     Hydraulic Analysis, 2016**

**THIS PAGE INTENTIONALLY LEFT BLANK**



March 2016, KLE

Project No. Ottawa County  
JP # BRFY-158B(119)  
24273(04)

US 60 over Horse Creek  
NBIS # 05017

**Hydraulic Summary**

Total Drainage Area = 22.70 sq. mi  
Controlled Drainage Area = 0.00 sq. mi  
Effective Drainage Area = 22.70 sq. mi

**Existing Structure:**

C/L Station  
NBIS #

42'-60'-42' I Beams,  
Skewed 45°  
344+94  
05017

L = 142 ft  
 $Q_{OT} \approx Q_{255}$

Low Bm Elev = 781.10  
Rdwy<sub>OT</sub> Elev = 780.82  
Rdwy<sub>OT</sub> Sta = 339+36

**Proposed Structure:**

C/L Station

70'-100'-70' Type IV PC  
Beam, Skewed 45°  
344+94

L = 245.5 ft/ft  
 $Q_{OT} \approx Q_{OT>Q500}$

Low Bm Elev = 780.00  
Rdwy<sub>OT</sub> Elev = 780.82  
Rdwy<sub>OT</sub> Sta = 339+36

**Detour Structure:**

C/L Station

3-108" RCPs  
2346+11

Slope = 0.003 ft/ft  
 $Q_{OT} \approx Q_{2.25}$

Inlet Elev = 765.45  
Detour<sub>OT</sub> Elev = 775.72  
Detour<sub>OT</sub> Sta = 2345+89

Freq.	Q (cfs)	CHW (ft)	V (fps)	Contraction Scour (ft)	Pier Scour (ft)	Total Scour (ft)
2	1700	773.90	3.94			
5	3150	775.55	5.79			
10	4470	776.62	7.26			
25	6590	778.18	9.10			
50	8300	779.40	11.16			
100	15100	780.60	13.44	2.97	32.89	35.86
Rdwy OT > Q500	3040	783.02	8.19	11.77	18.01	29.78
Detour OT = 2.25	1820	775.72	10.23			

**Notes:**


1. According to the Geotechnical Engineering Report, the depth to bedrock is 10.58 feet. Therefore, the scour will probably not extend as deep as predicted.

*Hydraulic Design is in compliance with  
"Federal-Aid Policy Guide 23 CFR 650, Subpart A"*



*Kristi Erickson*  
03/07/2016

US-60 over Horse Creek, Ottawa Co. Plan: Proposed Run - 45d skew - 70-100-70 3/7/2016  
RS = 594 BR Proposed Bridge - US 60 over Horse Creek

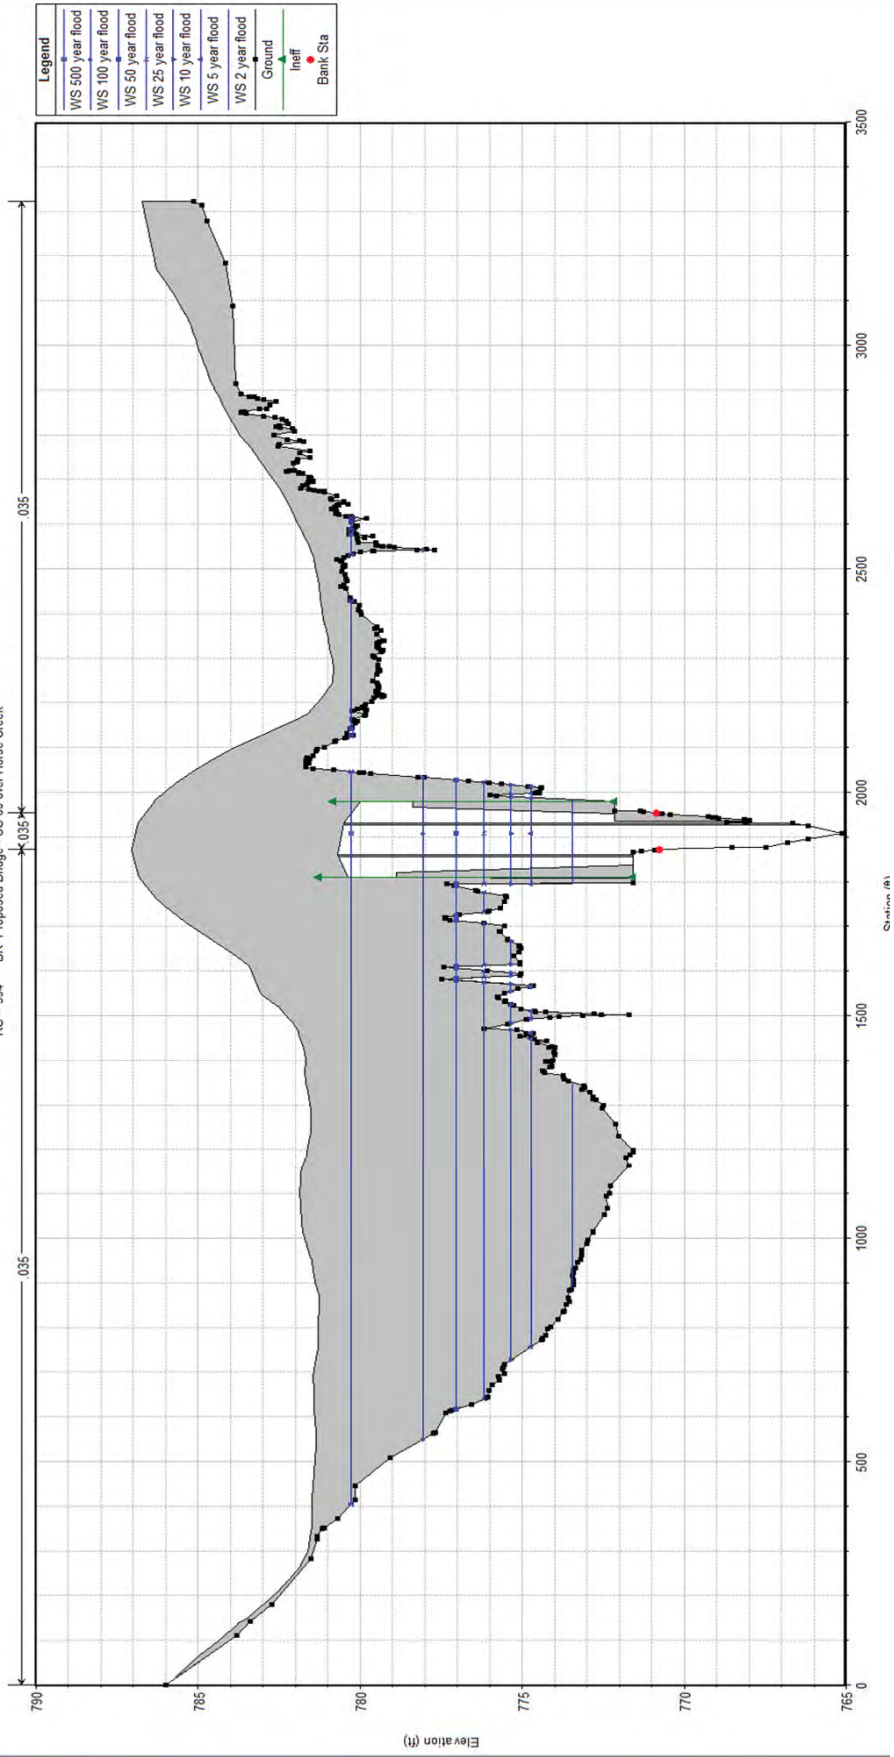

Date	February 2016
Engineer	KLE
Revisions	1. Revised Proposed 103'-100'-103' Span Bridge, Skewed 45°

County	Ottawa
JP#	24273(04)
Highway	US 60
Crossing	Horse Creek


DA: 22.7 SQ MI

Discharges (CFS)		NBIS #		05017		Computed Water Surface Elevations (FT)								Velocity (FPS)			
		Open Channel	Exist : 42'-60'-42' I Beams, Skewed 45°		Backwater	Prop: 70'-100'-70' Type IV PC Beam, Skewed 45°		Backwater			Backwater	Open Channel	Existing	Prop			
			Low Beam (ft)	781.10		Low Beam (ft) = or FL in =	780.00		Low Beam (ft) = or FL in =								
Q2 =	1,700	773.72	773.90	0.18	773.90	0.18		N/A	3.07	4.85	3.94						
Q5 =	3,150	775.30	775.75	0.45	775.55	0.25		N/A	4.39	7.06	5.79						
Q10 =	4,470	776.29	777.00	0.71	776.62	0.33		N/A	5.59	9.16	7.26						
Q25 =	6,590	777.63	778.92	1.29	778.18	0.55		N/A	7.52	11.41	9.10						
Q50 =	8,300	778.70	780.40	1.70	779.40	0.70		N/A	9.10	13.79	11.16						
Q100 =	10,000	779.67	781.73	2.06	780.60	0.93		N/A	10.66	14.84	13.44						
Q500 =	15,100	782.29	784.94	2.65	783.02	0.73		N/A	13.86	15.38	8.19						
		Overtopping Elev (ft) =	780.82		Overtopping Elev (ft) =	780.82		Overtopping Elev (ft) =									
		Overtopping Q (cfs) ≈	11,975		Overtopping Q (cfs) ≈	OT>Q500		Overtopping Q (cfs) ≈									
		Overtopping Freq (yr) ≈	255		Overtopping Freq (yr) ≈	OT>Q500		Overtopping Freq (yr) ≈									

**THIS PAGE INTENTIONALLY LEFT BLANK**

# Typical Flowline Profile

## Horse Creek Flowline

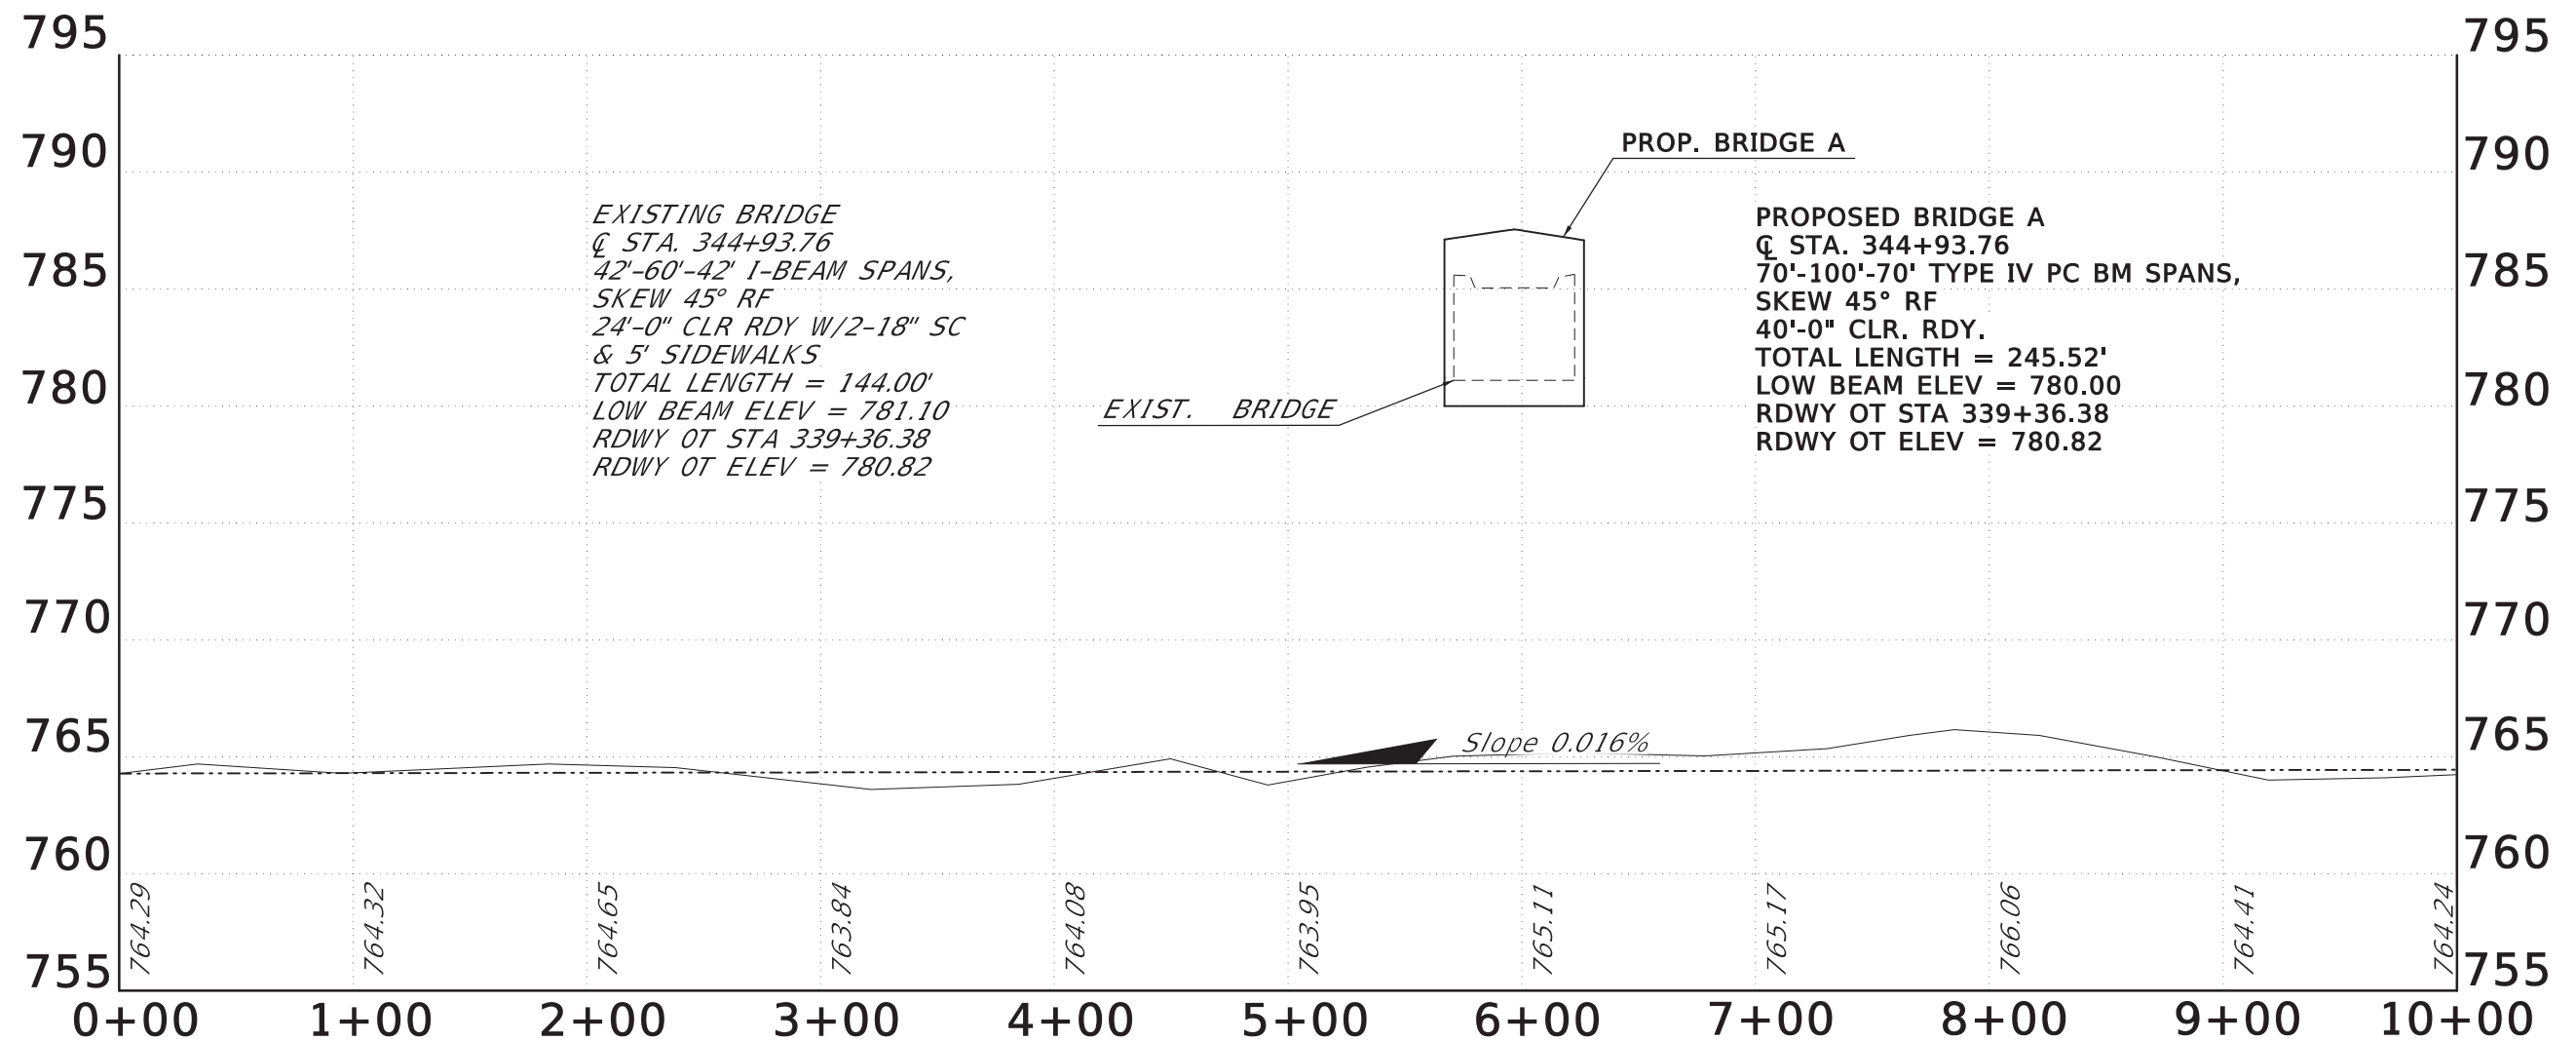




DIRECT LOAD (SERVICE I)	= XXX.X TONS/SHAFT
DIRECT LOAD (STRENGTH I)	= XXX.X TONS/SHAFT
FRICITION CAPACITY (XX.X TSF)	= XXX.X TONS/SHAFT
END BEARING CAPACITY (XX.X TSF)	= XXX.X TONS/SHAFT
TOTAL CAPACITY	= XXX.X TONS/SHAFT




DESIGN	SAK	01/16	OKLAHOMA DEPARTMENT OF TRANSPORTATION			
DRAWN	BEW	01/16	US 60 OVER HORSE CREEK		BRIDGE "A"	
CHECKED		01/16	GENERAL PLAN AND ELEVATION			
APPROVED	SOT	01/16	CONST. 70'-100'-70' W/ IV P.C. BEAMS SPANS WITH CONCRETE RAIL (TR-4) WITH 40'-0" CL. RDY. SKEW 45°RF AT ℄ US 60 SURVEY STATION 344+93.76			
SQUAD	LEIDOS					
COUNTY	OTTAWA		HIGHWAY	US-60	STATE JOB NO.	24273(04)
						SHEET NO. XXX

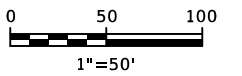

**LEGEND**

	
ASPH. RDWY.	ASPH. SHLDR.

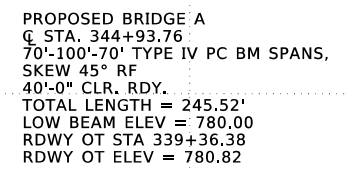

**THIS PAGE INTENTIONALLY LEFT BLANK**



**Appendix F.      Preliminary Plans for Bridge and Approaches, US 60  
Over Horse Creek, 2016 (Select Sheets)**

**THIS PAGE INTENTIONALLY LEFT BLANK**

STATE OF OKLAHOMA  
DEPARTMENT OF TRANSPORTATION

PLAN OF PROPOSED  
UNITED STATES HIGHWAY

PROJECT NO. BRFY-158B(119)  
BRIDGE AND APPROACHES  
US 60 OVER HORSE CREEK

OTTAWA COUNTY

CONTROL SECTION 60-58-06  
STATE JOB NO. 24273(04)

BRIDGE A LOCATION NO. 5806 0256X EXISTING NBI NO. 05017, NEW NBI NO. ?

FOR SURVEY CONTROL DATA,  
SEE SURVEY DATA SHEETS

OKLAHOMA DEPARTMENT OF TRANSPORTATION

Preliminary Plan Field  
Review Meeting  
MARCH 2016

INDEX OF SHEETS

ROADWAY DRAWINGS

- 1 TITLE SHEET  
2 TYPICAL SECTIONS  
3 STORM WATER MANAGEMENT PLAN  
4 MISCELLANEOUS DETAILS  
5 - 6 PLAN & PROFILE - US 60 (1) - (2)  
7 - 8 SUGGESTED CONSTRUCTION SEQUENCE (1) - (2)

BRIDGE DRAWINGS

- 9 GENERAL PLAN AND ELEVATION  
10 TYPICAL SECTION

SURVEY DATA

- S1 - S10 SURVEY DATA SHEET (1) - (10)

CROSS SECTIONS

- X1 - X9 CROSS SECTIONS - US 60  
X10 - X16 CROSS SECTIONS - DETOUR

DESIGN DATA

AADT 2016	7,000
AADT 2036	11,200
K (DHV / ADT-TWO WAY)	10%
D (DIRECTIONAL DIST.)	55%
T (% OF DHV)	18%
T (% OF AADT)	23%
T <sub>3</sub> OVERLOADS (AXLES)	16%
20-YR FLEX ESALs	13.9 MIL

US 60	V=45 MPH
US 60 DETOUR	V=25 MPH

CONTROL SUB-SECTION No. 2.5

STA. 336+24.36  
BEGIN INCIDENTAL CONSTRUCTION

STA. 341+24.36  
END INCIDENTAL CONSTRUCTION  
& BEGIN PROJECT

STA. 353+63.06  
END INCIDENTAL CONSTRUCTION

STA. 348+63.06  
END PROJECT & BEGIN  
INCIDENTAL CONSTRUCTION

BEGIN STA. 343+71.00

LENGTH = 245'-6 1/4" BRIDGE "A"

END STA. 346+16.52

NOTE: PROJECT LENGTH BASED ON C SURVEY STATIONING.

ROADWAY LENGTH ..... 493.18 FT. 0.093 MI.  
BRIDGE LENGTH ..... 245.52 FT. 0.046 MI.  
PROJECT LENGTH ..... 0.139 MI.

EQUATIONS : NONE  
EXCEPTIONS : NONE

THE FOLLOWING ODOT STANDARDS WILL BE REQUIRED

ROADWAY TRAFFIC SIGNING TRAFFIC CONTROL TRAFFIC SAFETY BRIDGE DESIGN

(TO BE ADDED AT LATER DATE)

SCALES 1" = 50'



PLAN 1" = 50'

PROFILE HOR. 1" = 50'




VER. 1" = 5'

LAYOUT MAP 1" = 2000'

CONVENTIONAL SYMBOLS

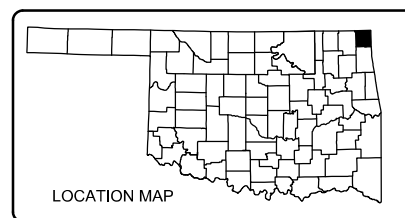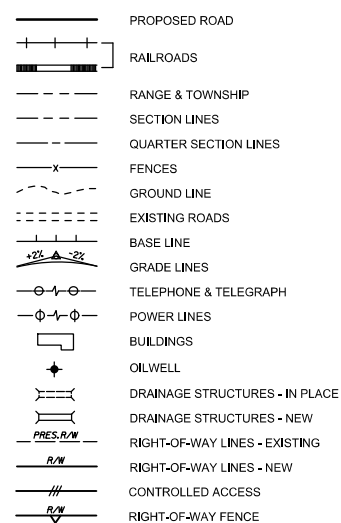



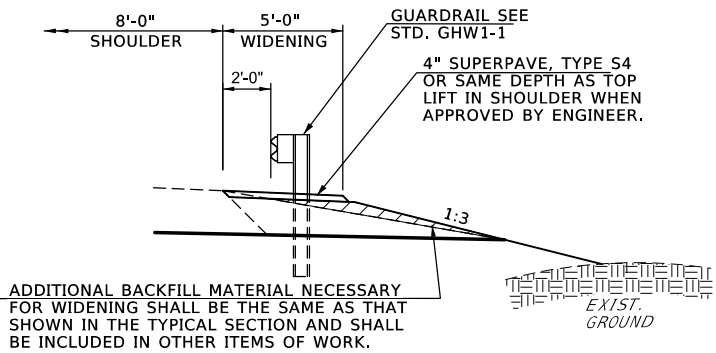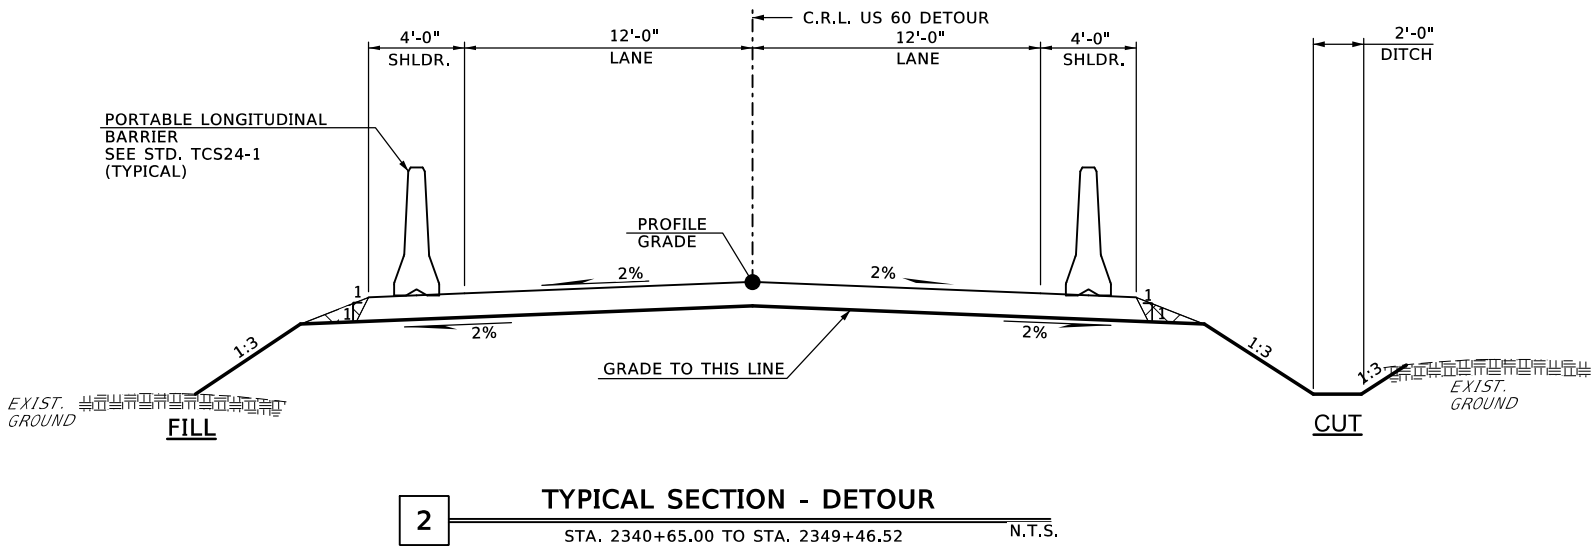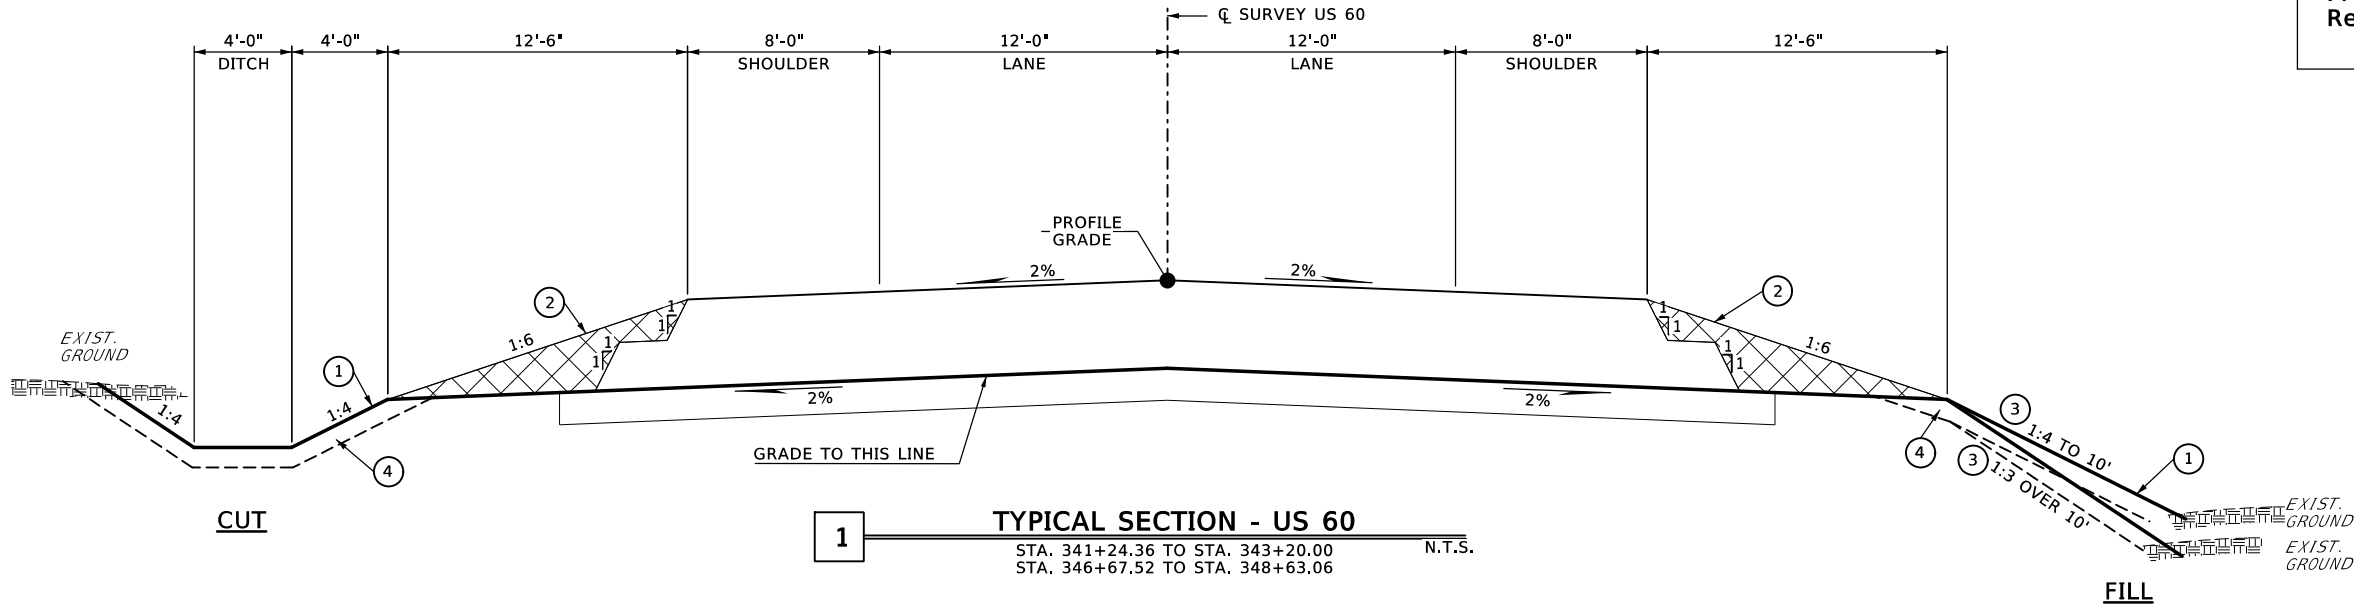

- 1 PERMANENT SLOPE PROTECTION REFER TO DETAIL SHEET 5.
  - 2 TO BE BACKFILLED & COMPACTED AS PART OF THE FINISHING OPERATIONS. COST TO BE INCLUDED IN TBSC TYPE E.
  - 3 FILL SLOPE DEPTHS ARE DEFINED FROM EDGE OF SHOULDER.
  - 4 TOPSOIL NOTE : THE CONTRACTOR SHALL STRIP ALL OF THE AVAILABLE TOPSOIL, STOCKPILE IT AND PLACE IT BACK ON THE SECTION IN ACCORDANCE WITH SECTION 205 OF THE STANDARD SPECIFICATIONS. RESERVED TOPSOIL SHALL BE SPREAD FIRST ON THE COMPLETE SLOPES OF THE CUT SECTIONS AND THE REMAINDER ON COMPLETED FILL SLOPES OR OTHER PRIORITY AREAS LOCATED BY THE ENGINEER. ALL ADDITIONAL COSTS ASSOCIATED WITH OPERATION SHALL BE INCLUDED IN THE PAY ITEMS FOR SALVAGED TOPSOIL, LUMP SUM.
- THE GRADING LINE AS SHOWN ON THE TYPICAL AND CROSS SECTIONS IS TO TOP OF THE SOIL. EARTHWORK QUANTITIES WERE NOT ADJUSTED FOR SALVAGE AND TOPSOIL QUANTITY IS INCLUDED IN THE SUMMARIZED EARTHWORK.

DESIGN				OKLAHOMA DEPARTMENT OF TRANSPORTATION
DRAWN				
CHECKED				
APPROVED				
SQUAD				
COUNTY	OTTAWA	HIGHWAY	US-60	STATE JOB NO. 24273(04) SHEET NO. 2

STORM WATER MANAGEMENT PLAN

SITE DESCRIPTION

PROJECT LIMITS: THE EXTENTS OF IMPROVEMENTS TO US 60 FROM 92' NORTHEAST OF  
SOUTHEAST AVENUE TO 3,086' SOUTHWEST OF SOUTH 520 ROAD IN AFTON, OK.

PROJECT DESCRIPTION: DRAINAGE, GRADING, SURFACING, STRIPING, CONSTRUCTION TRAFFIC CONTROL  
AND BRIDGE.

SUGGESTED SEQUENCE OF EROSION CONTROL ACTIVITIES:

1) PRIOR TO INITIATING SOIL DISTURBING ACTIVITIES, THE CONTRACTOR WILL INSTALL ALL PERIMETER TEMPORARY SEDIMENT CONTROLS SPECIFIED.

2) STRIP, STOCKPILE AND STABILIZE TOPSOIL.

3) CLEAR AND GRUB ONLY IN NECESSARY AREAS, PRESERVING AS MUCH NATIVE VEGETATION AS POSSIBLE.

4) INSTALL,MAINTAIN AND/OR MOVE TEMPORARY SEDIMENT ITEMS WITH CONSTRUCTION OPERATIONS AS PRACTICAL.

5) IF DIRECTED BY THE ENGINEER, PLANT TEMPORARY SEEDING.

6) REPLACE SALVAGED TOPSOIL AND DEVICES WHEN AN ACCEPTABLE VEGETATIVE COVER (AT LEAST 70%) HAS BEEN ATTAINED.

7) AS SITE CONDITIONS WARRANT, THE CONTRACTOR MAY CHOOSE TO MODIFY THE TYPE OR ARRANGEMENT OF SPECIFIED PRACTICES TO IMPROVE THEIR EFFECTIVENESS AS APPROVED BY THE ENGINEER.

8) THE CONTRACTOR WILL MAINTAIN A LOG OF THE DATES OF MAJOR SOIL DISTURBANCE ACTIVITIES, AND ALSO THE DATES OF INSTALLATION OF EROSION CONTROL MEASURES.

SOIL TYPE: LIGHTNING SILT LOAM, PARSONS SILT LOAM

AREA TO BE DISTURBED: 2.68 ACRES

OFFSITE AREA TO BE DISTURBED:  
(FOR CONTRACTOR USE)

MAXIMUM ACRES TO BE  
DISTURBED AT ANY ONE TIME:  
(FOR CONTRACTOR USE)

LATITUDE & LONGITUDE  
OF CENTER OF PROJECT: 36° 41' 49" N ; 94° 57' 24" W

NAME OF RECEIVING WATERS: HORSE CREEK

SENSITIVE WATERS OR WATERSHEDS: YES NO ☒

303(d) IMPAIRED WATERS: YES ☒ NO

NOTE:  
THIS SHEET SHOULD BE USED IN CONJUNCTION WITH A DRAINAGE MAP THAT ILLUSTRATES THE DRAINAGE PATTERNS/PATHWAYS AND RECEIVING WATERS FOR THIS PROJECT. THIS SHEET SHOULD ALSO BE USED WITH THE EROSION CONTROL SUMMARIES, PAY ITEMS, & NOTES.

EROSION AND SEDIMENT CONTROLS

SOIL STABILIZATION PRACTICES:

- TEMPORARY SEEDING
- PERMANENT SODDING, SPRIGGING OR SEEDING
- VEGETATIVE MULCHING
- SOIL RETENTION BLANKET
- PRESERVATION OF EXISTING VEGETATION

NOTE: TEMPORARY EROSION CONTROL METHODS MUST BE USED ON ALL DISTURBED AREAS WHERE CONSTRUCTION ACTIVITIES HAVE CEASED FOR OVER 14 DAYS. METHODS USED WILL BE AS SHOWN ON PLANS, OR AS DIRECTED BY THE ENGINEER.

STRUCTURAL PRACTICES:

- STABILIZED CONSTRUCTION EXIT
- TEMPORARY SILT FENCE
- TEMPORARY SILT DIKES
- TEMPORARY FIBER LOG
- DIVERSION, INTERCEPTOR OR PERIMETER DIKES
- DIVERSION, INTERCEPTOR OR PERIMETER SWALES
- ROCK FILTER DAMS
- TEMPORARY SLOPE DRAIN
- PAVED DITCH W/ DITCH LINER PROTECTION
- TEMPORARY DIVERSION CHANNELS
- TEMPORARY SEDIMENT BASINS
- TEMPORARY SEDIMENT TRAPS
- TEMPORARY SEDIMENT FILTERS
- TEMPORARY SEDIMENT REMOVAL
- RIP RAP
- INLET SEDIMENT FILTER
- TEMPORARY BRUSH SEDIMENT BARRIERS
- SANDBAG BERMS
- TEMPORARY STREAM CROSSINGS

OFFSITE VEHICLE TRACKING:

- HAUL ROADS DAMPENED FOR DUST CONTROL
- LOADED HAUL TRUCKS TO BE COVERED WITH TARPULIN
- EXCESS DIRT ON ROAD REMOVED DAILY

NOTES:

NO DISTURBED AREA TO ONE PROJECT OUTFALL EXCEEDS  
5 ACRES.

THE CONTRACTOR SHALL ALSO BE RESPONSIBLE FOR THE FOLLOWING:

MAINTENANCE AND INSPECTION:

ALL EROSION AND SEDIMENT CONTROLS WILL BE MAINTAINED IN GOOD WORKING ORDER FROM THE BEGINNING OF CONSTRUCTION UNTIL AN ACCEPTABLE VEGETATIVE COVER IS ESTABLISHED. INSPECTION BY THE CONTRACTOR AND ANY NECESSARY REPAIRS SHALL BE PERFORMED ONCE EVERY 7 CALENDAR DAYS AND WITHIN 24 HOURS AFTER ANY STORM EVENT GREATER THAN 0.5 INCH AS RECORDED BY A NON-FREEZING RAIN GAUGE TO BE LOCATED ON SITE. POTENTIALLY ERODIBLE AREAS, DRAINAGEWAYS, MATERIAL STORAGE, STRUCTURAL DEVICES, CONSTRUCTION ENTRANCES AND EXITS ALONG WITH EROSION AND SEDIMENT CONTROL LOCATIONS ARE EXAMPLES OF SITES THAT NEED TO BE INSPECTED.

WASTE MATERIALS:

PROPER MANAGEMENT AND DISPOSAL OF CONSTRUCTION WASTE MATERIAL IS REQUIRED BY THE CONTRACTOR. MATERIALS INCLUDE STOCKPILES, SURPLUS, DEBRIS AND ALL OTHER BY-PRODUCTS FROM THE CONSTRUCTION PROCESS. PRACTICES INCLUDE DISPOSAL, PROPER MATERIALS HANDLING, SPILL PREVENTION AND CLEANUP MEASURES. CONTROLS AND PRACTICES SHALL MEET THE REQUIREMENTS OF ALL FEDERAL, STATE AND LOCAL AGENCIES.

HAZARDOUS MATERIALS:

PROPER MANAGEMENT AND DISPOSAL OF HAZARDOUS WASTE MATERIALS IS REQUIRED. THE CONTRACTOR IS RESPONSIBLE FOR FOLLOWING MANUFACTURER'S RECOMMENDATIONS, STATE AND FEDERAL REGULATIONS TO ENSURE CORRECT HANDLING, DISPOSAL, SPILL PREVENTION AND CLEANUP MEASURES. EXAMPLES INCLUDE BUT ARE NOT LIMITED TO: PAINTS, ACIDS, CLEANING SOLVENTS, CHEMICAL ADDITIVES, CONCRETE CURING COMPOUNDS AND CONTAMINATED SOILS.

GENERAL NOTES:

A STORM WATER POLLUTION PREVENTION PLAN (SWPPP) IS REQUIRED TO COMPLY WITH THE OKLAHOMA POLLUTION DISCHARGE ELIMINATION SYSTEM (OPDES) REGULATIONS. THIS PLAN IS INITIATED DURING THE DESIGN PHASE, CONFIRMED IN THE PRE-WORK MEETINGS AND AVAILABLE ON THE JOB SITE ALONG WITH COPIES OF THE NOTICE OF INTENT (NOI) FORM AND PERMIT CERTIFICATE THAT HAVE BEEN FILED WITH THE OKLAHOMA DEPARTMENT OF ENVIRONMENTAL QUALITY (ODEQ). THE PLAN MUST BE KEPT CURRENT WITH UP-TO-DATE AMENDMENTS DURING THE PROGRESSION OF THE PROJECT. ALL CONTRACTOR OFF-SITE OPERATIONS ASSOCIATED WITH THE PROJECT MUST BE DOCUMENTED IN THE SWPPP, I.E., BORROW PITS, WORK ROADS, DISPOSAL SITES, ASPHALT/CONCRETE PLANTS, ETC. THE BASIC GOAL OF STORM WATER MANAGEMENT IS TO IMPROVE WATER QUALITY BY REDUCING POLLUTANTS IN STORM WATER DISCHARGES. RUNOFF FROM CONSTRUCTION SITES HAS A POTENTIAL FOR POLLUTION DUE TO EXPOSED SOILS AND THE PRESENCE OF HAZARDOUS MATERIALS USED IN THE CONSTRUCTION PROCESS. THE PREVENTION OF SOIL EROSION, CONTAINMENT OF HAZARDOUS MATERIALS AND/OR THE INTERCEPTION OF THESE POLLUTANTS BEFORE LEAVING THE CONSTRUCTION SITE ARE THE BEST PRACTICES FOR CONTROLLING STORM WATER POLLUTION.


THE FOLLOWING SECTIONS OF THE 2009 ODOT STANDARD SPECIFICATIONS SHOULD BE NOTED:

- 103.05 BONDING REQUIREMENTS
- 104.10 FINAL CLEANING UP
- 104.12 CONTRACTOR'S RESPONSIBILITY FOR WORK
- 104.13 ENVIRONMENTAL PROTECTION
- 106.08 STORAGE AND HANDLING OF MATERIAL
- 107.01 LAWS, RULES AND REGULATIONS TO BE OBSERVED
- 107.20 STORM WATER MANAGEMENT
- 220 MANAGEMENT OF EROSION, SEDIMENTATION AND STORM WATER POLLUTION PREVENTION AND CONTROL
- 221 TEMPORARY SEDIMENT CONTROL


IN ADDITION:

"ODEQ GENERAL PERMIT (OKR10) FOR STORM WATER DISCHARGES FROM CONSTRUCTION ACTIVITIES WITHIN THE STATE OF OKLAHOMA." ODEQ, WATER QUALITY DIVISION, SEPTEMBER 13, 2012.


DESIGN			OKLAHOMA DEPARTMENT OF TRANSPORTATION	
DRAWN			STORM WATER MANAGEMENT PLAN	
CHECKED				
APPROVED				
SQUAD				
COUNTY - OTTAWA			HIGHWAY - US-60	STATE JOB NO. 24273(04) SHEET NO. 3

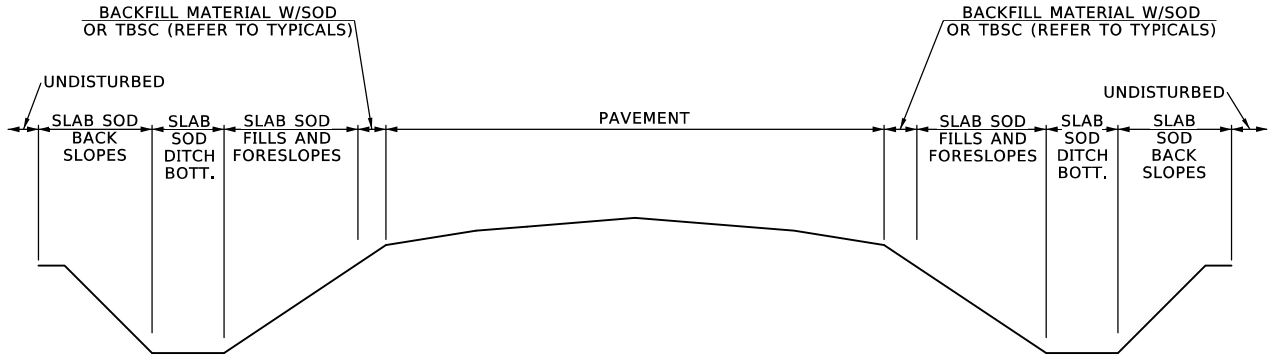

PERMANENT SLOPE PROTECTION

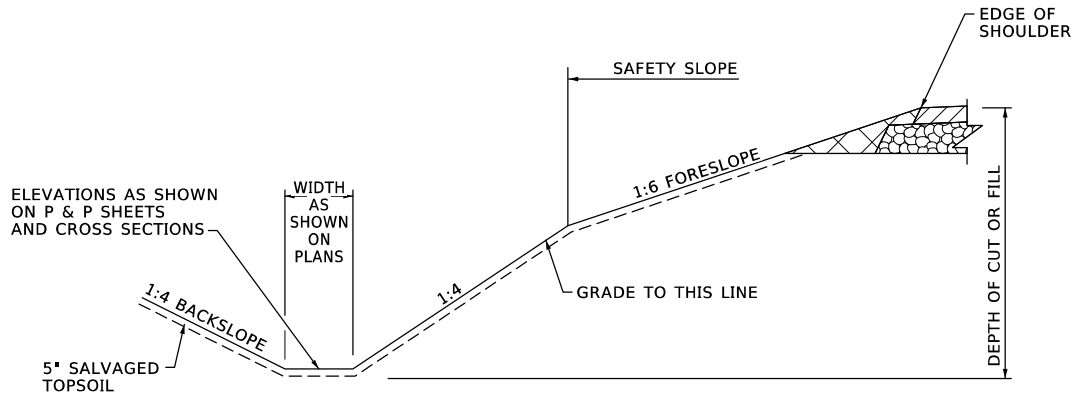


SPECIAL ROADWAY DITCH  
(FILL)

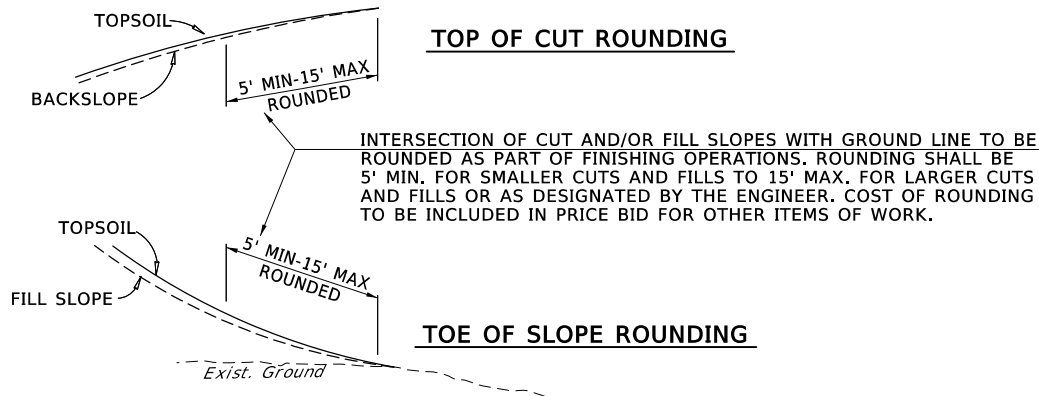



ROUNDING DETAIL  
N.T.S.

DESIGN			OKLAHOMA DEPARTMENT OF TRANSPORTATION				
DRAWN			MISCELLANEOUS DETAILS				
CHECKED							
APPROVED							
SQUAD							
COUNTY	OTTAWA	HIGHWAY	US-60	STATE JOB NO.	24273(04)	SHEET NO.	4



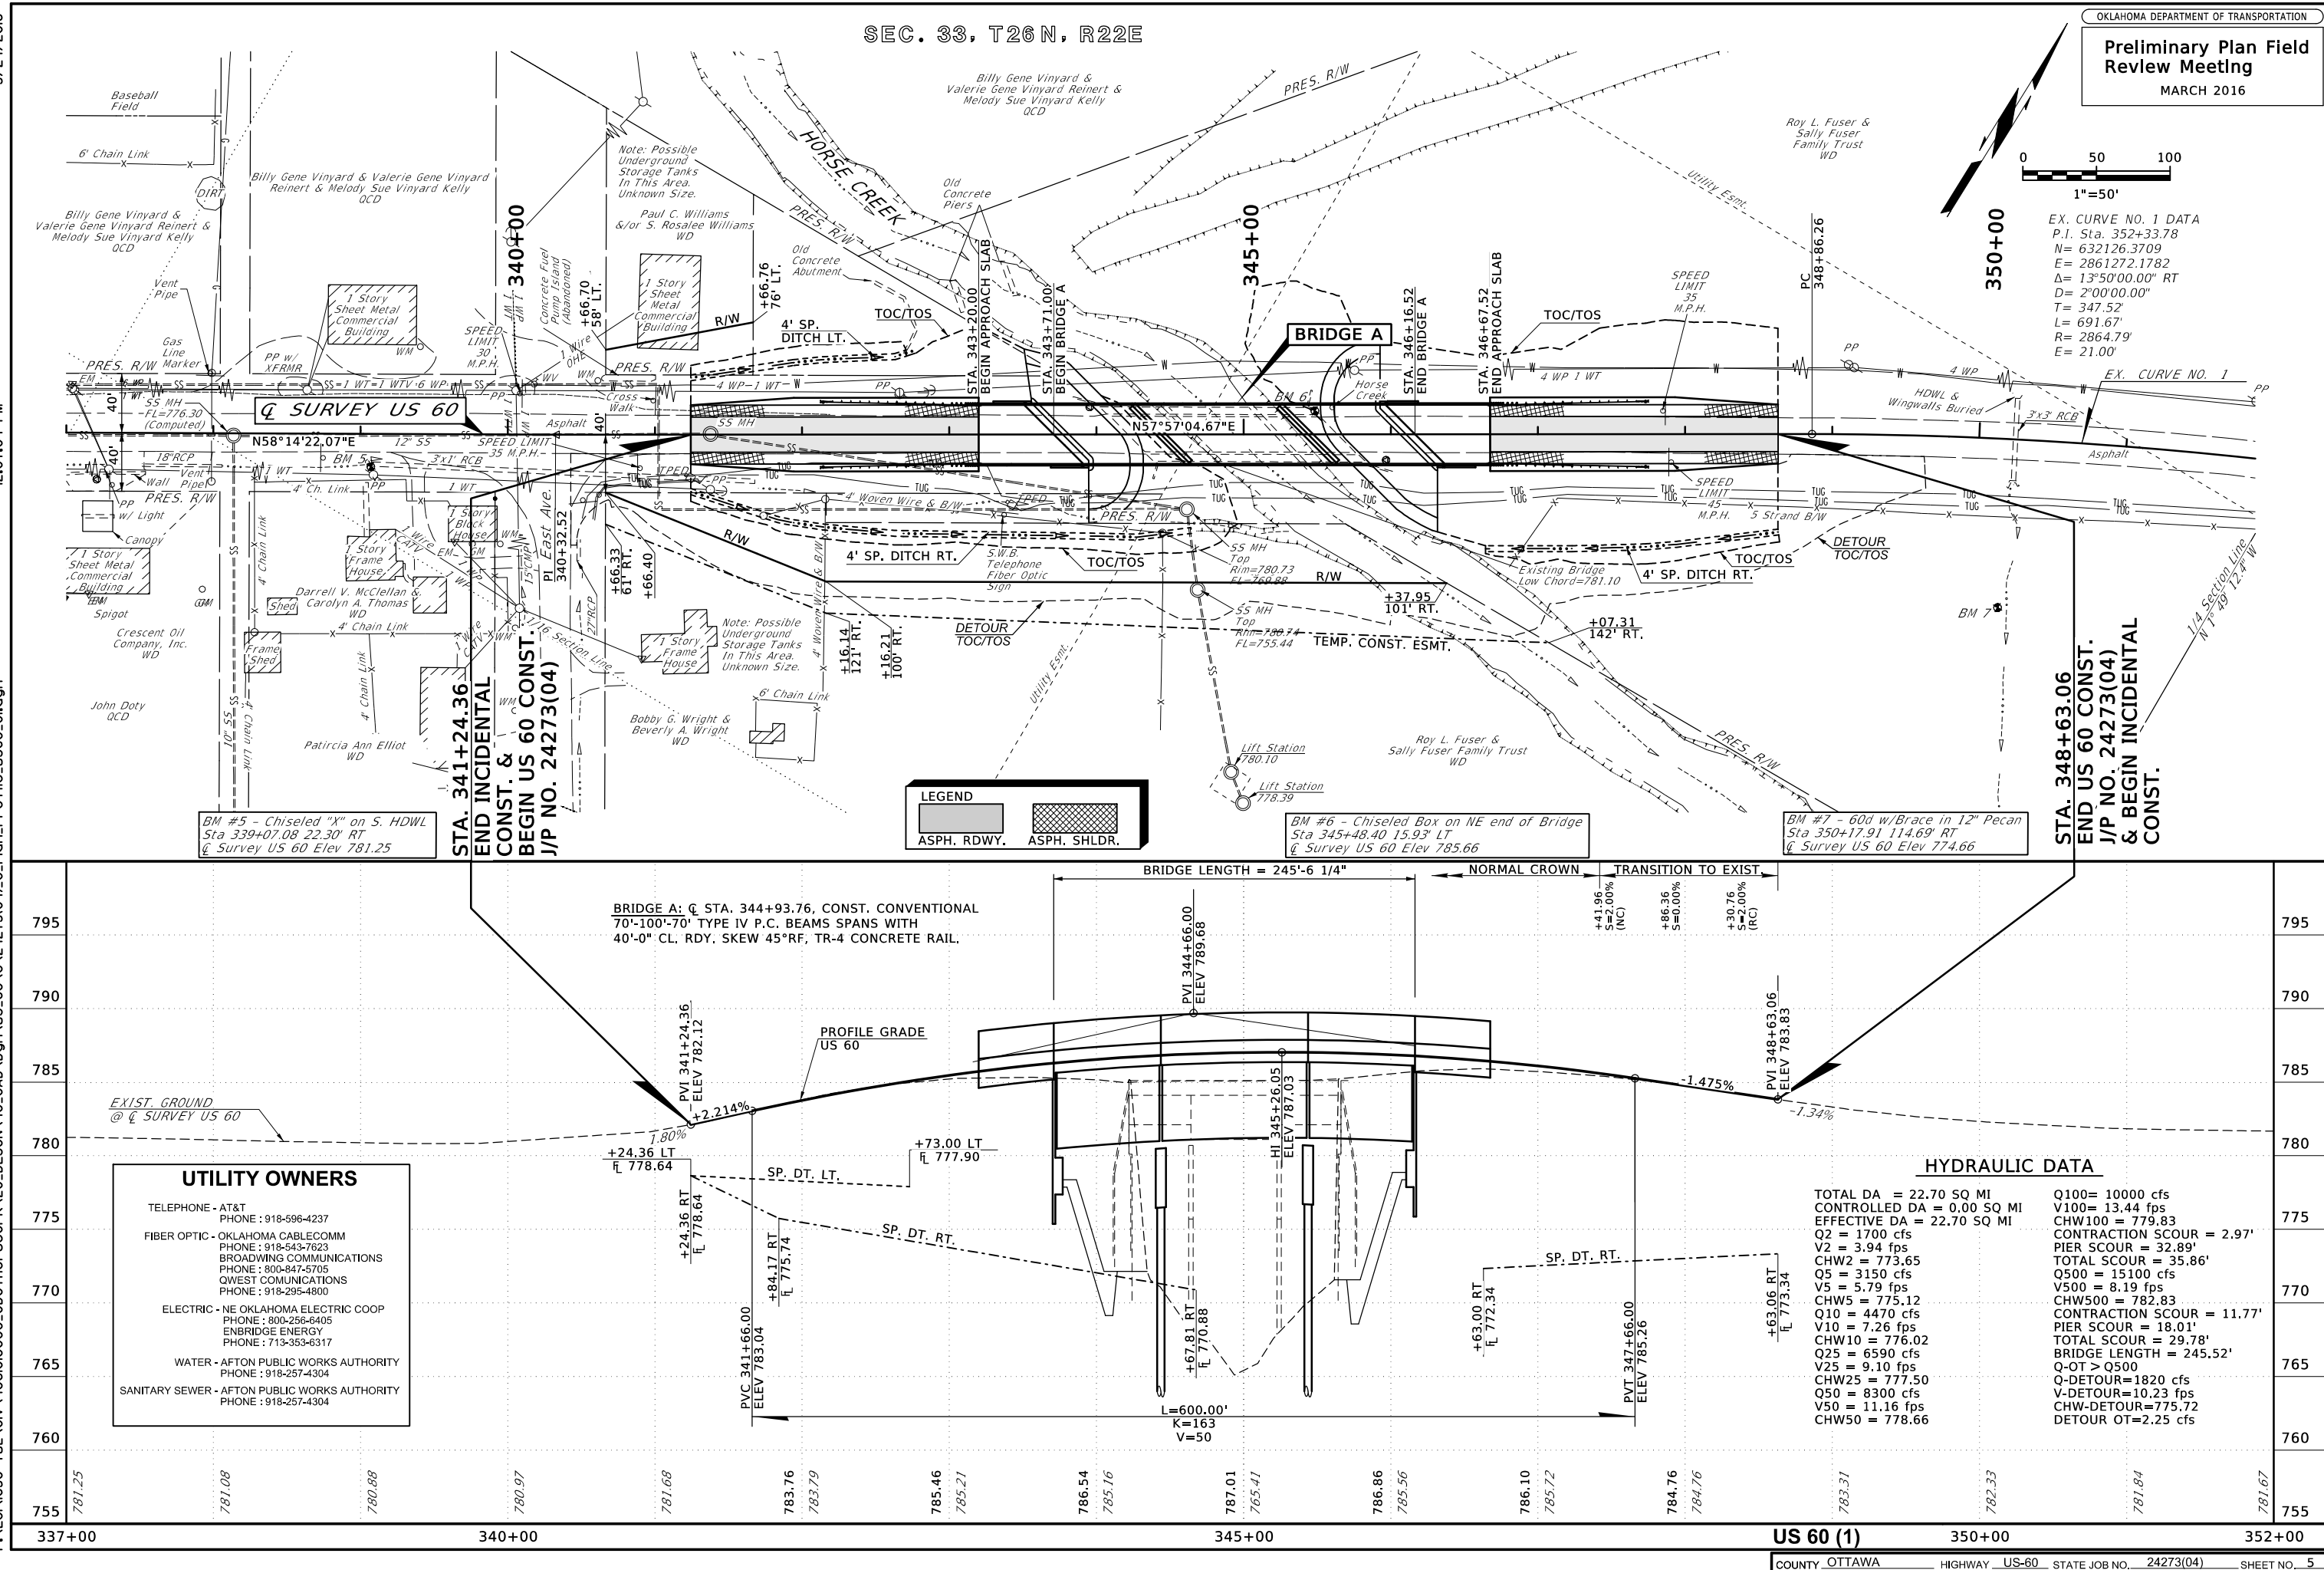


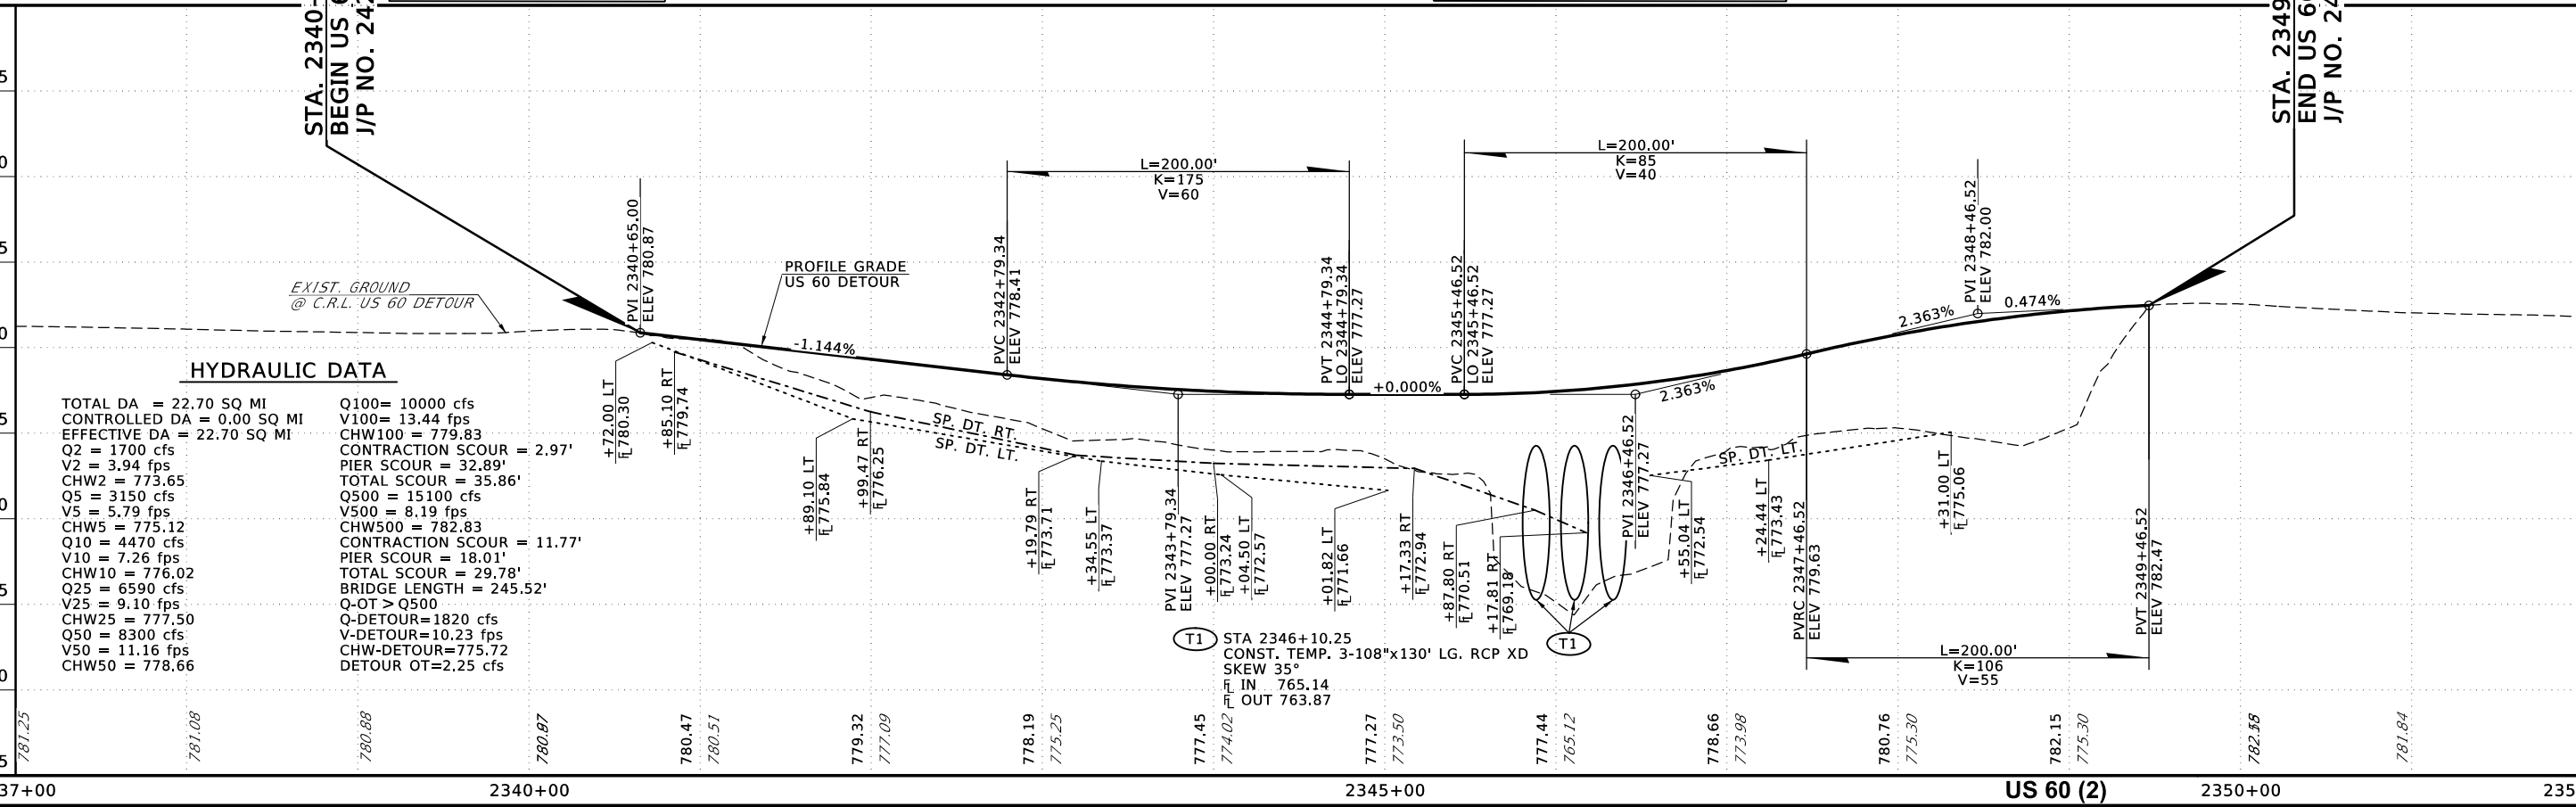

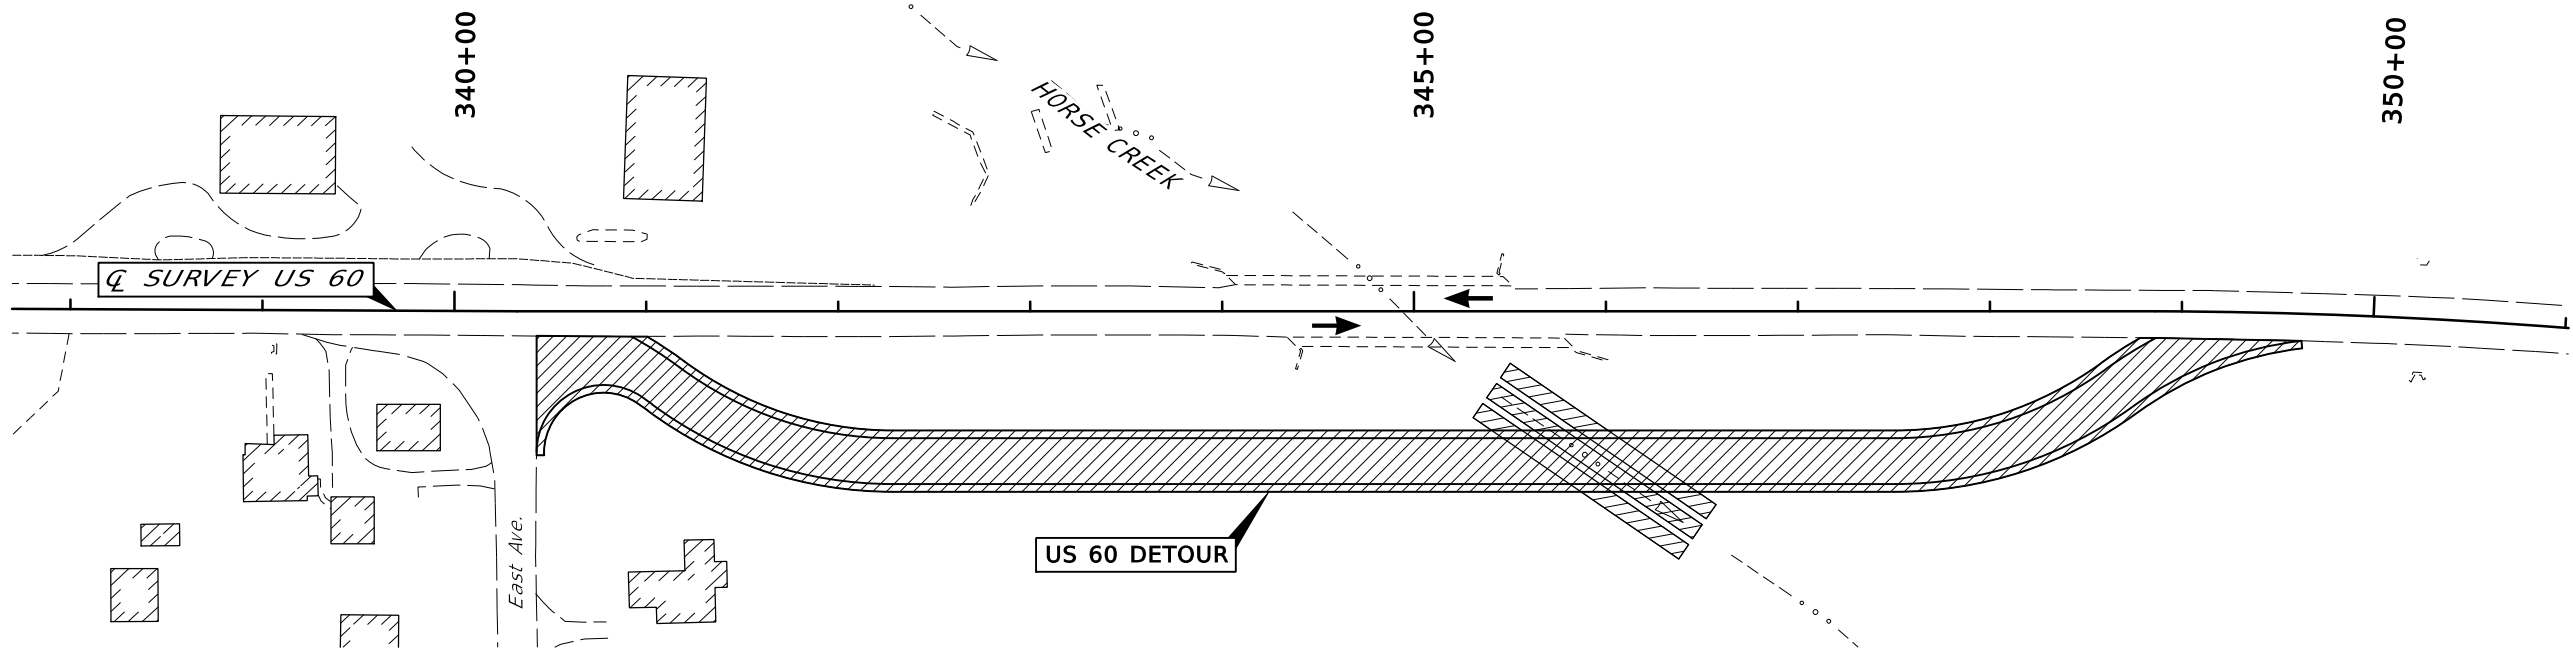

PHASE 1

PHASE 1		
ITEM	CONSTRUCTION	TRAFFIC
US 60	No construction	On existing US 60
Detour	Construct	
Bridge A	No construction	

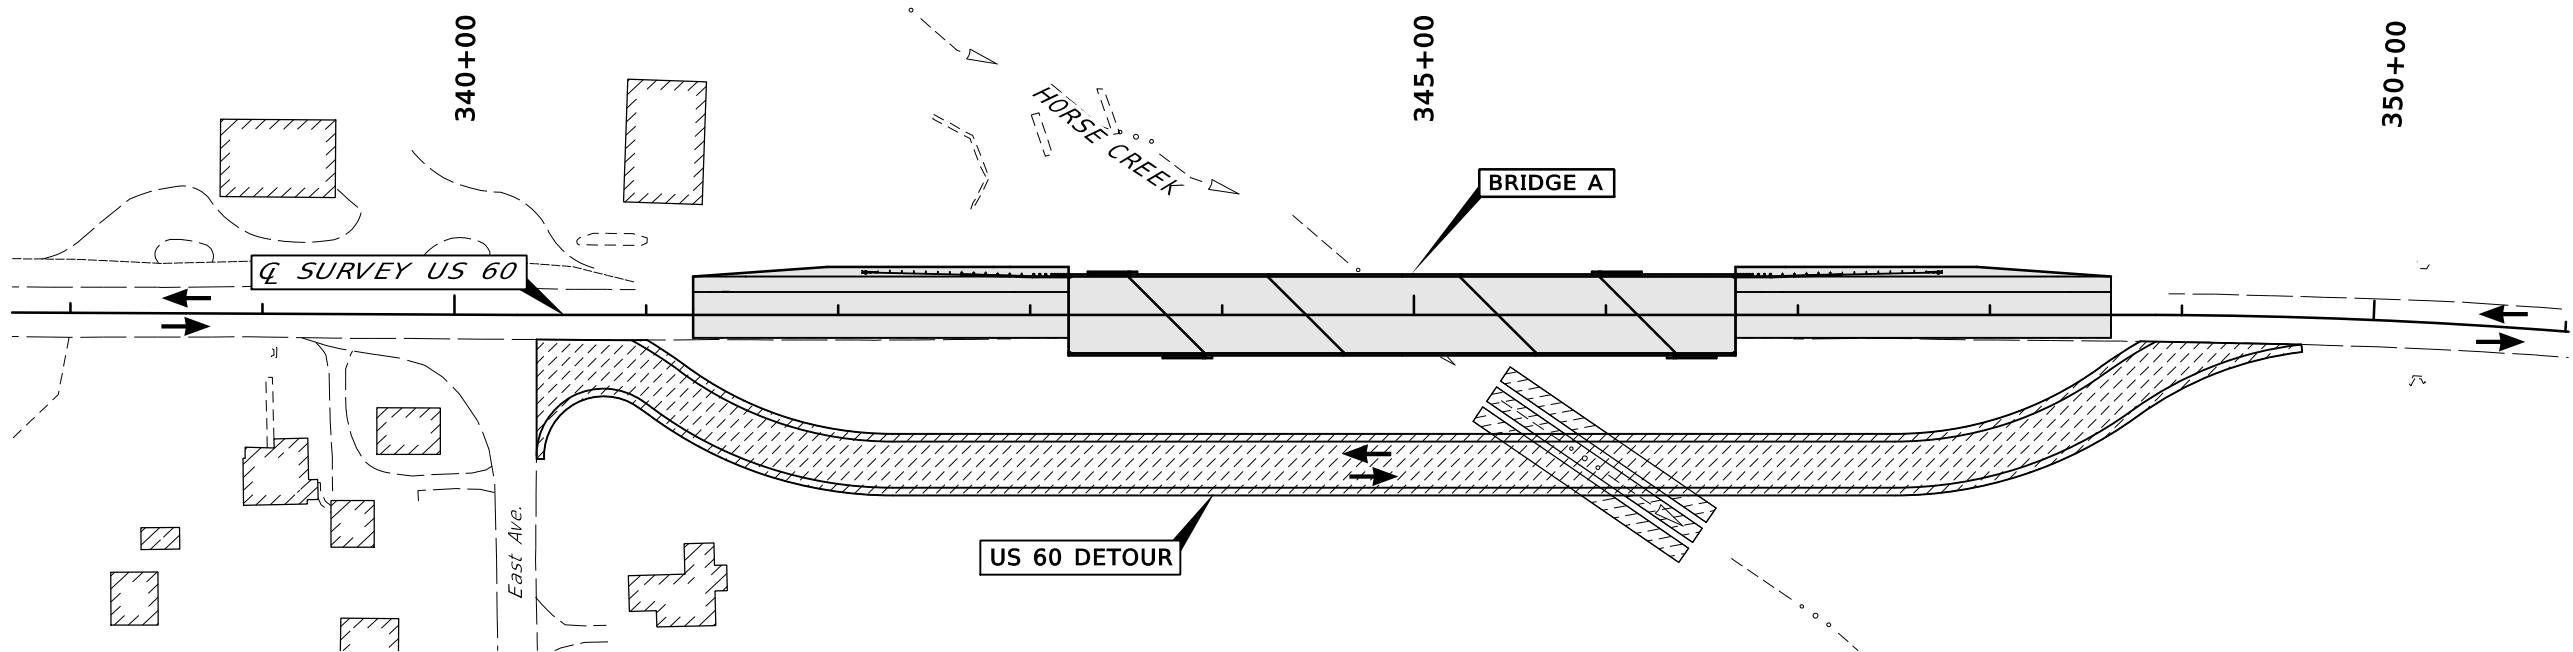

PHASE 2

PHASE 2		
ITEM	CONSTRUCTION	TRAFFIC
US 60	Sta. 341+24.36 to Sta. 348+63.06 except south shoulder, guardrail widening and foreslope	On Detour, existing US 60
Detour	No construction	
Bridge A	Construct	


LEGEND

- CONSTRUCTION
- TEMPORARY CONSTRUCTION
- COMPLETED CONSTRUCTION
- COMPLETED TEMPORARY CONSTRUCTION
- TEMPORARY CONSTRUCTION REMOVAL

DESIGN		OKLAHOMA DEPARTMENT OF TRANSPORTATION	
DRAWN			
CHECKED			
APPROVED			
SQUAD			
COUNTY - OTTAWA		HIGHWAY - US-60	
		STATE JOB NO. - 24273(04)	
		SHEET NO. - 7	

SUGGESTED CONSTRUCTION  
SEQUENCE (1)



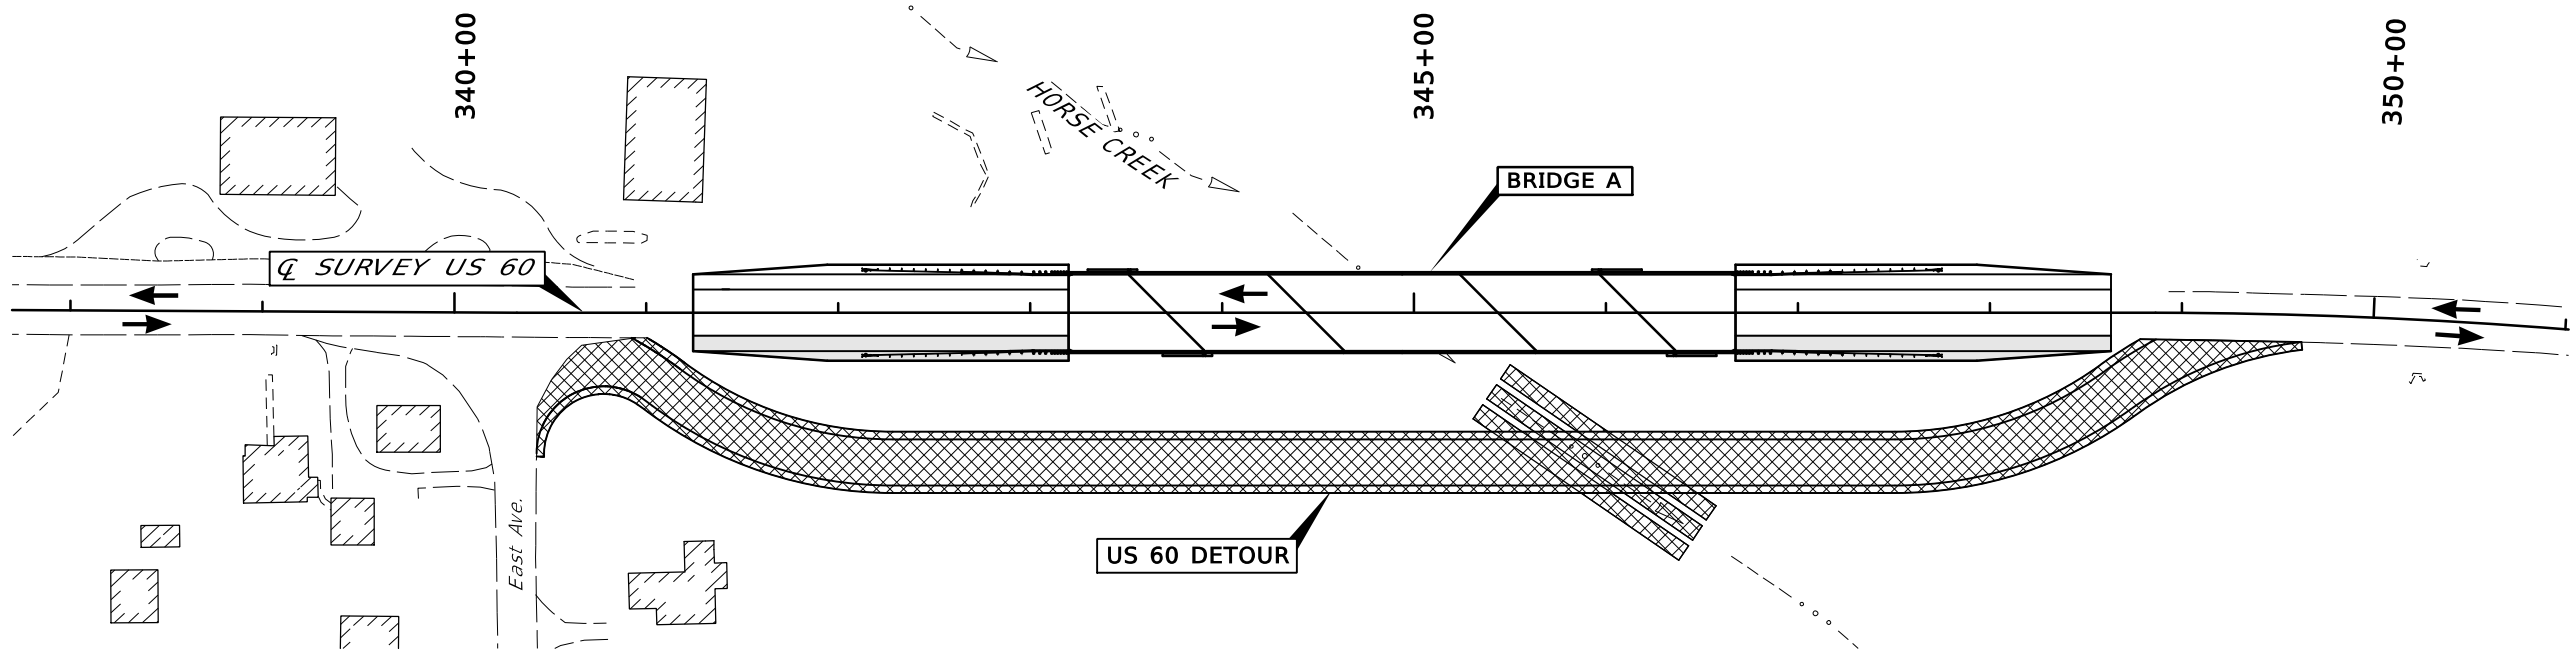






PHASE 3

PHASE 3		
ITEM	CONSTRUCTION	TRAFFIC
US 60	Construct South shoulder, guardrail widening and foreslope	On proposed US 60
Detour	Remove	
Bridge A	No construction	

LEGEND

	CONSTRUCTION
	TEMPORARY CONSTRUCTION
	COMPLETED CONSTRUCTION
	COMPLETED TEMPORARY CONSTRUCTION
	TEMPORARY CONSTRUCTION REMOVAL

DESIGN		OKLAHOMA DEPARTMENT OF TRANSPORTATION	
DRAWN			
CHECKED			
APPROVED			
SQUAD			
COUNTY - OTTAWA		HIGHWAY - US-60	
		STATE JOB NO. - 24273(04)	
		SHEET NO. - 8	

SUGGESTED CONSTRUCTION  
SEQUENCE (2)

3/24/2016  
12:07:42 PM  
P:\NEC1\650-TUL\CV\106100000\_000THORSECRK\20\_DESIGN\40\_CAD\NDR\US\_60\US\_60\24273(04)\_S\_Gen\_Plan\_Elev\_Br\_A\_01.dgn

OKLAHOMA DEPARTMENT OF TRANSPORTATION

Preliminary Plan Field  
Review Meeting

MARCH 2016

DESIGN DATA

**LOADING:** HL-93 OR OKLAHOMA OVERLOAD TRUCK  
20 PSF FUTURE WEARING SURFACE.  
LRFR OPERATING RATING = XX.X

**DESIGN:** AASHTO LRFD BRIDGE DESIGN SPECIFICATIONS 7TH EDITION,  
EXCEPT FOR BEARING PADS WHICH  
SATISFY AASHTO STANDARD SPECIFICATIONS FOR HIGHWAY  
BRIDGES, 16TH EDITION WITH 1996 INTERIMS, USING HL-93  
LIVE LOADING.

**MATERIAL:** CONCRETE:  
CLASS AA  $f'_c = 4,000$  PSI  
CLASS A  $f'_c = 3,000$  PSI  
REINFORCING STEEL:  
STRUCTURAL STEEL:  $F_y = 60,000$  PSI  
M270 (GRADE 50W)  $F_y = 36,000$  PSI  
 $F_u = 50,000$  PSI

FOUNDATION DATA

ABUTMENTS (HP 12X53 PILING)


FACTORED PILE REACTION = XX.X TONS/PILE  
THE LENGTH OF STEEL PILING SHOWN ON THE PLANS IS  
FOR ESTIMATING PURPOSES ONLY.

PIERS 1 AND 2 (XX" DRILLED SHAFTS)

MAX. FACTORED LOAD = XXX T/SHAFT  
FACTORED FRICTION RESISTANCE (9 TSF) = XXX T/SHAFT  
FACTORED BEARING RESISTANCE (60 TSF) = XXX T/SHAFT  
TOTAL FACTORED RESISTANCE = XXXX T/SHAFT  
BEARING RESISTANCE FACTOR = X.X  
FRICTION RESISTANCE FACTOR = X.XX  
FRICTION DEPTH OF ROCK NEGLECTED (FEET) = X

HYDRAULIC DATA


TOTAL DA = 22.70 SQ MI  
CONTROLLED DA = 0.00 SQ MI  
EFFECTIVE DA = 22.70 SQ MI  
Q2 = 1700 cfs  
V2 = 3.94 fps  
CHW2 = 773.65  
Q5 = 3150 cfs  
V5 = 5.79 fps  
CHW5 = 775.12  
Q10 = 4470 cfs  
V10 = 7.26 fps  
CHW10 = 776.02  
Q25 = 6590 cfs  
V25 = 9.10 fps  
CHW25 = 777.50  
Q50 = 8300 cfs  
V50 = 11.16 fps  
CHW50 = 778.66  
Q100 = 10000 cfs  
V100 = 13.44 fps  
CHW100 = 779.83  
Q500 = 15100 cfs  
V500 = 8.19 fps  
CHW500 = 782.83  
BRIDGE LENGTH = 245.52'  
Q-OT > Q500  
Q-DETOUR=1820 cfs  
V-DETOUR=10.23 fps  
CHW-DETOUR=775.72  
DETOUR OT=2.25 cfs

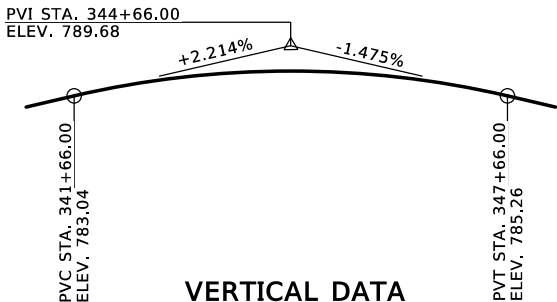

VERTICAL DATA


TO BE REMOVED EXISTING BRIDGE  $\bar{C}$  STA. 344+92.85  
42'-60'-42' I BEAM SPANS  
24' RDY. & 2'-5.1' SIDEWALKS SKEW 44°30'00"

DESIGN	KSJ	01/16	OKLAHOMA DEPARTMENT OF TRANSPORTATION	
DRAWN	WZB	01/16	US 60 OVER HORSE CREEK BRIDGE "A"	
CHECKED	STF	01/16	GENERAL PLAN AND ELEVATION	
APPROVED	SAK	01/16	CONSTRUCT NEW 70'X100'X70' TYPE IV P.C. BEAM SPANS WITH CONCRETE RAIL (TR-4) WITH 40' CLEAR ROADWAY AT $\bar{C}$ US 60 SURVEY STA. 344+93.76	
SQUAD	LEIDOS			
COUNTY	OTTAWA		HIGHWAY	US-60
STATE JOB NO.	24273(04)			
SHEET NO.	9			

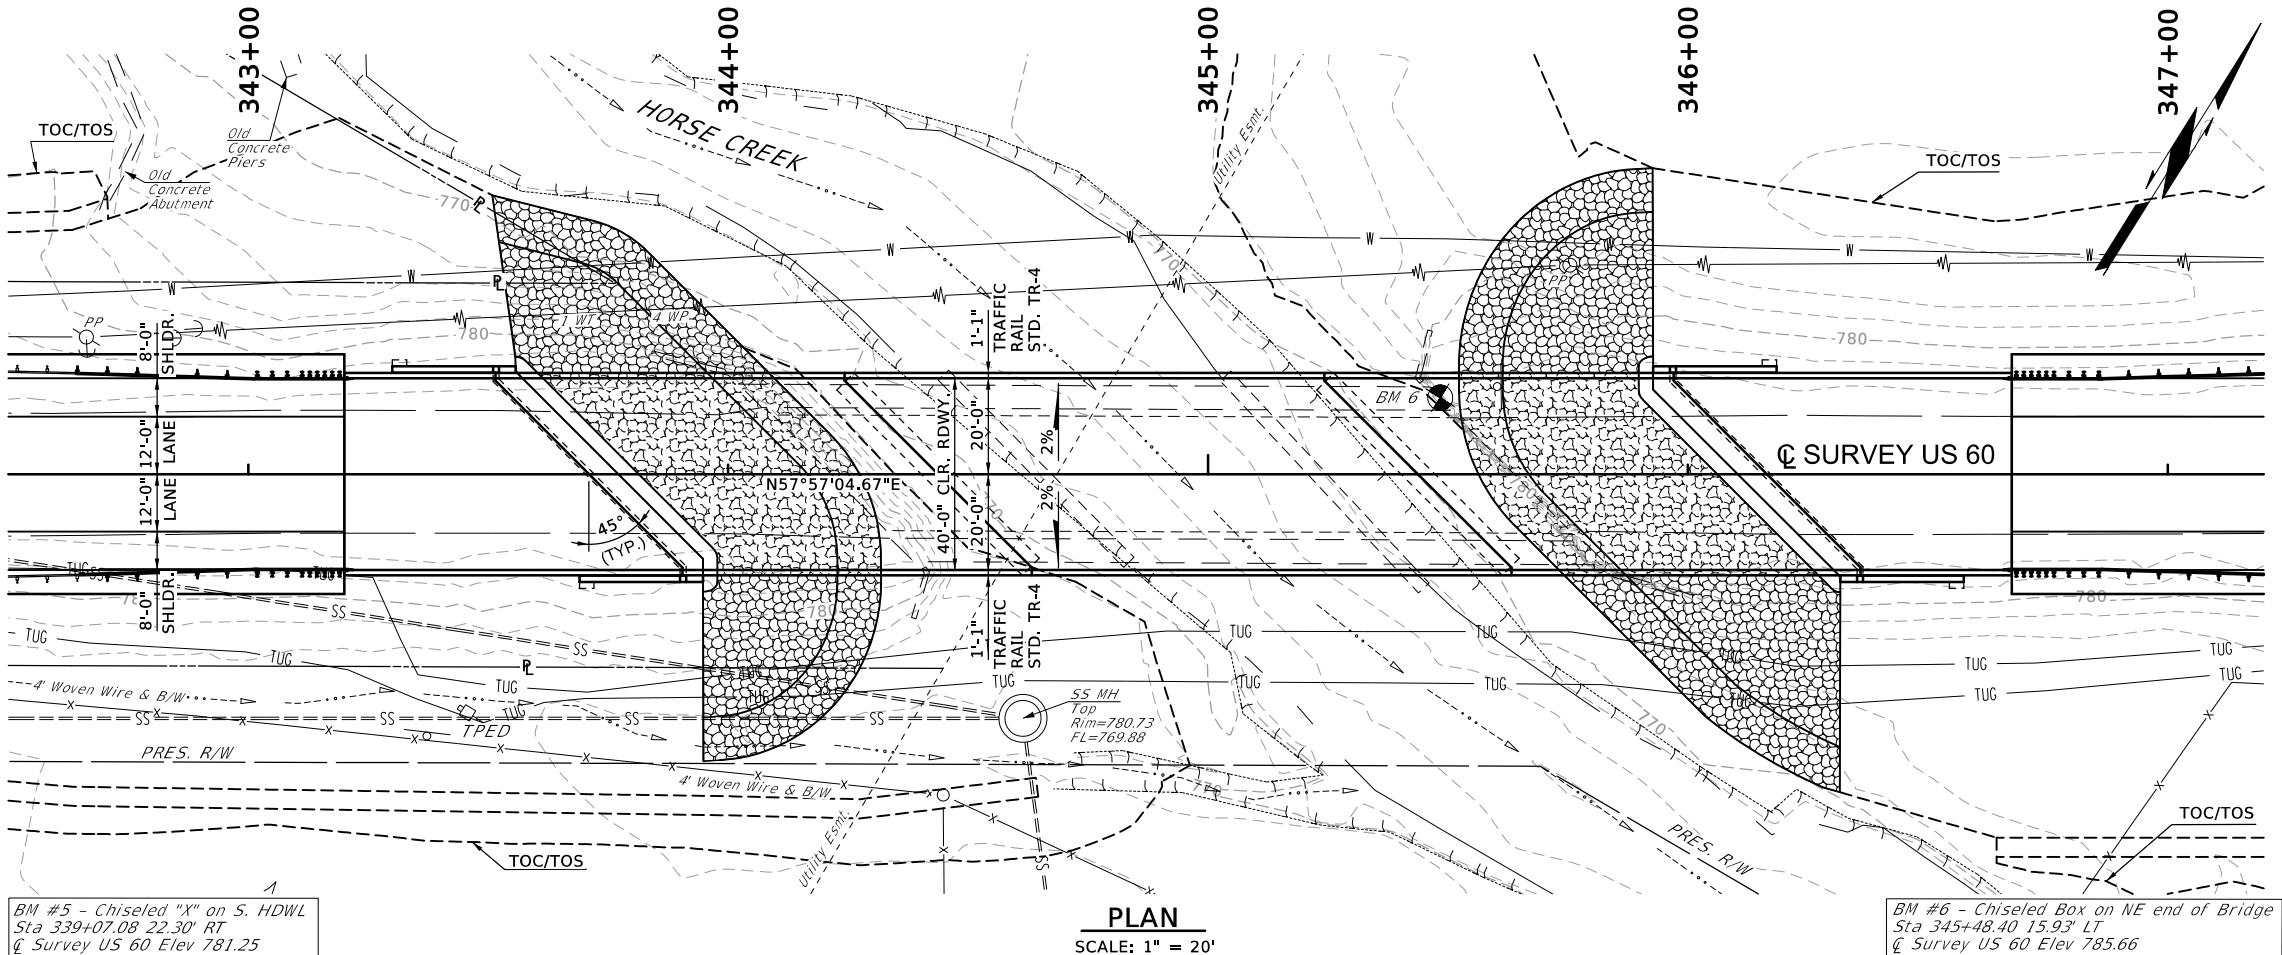

PLAN


SCALE: 1" = 20'

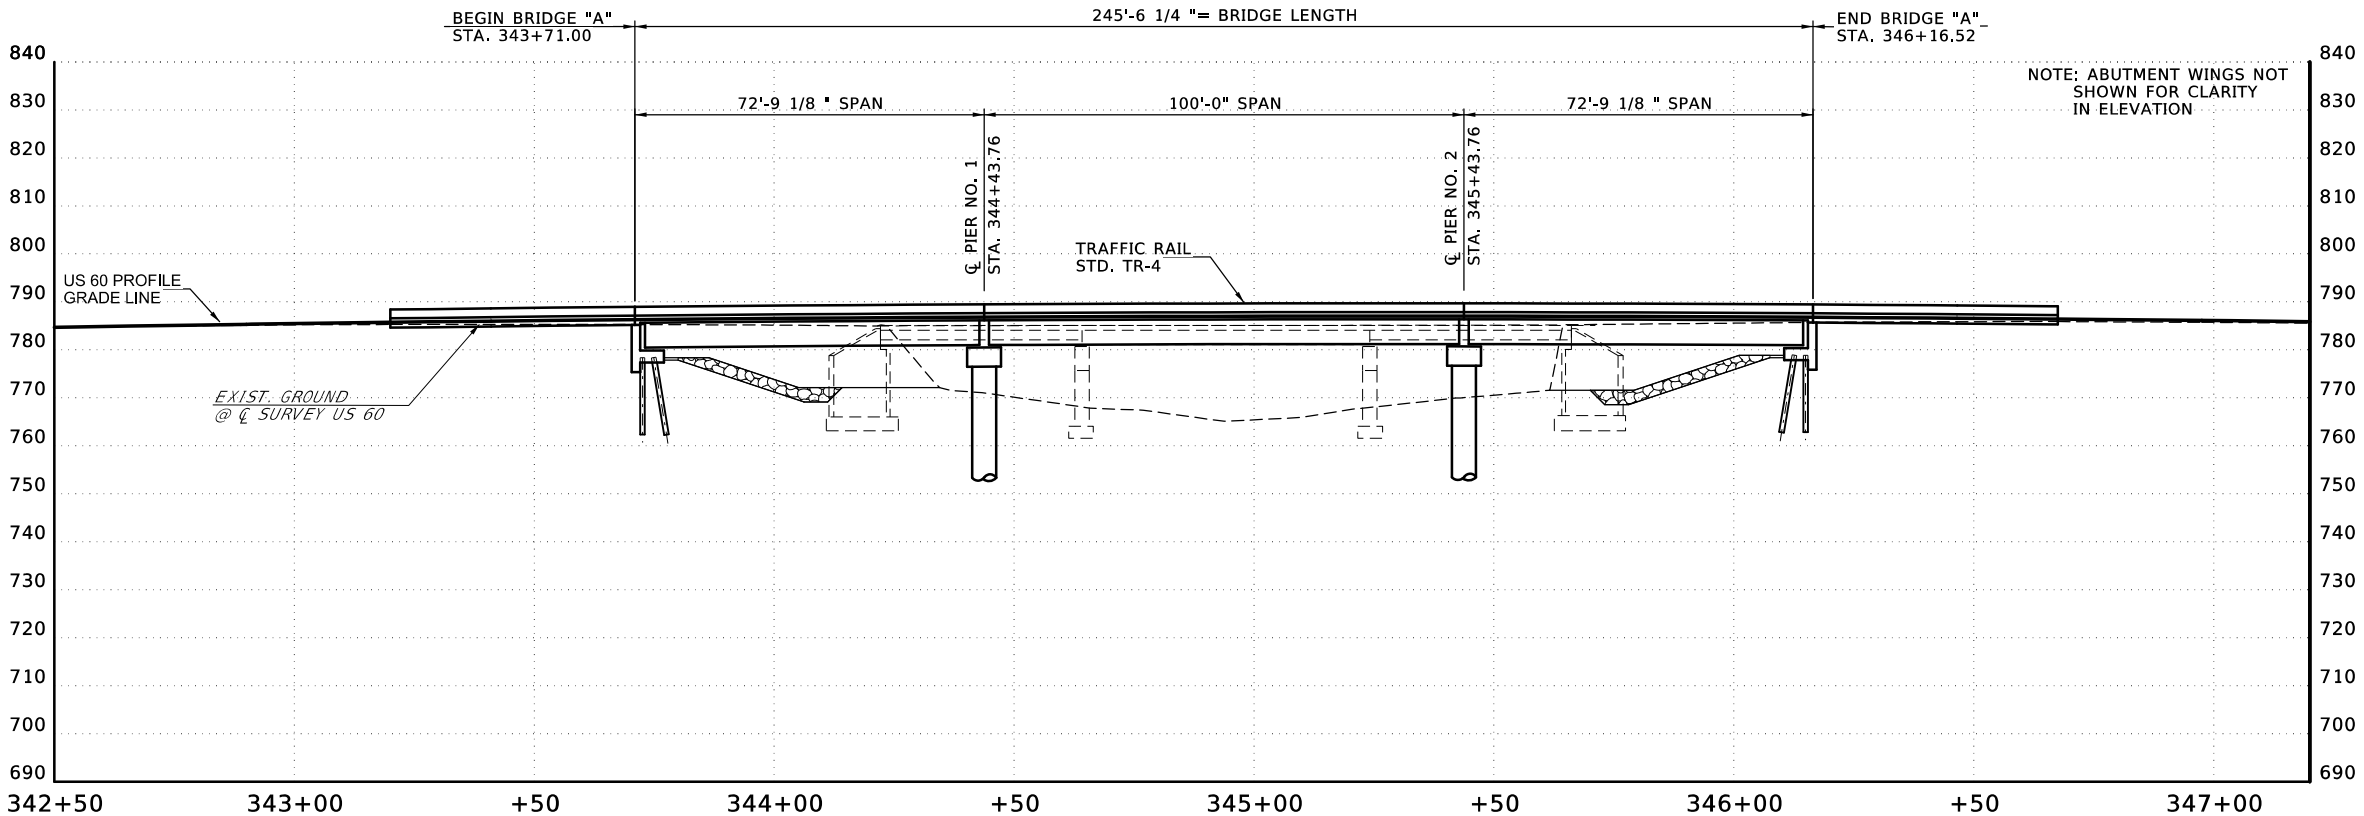

ELEVATION

SCALE HORIZ. 1" = 20'  
VERT. 1" = 20'


3/24/2016 12:44 PM P:\ECI\650-TUL\CVV\1061010000\_0010HorseCrk\20\_DESIGN\40\_CAD\Drawings\US\_60\24273(04)\_S\_Typ\_Sec\_01.dgn

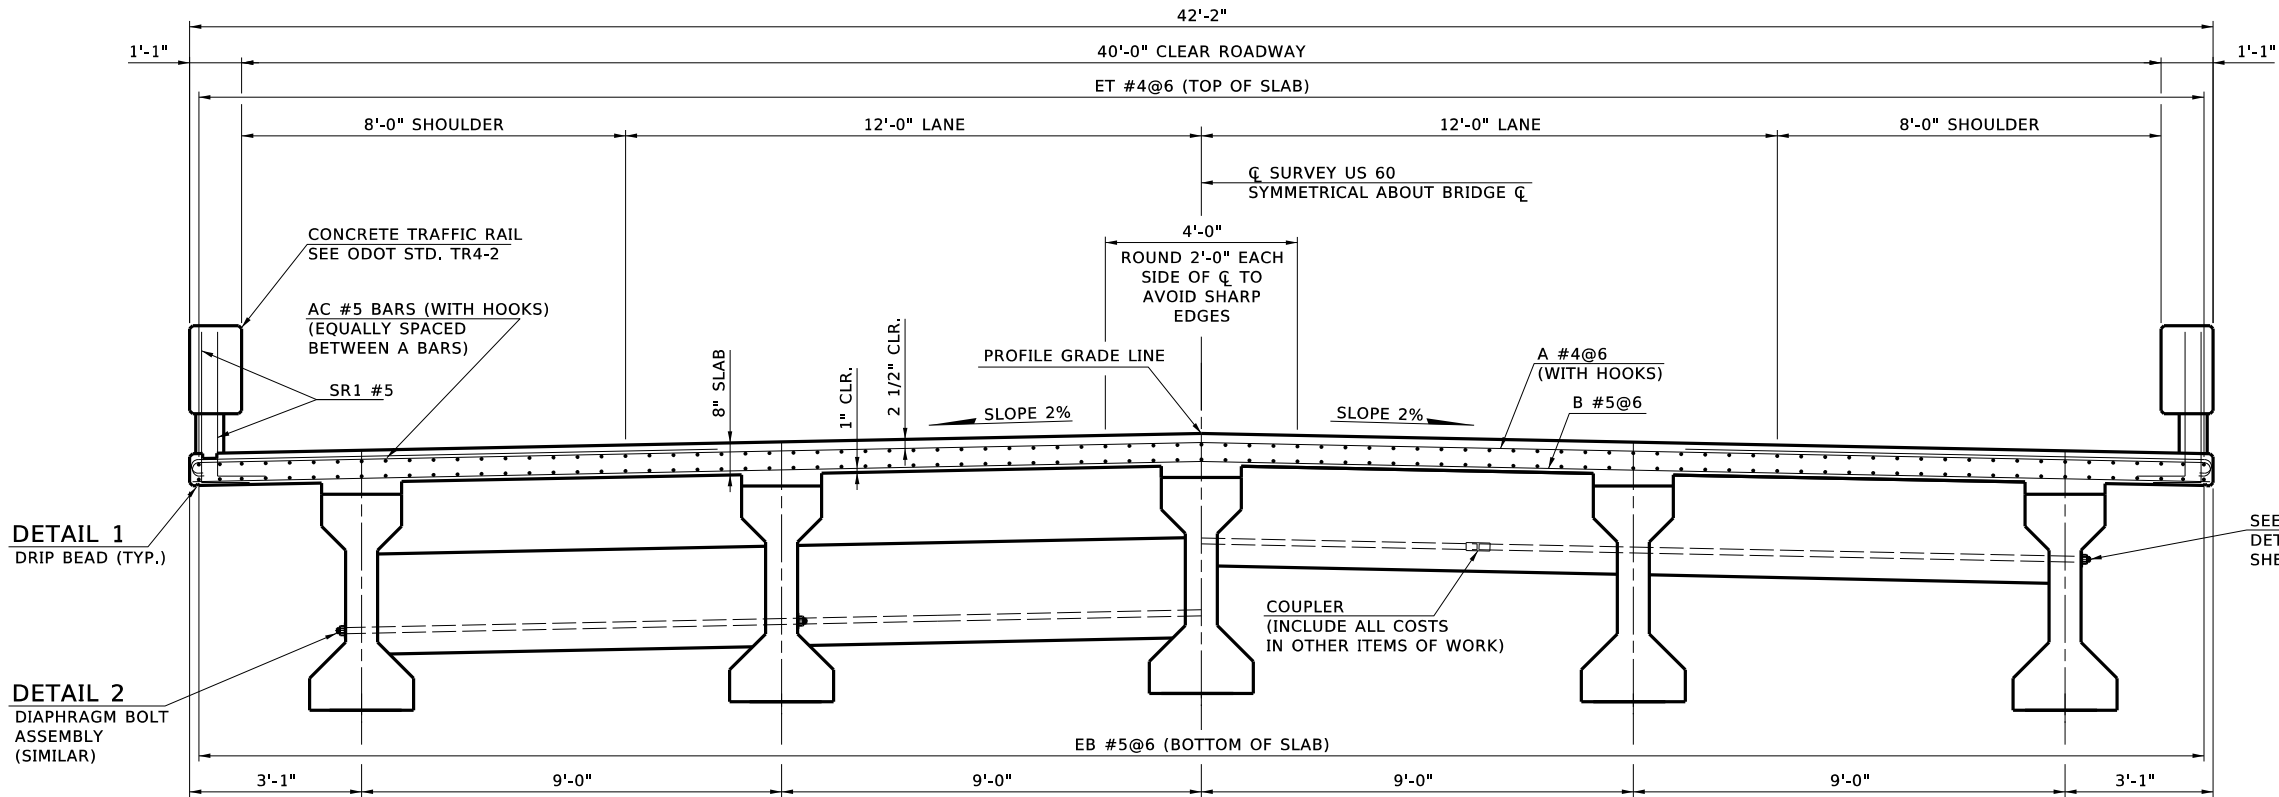

HALF SECTION AT INTERMEDIATE DIAPHRAGMS


HALF SECTION AT END DIAPHRAGMS

TYPICAL SECTION THRU STRUCTURE

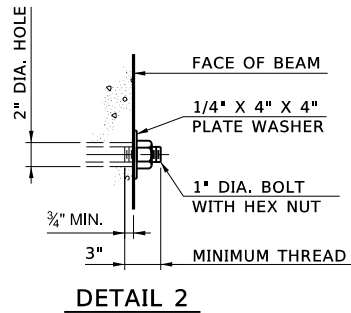



DIAPHRAGM BOLT NOTES

- STRUCTURAL STEEL FOR DIAPHRAGM BOLTS AND PLATE WASHERS SHALL CONFORM TO AASHTO M270 (ASTM A709) GRADE 50W (WEATHERING STEEL, CHARPY V-NOTCH TESTING NOT REQUIRED). A #10 REINFORCING BAR CONFORMING TO AASHTO M31, GRADE 60, AND THREADED AT THE ENDS AS SHOWN MAY BE SUBSTITUTED FOR THE DIAPHRAGM BOLTS, AT NO ADDITIONAL COST TO THE DEPT. HEX NUTS SHALL CONFORM TO AASHTO M291 (ASTM A563).
- PAINT EXPOSED DIAPHRAGM BOLT, PLATE WASHER AND HEX NUT WITH TWO (2) COATS OF ZINC-RICH PAINT (6 MIL MINIMUM THICKNESS) AFTER ASSEMBLY. ALL COST OF DIAPHRAGM BOLT, PLATE WASHER AND HEX NUT TO BE INCLUDED IN CONTRACT UNIT PRICE FOR STRUCTURAL STEEL.

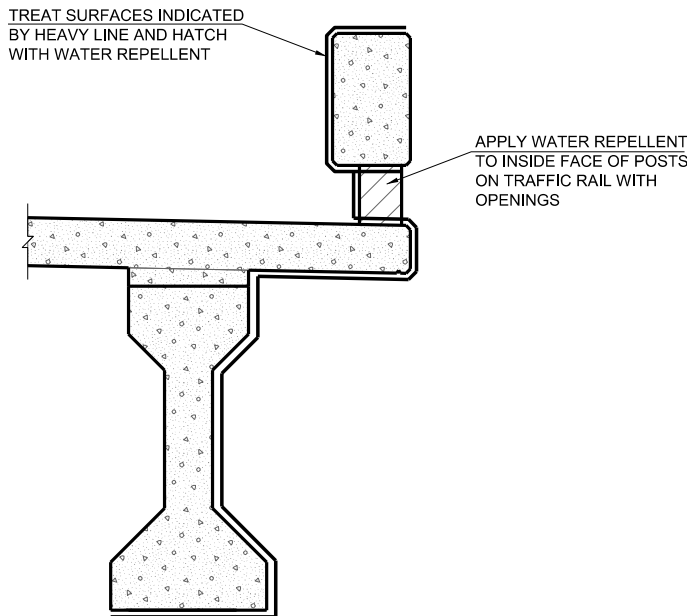

WATER REPELLENT TREATMENT DETAIL

SCALE: 1/2" = 1'-0"

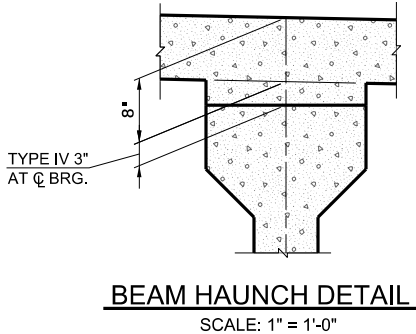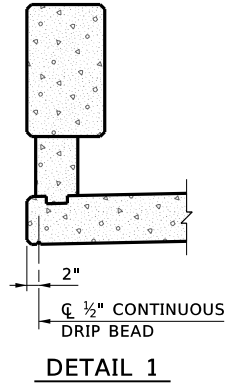

NOTE:  
PLAN QUANTITIES FOR CLASS AA CONCRETE INCLUDE BEAM HAUNCHES. THE HAUNCH HEIGHT SHOWN IS THE THEORETICAL HAUNCH HEIGHT AT THE CENTERLINE BEARING ONLY, MEASURED FROM THE BOTTOM OF THE DECK SLAB TO THE TOP OF THE BEAM, AND VARIES ACROSS THE SPAN. DETERMINE THE ACTUAL HAUNCH HEIGHT (ACCOUNTING FOR BEAM CAMBER, DEAD LOAD DEFLECTION AND ROADWAY GRADE) AFTER ERECTION OF THE BEAMS AND SUBMIT TO THE ENGINEER FOR APPROVAL. THE ENGINEER WILL NOT MEASURE DIFFERENCES BETWEEN THE THEORETICAL AND THE ACTUAL HAUNCH HEIGHT FOR PAYMENT.

DESIGN	KSJ	01/16	OKLAHOMA DEPARTMENT OF TRANSPORTATION	
DRAWN	JT	01/16	US 60 OVER HORSE CREEK	
CHECKED	STF	01/16	BRIDGE "A"	
APPROVED	SAK	01/16	TYPICAL SECTION	
SQUAD	LEIDOS			
COUNTY	OTTAWA	HIGHWAY	US-60	STATE JOB NO. 24273(04) SHEET NO. 10